


• FIRST FLOOR PLAN •
 1/8" = 1'-0"
 - All new walls are 4" thick

381439
 Received for Record this 14th day of Dec. 1989
 Recorded this 14th day of Dec. 1989 in Vol. 18
 Page 117.
 Catherine H. Heiden, Recorder

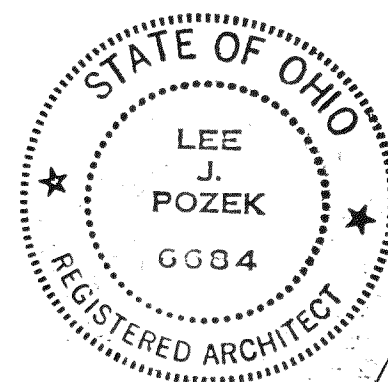

I do hereby certify this drawing shows graphically all particulars of the porch addition to Building No. 7A of Auburn Lakes Condominium including the layout, location, designation, and the dimensions of addition as constructed.

Lee J. Pozek
 Oct. 1989

AMENDMENT NUMBER 7A AUBURN LAKES CONDOMINIUM		
BUILDING # 19 FLOOR PLANS		
SCALE 1/8" = 1'-0"	Oct. 1989	Sheet B-7A-1
LEE J. POZEK, Architect 5020 Richmond Rd., Dedford Hgts., Ohio		

DRAWN
CHECKED
DATE Sept. 20, 1989
SCALE 1/8" = 1'-0"
JOB NO. 2236
SHEET

1.
OF SHEETS