


METRO MACHINE TOOL CO. VOL. 443 PG. 243

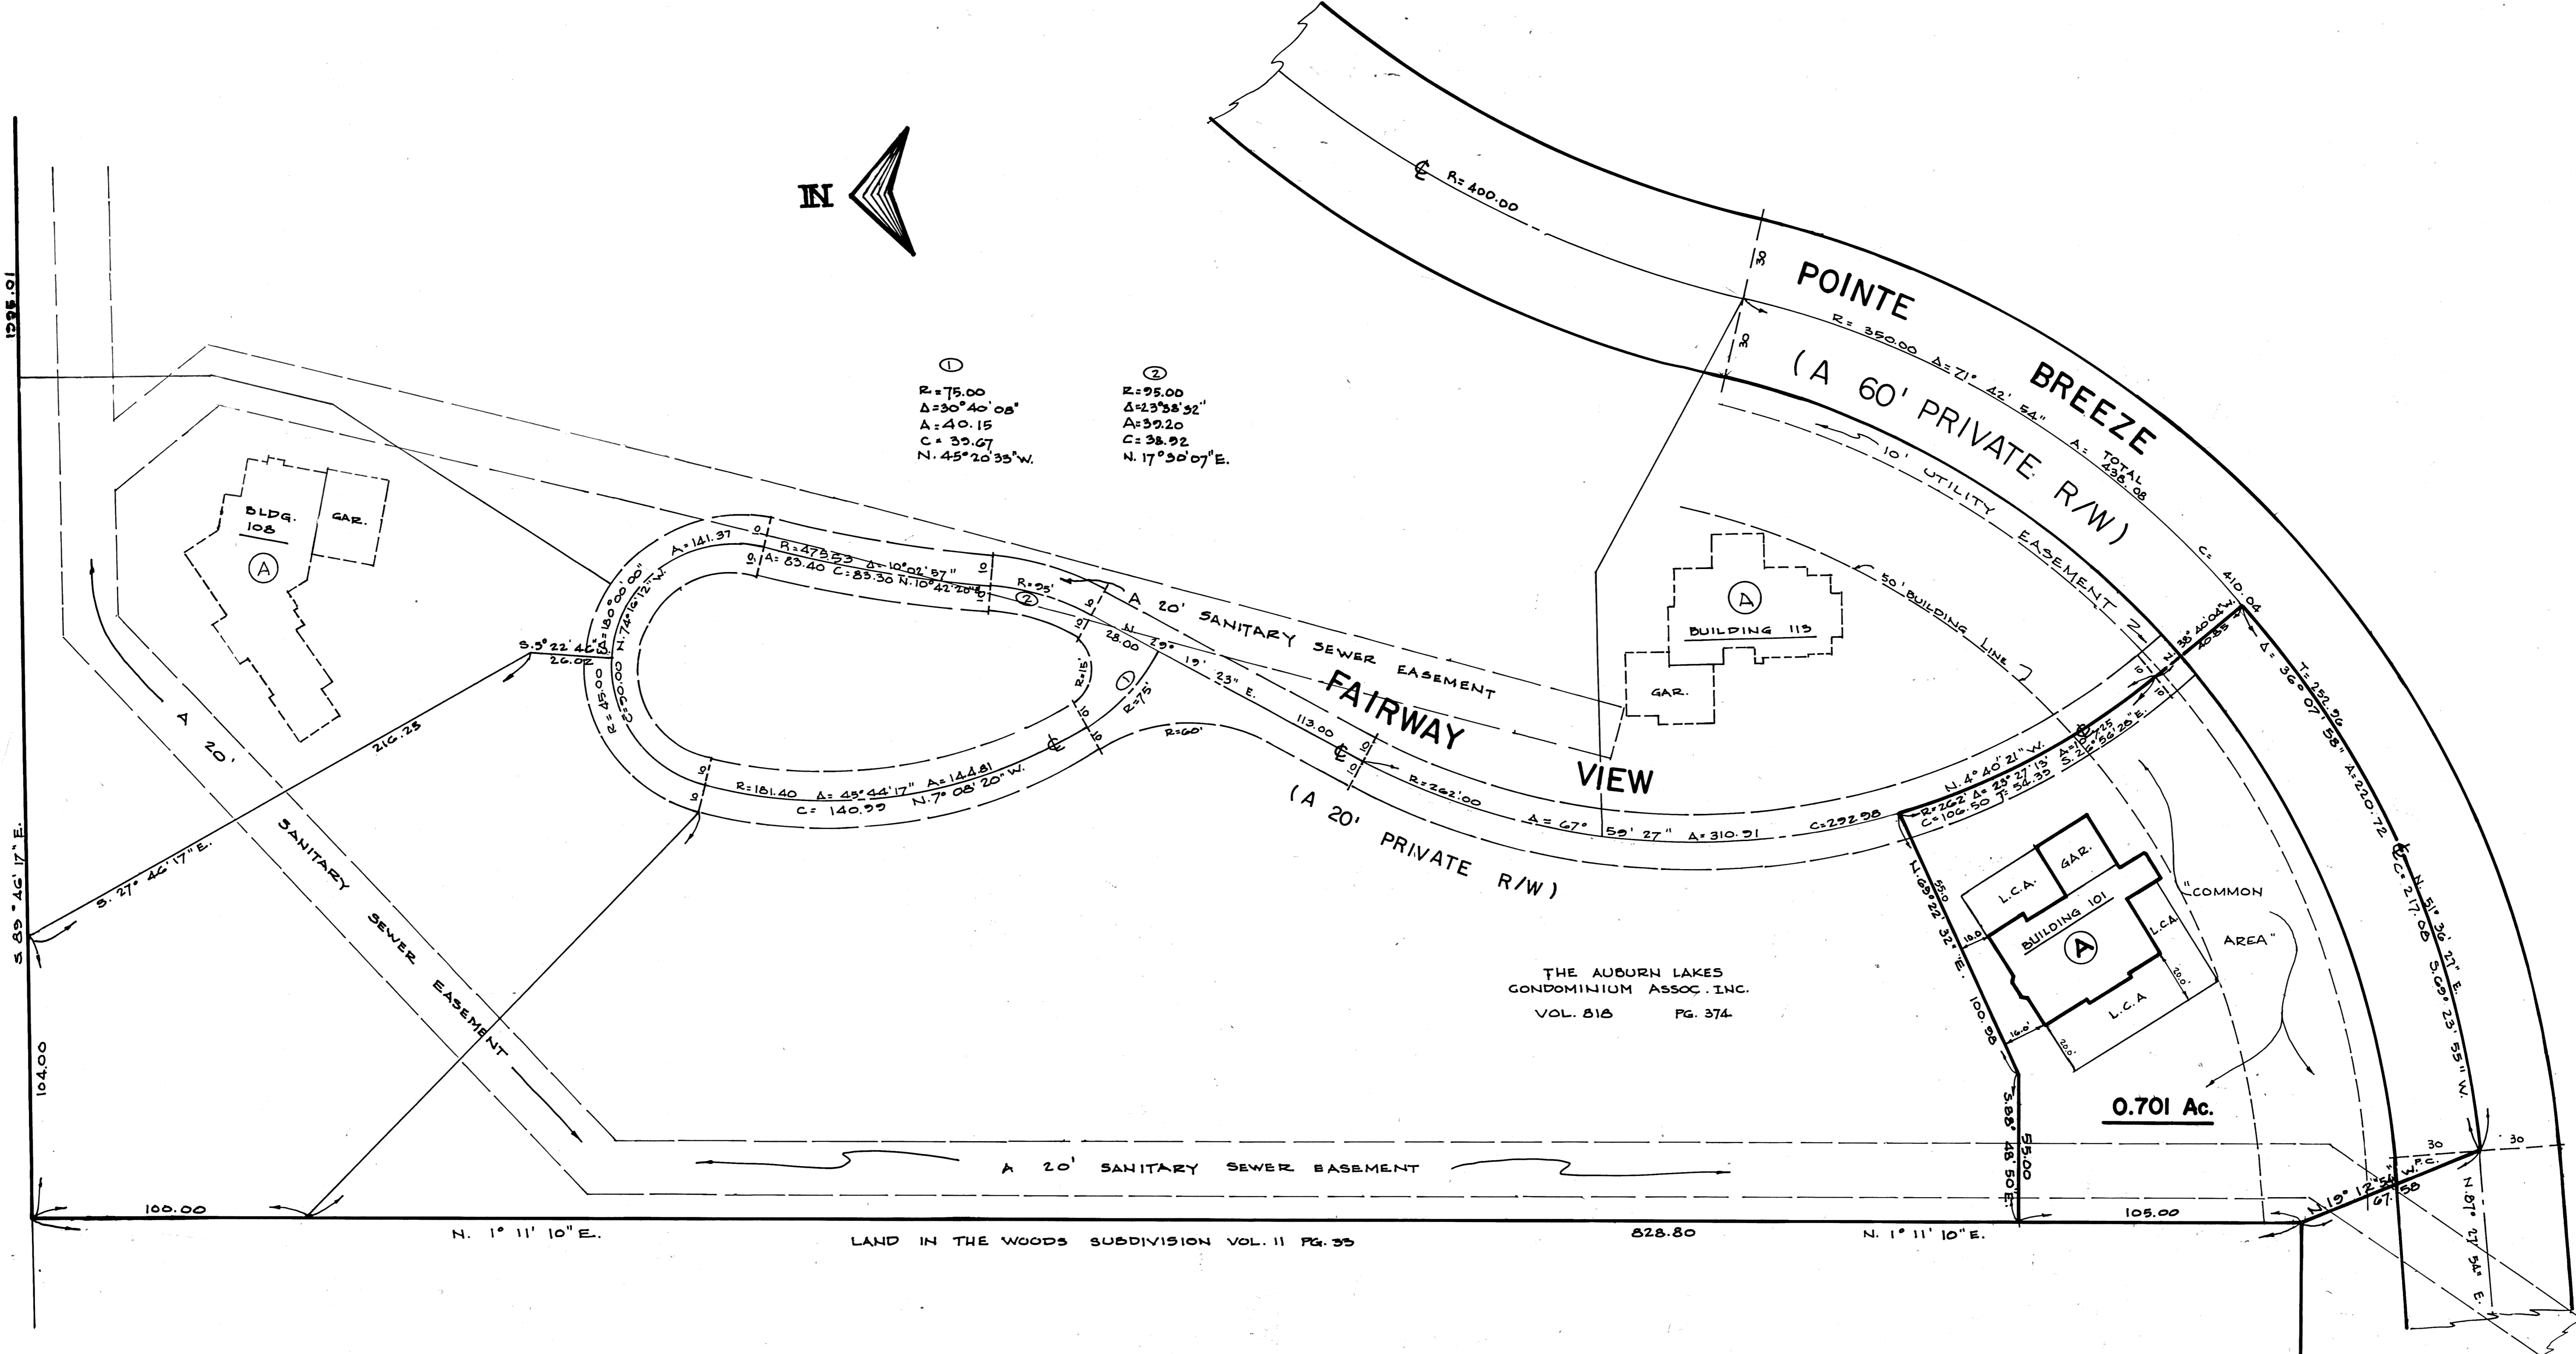

①
 R=75.00
 Δ=30°40'08"
 A=40.15
 C=39.67
 N.45°20'35"W.

②
 R=95.00
 Δ=23°38'32"
 A=59.20
 C=38.92
 N.17°30'07"E.

THE AUBURN LAKES
 CONDOMINIUM ASSOC. INC.
 VOL. 818 PG. 374

0.701 Ac.


NOTE: L.C.A. DENOTES "LIMITED COMMON AREA" FOR FIRST FLOOR ONLY
 ALL LAND NOT OCCUPIED BY BUILDINGS OR DESIGNATED AS "LIMITED COMMON AREA" IS "COMMON AREA"

AMENDMENT NUMBER 46
AUBURN LAKES CONDOMINIUM


SITUATED IN THE TOWNSHIP OF AUBURN, COUNTY OF GEauga AND STATE OF OHIO AND KNOWN AS BEING PART OF ORIGINAL AUBURN TOWNSHIP SECTION ONE, TRACT TWO, AND CONTAINING 0.701 ACRES OF LAND.

I DO HERBY STATE THE BUILDING OF AMENDMENT NUMBER 46, AUBURN LAKES CONDOMINIUM, ARE LOCATED AS SHOWN ON THIS DRAWING, CONSISTING OF SHEETS 1 & 2 AND THE ELEVATIONS ABOVE SEA LEVEL ARE CORRECT AND SAID DRAWINGS ACCURATELY SHOW THE BUILDING AS CONSTRUCTED TO THE BEST OF MY KNOWLEDGE AND BELIEF.


Ronald A. Nuske Nov. 3, 1992
 RONALD A. NUSKE REG. SURVEYOR # 5913

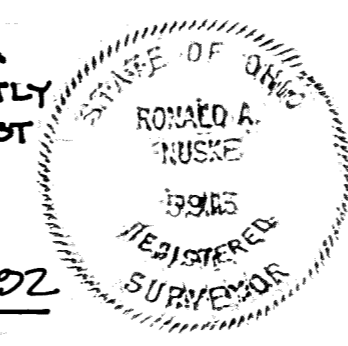

AMENDMENT NUMBER 46 AUBURN LAKES CONDOMINIUM	
BUILDING 101 LOCATION PLAT	
SCALE 1"=30'	NOV. 1992 SHEET 2 of 3
BRAUN-PRENOSIL ASSOC. INC. ENGINEERS - SURVEYORS Chagrin Falls, Ohio	

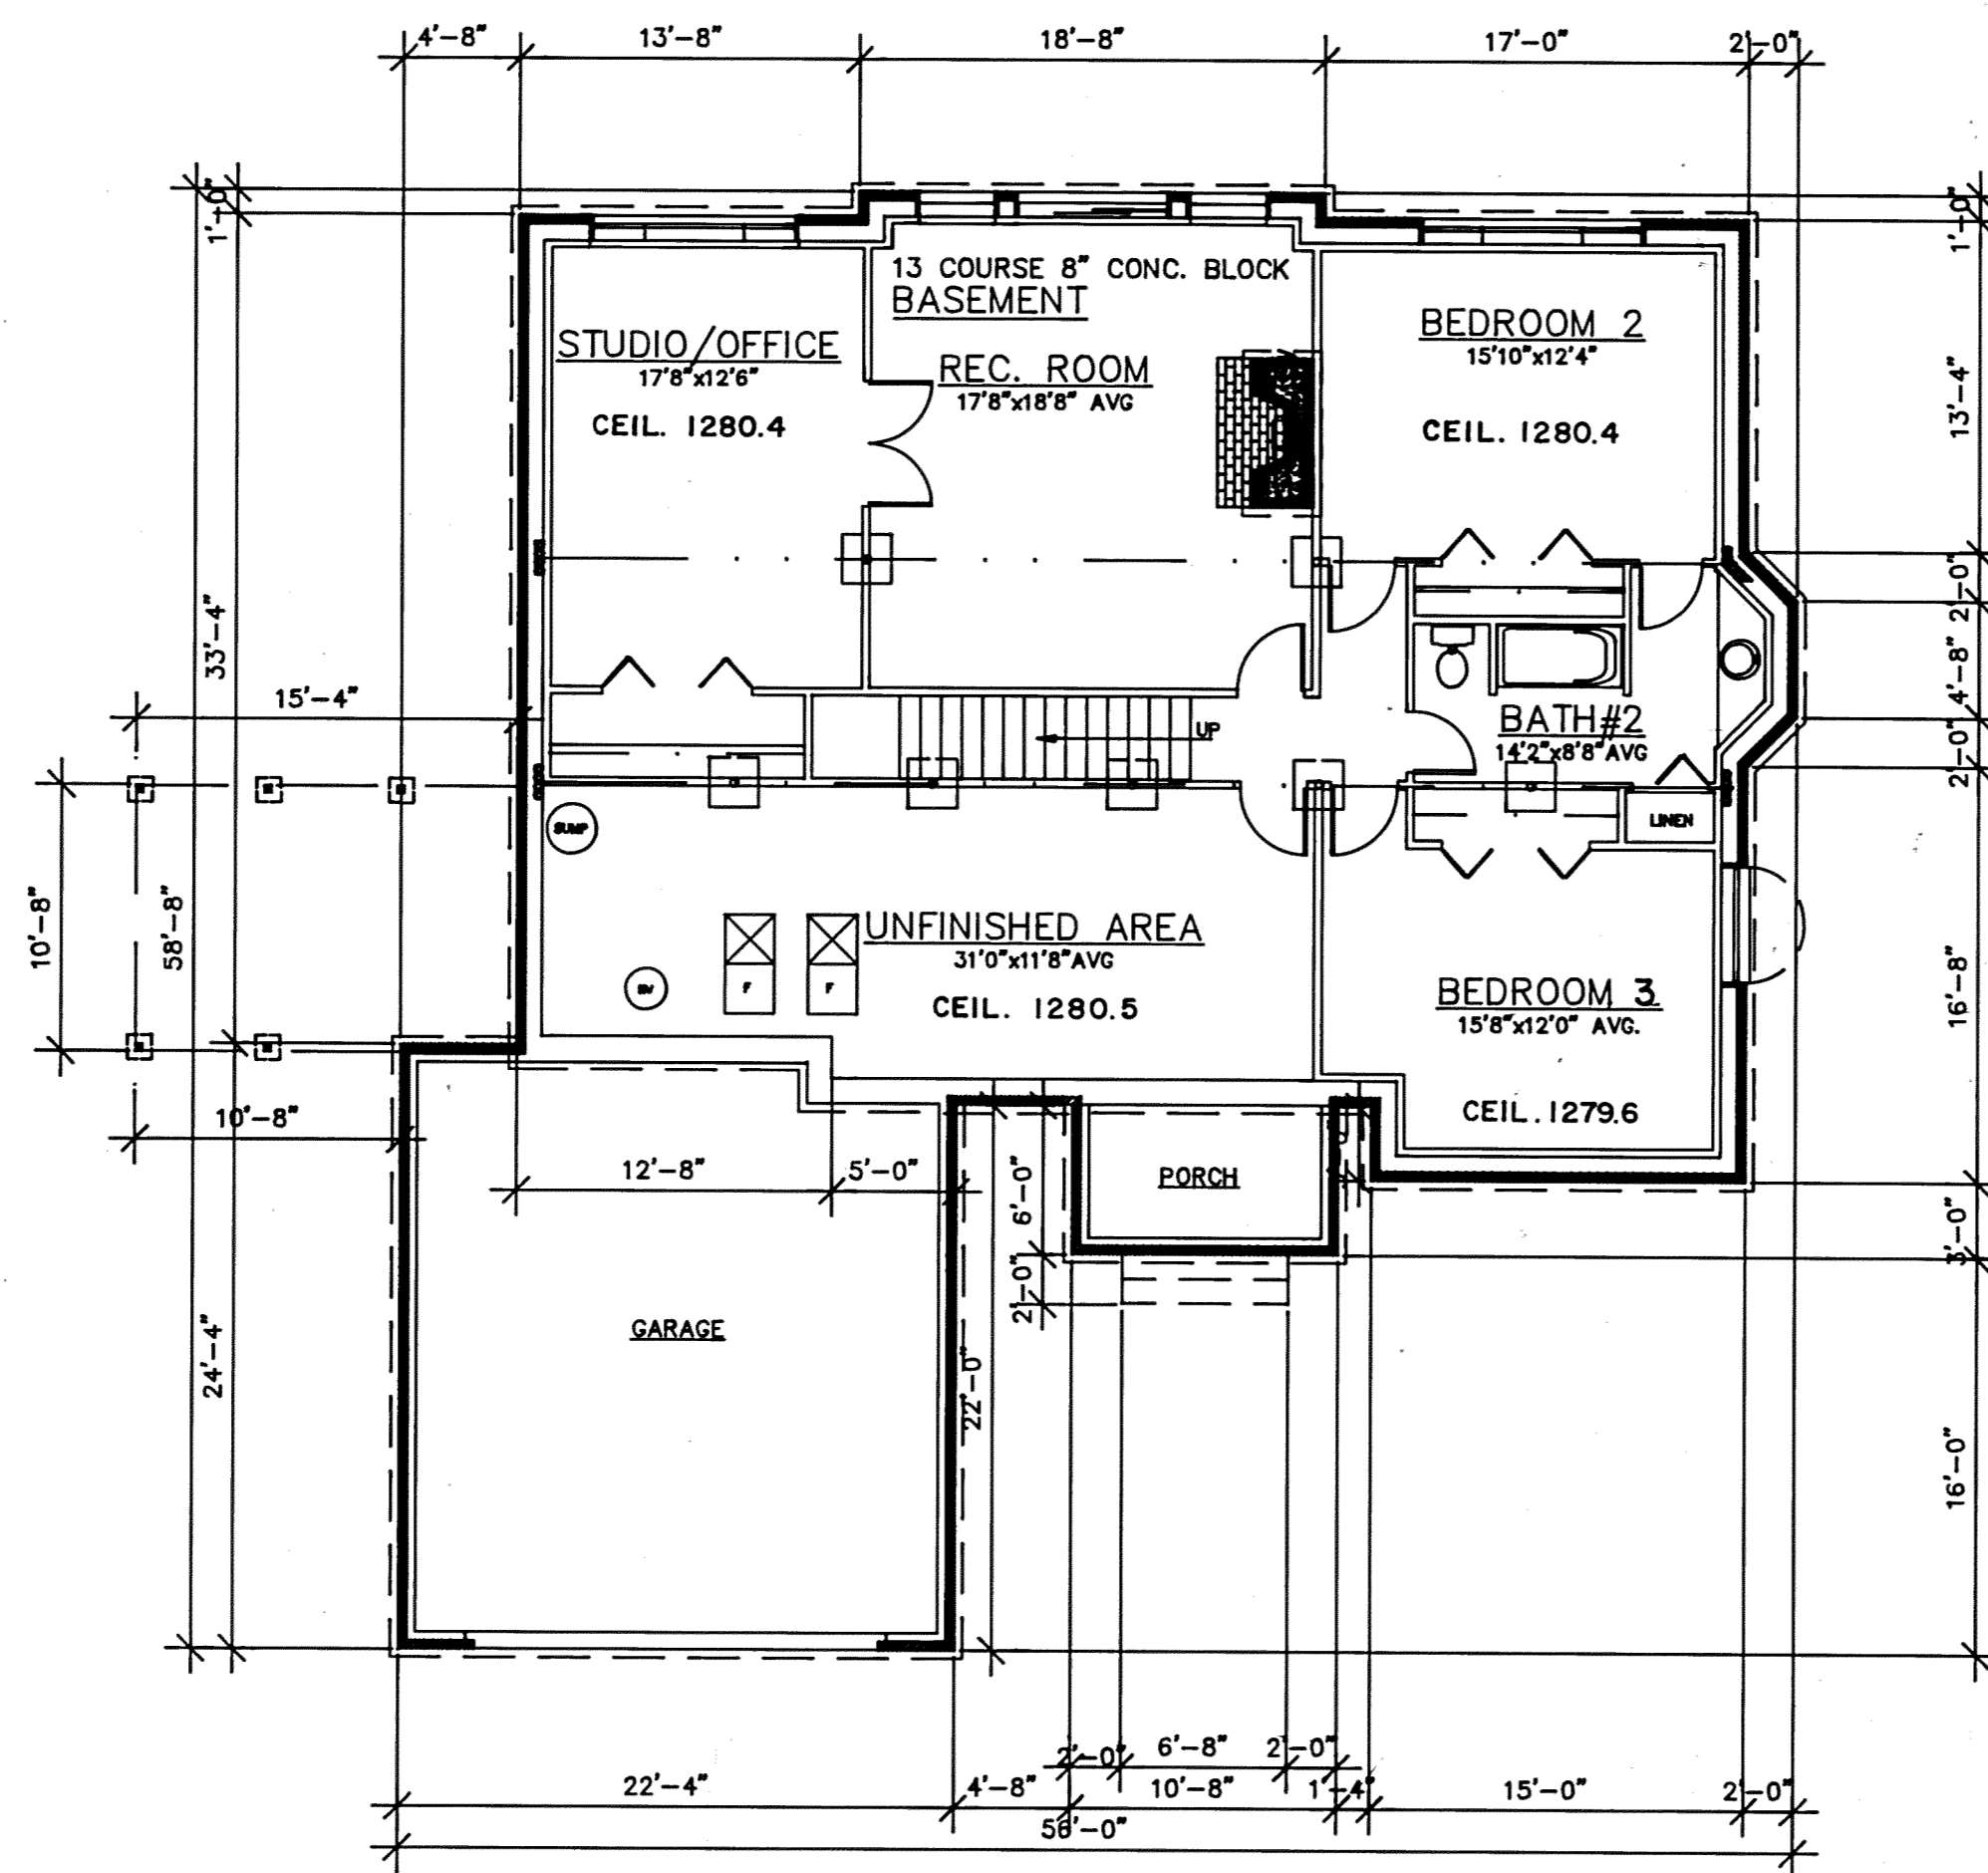


1 BASEMENT AND FOUNDATION PLAN
A1 1423 SF FINISHED + 343 SF UNFINISHED = 1806 SF TOTAL

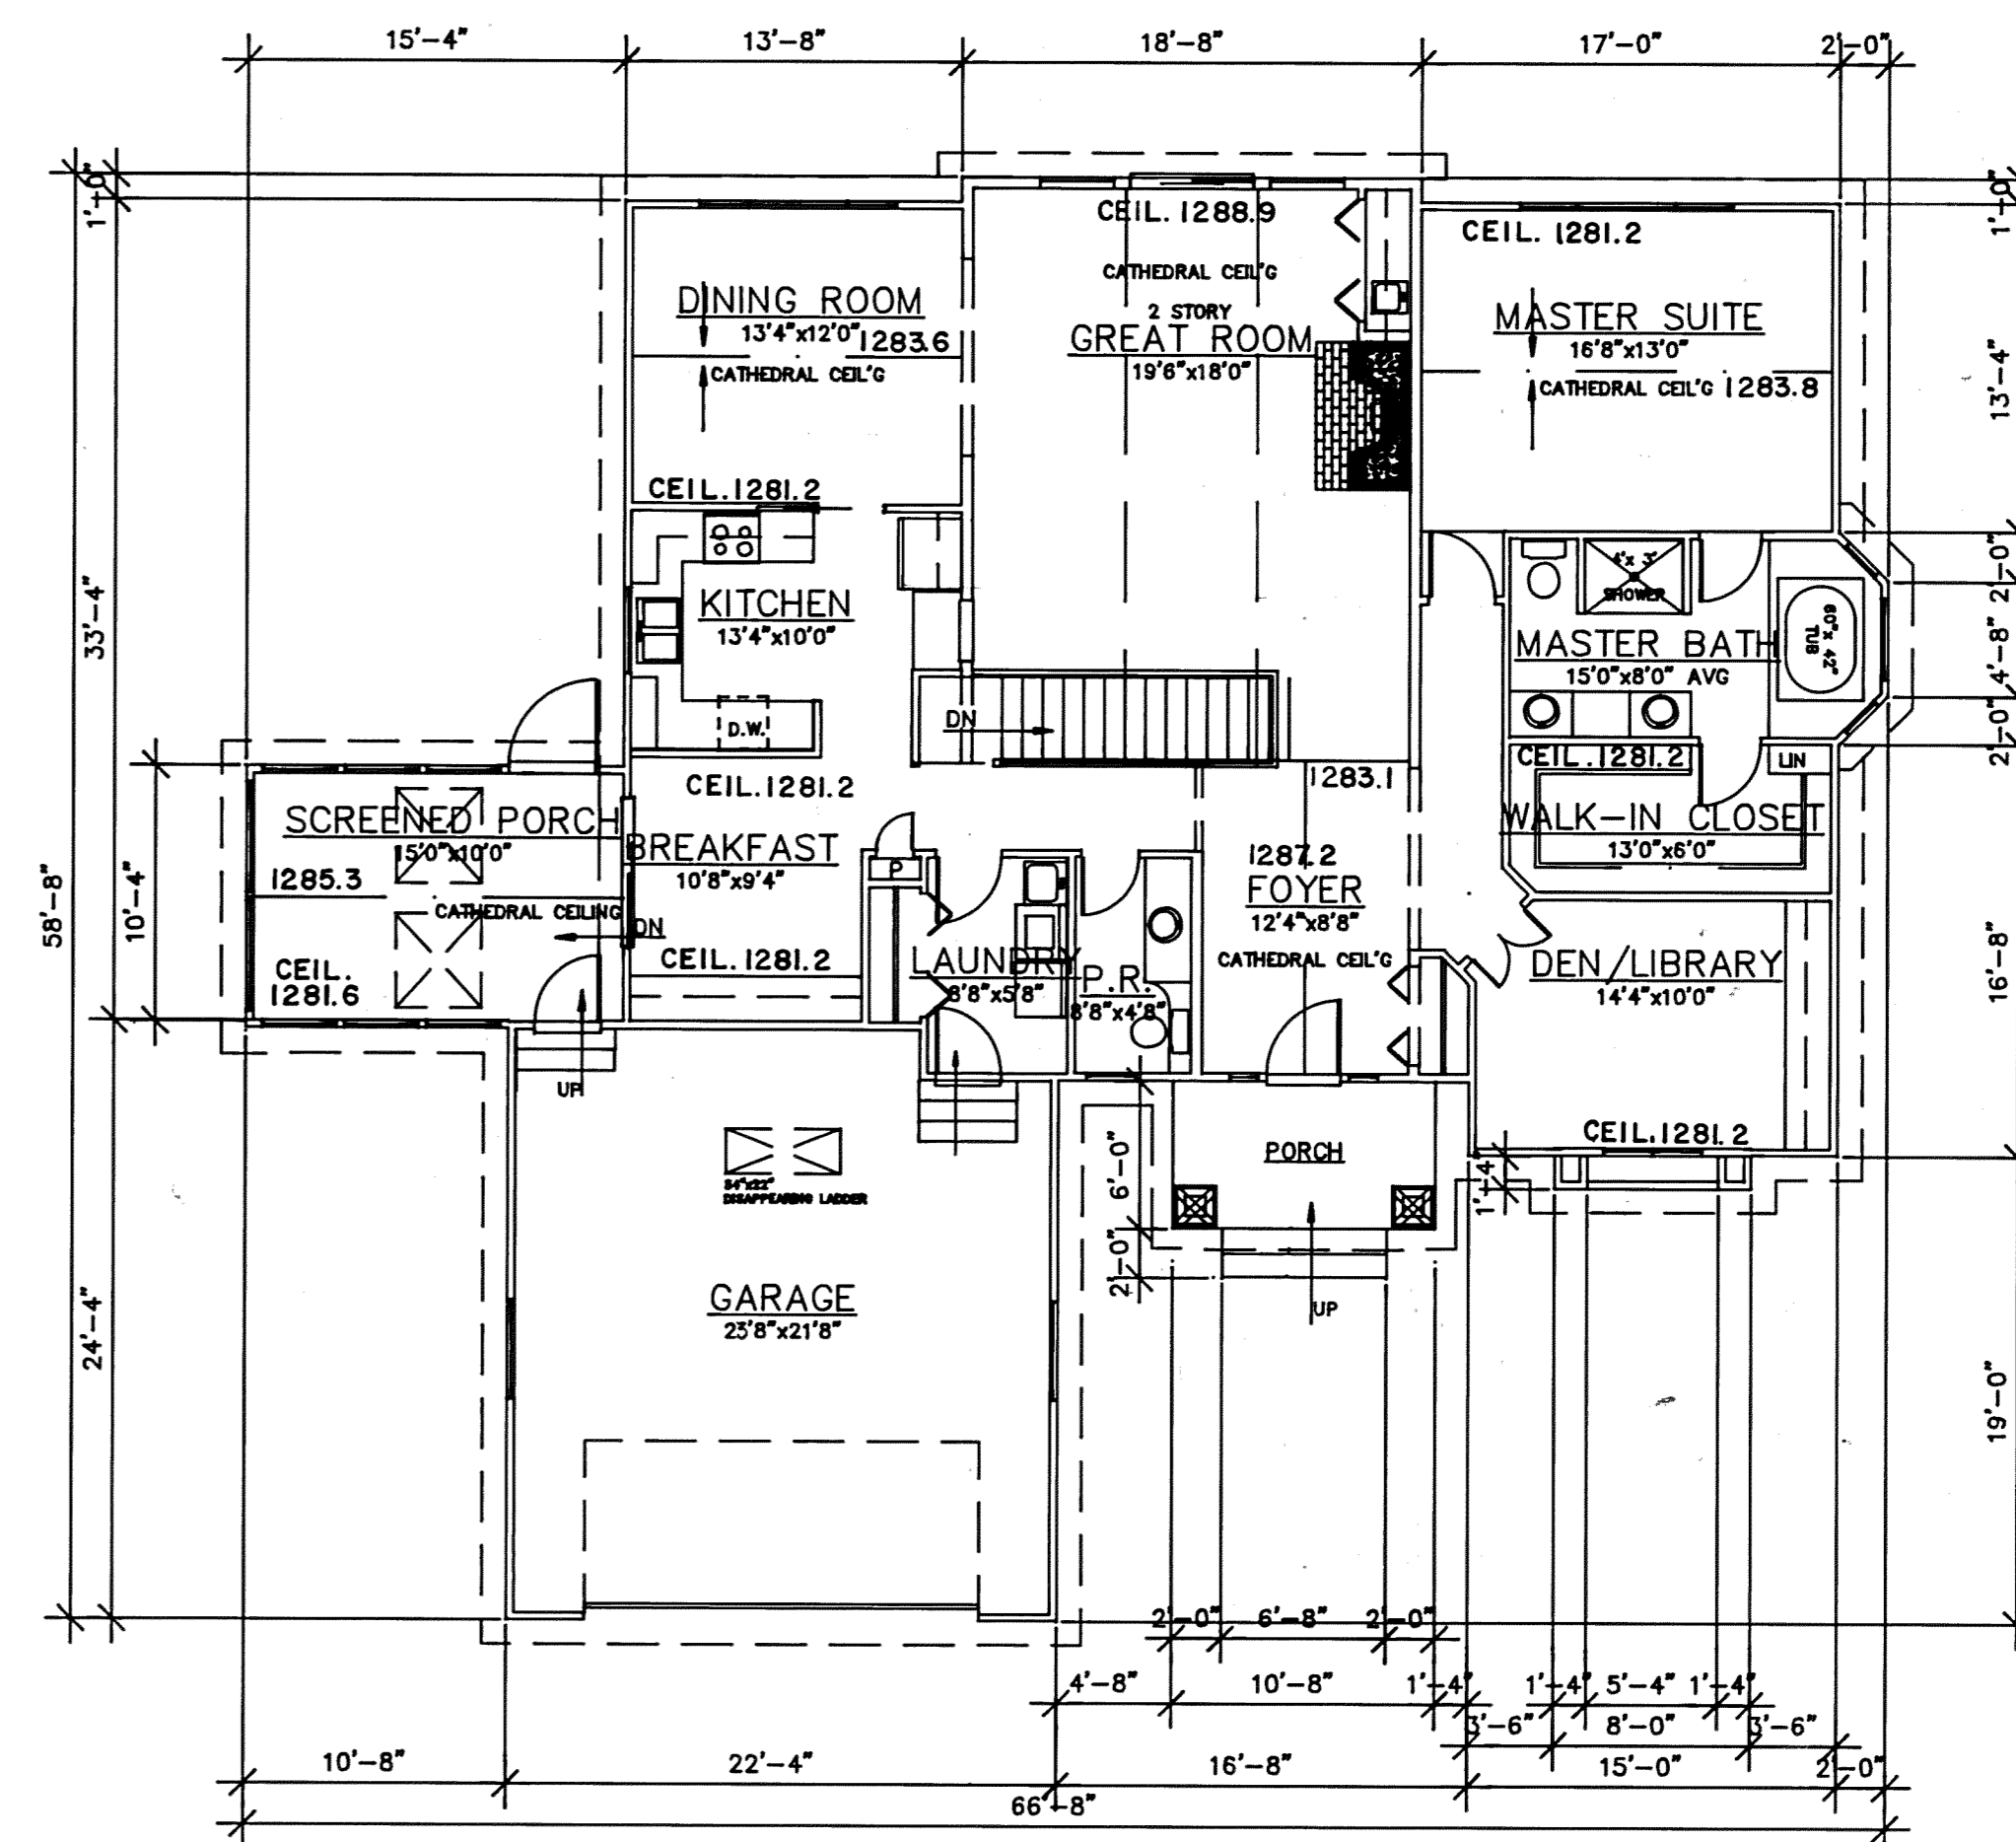

2 FIRST FLOOR PLAN
A1 1806 SF

NOTE:
THE BUILDING DESIGN ALONG WITH THE SQUARE FEET DESIGNATIONS OF THE FLOORS ARE SHOWN AND AS CALCULATED BY GREENBRIAR COMPANIES

UNIT	BASEMENT ELEV		SQ FT	GARAGE ELEV		SQ FT	1ST FLOOR ELEV		SQ FT	2ND FLOOR ELEV		SQ FT	TOTAL SF
	FLOOR	CEILING		FLOOR	CEILING		FLOOR	CEILING		FLOOR	CEILING		
A	1262.8	SEE PLAN	1806 SF	1270.2	1281.1	533 SF	1272.1	SEE PLAN	1806 SF				1806 SF

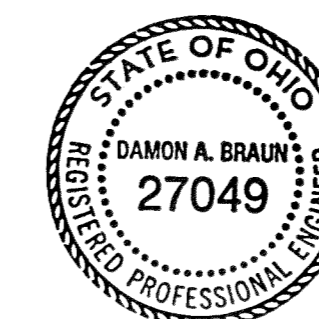

I DO HEREBY CERTIFY THESE DRAWINGS SHOW GRAPHICALLY ALL PARTICULARS OF BUILDING #101 OF AUBURN LAKES CONDOMINIUMS INCLUDING THE LAYOUT, LOCATION, DESIGNATION AND DIMENSIONS OF EACH FAMILY UNIT AND BUILDINGS AS CONSTRUCTED.

Damon Braun
DAMON BRAUN, PROFESSIONAL ENGINEER

AUBURN LAKES CONDOMINIUMS AMENDMENT NUMBER 46		
BUILDING #101 400 FAIRWAY VIEW FLOOR PLANS		
SCALE: 1/8"=1'-0"	NOV., 1992	SHEET # 3 OF 3
GREENBRIAR COMPANIES 4081 EMBASSY PKWY AKRON, OHIO 44333		