


EXHIBIT A
DECLARATION OF
CONDOMINIUM OWNERSHIP FOR
AUBURN CROSSINGS
CONDOMINIUM

SITUATED IN THE TOWNSHIP OF AUBURN, COUNTY OF GEauga AND STATE OF OHIO, AND KNOWN AS BEING PART OF ORIGINAL AUBURN TOWNSHIP SECTION ONE, TRACT TWO AND CONTAINING 28.406 AC.

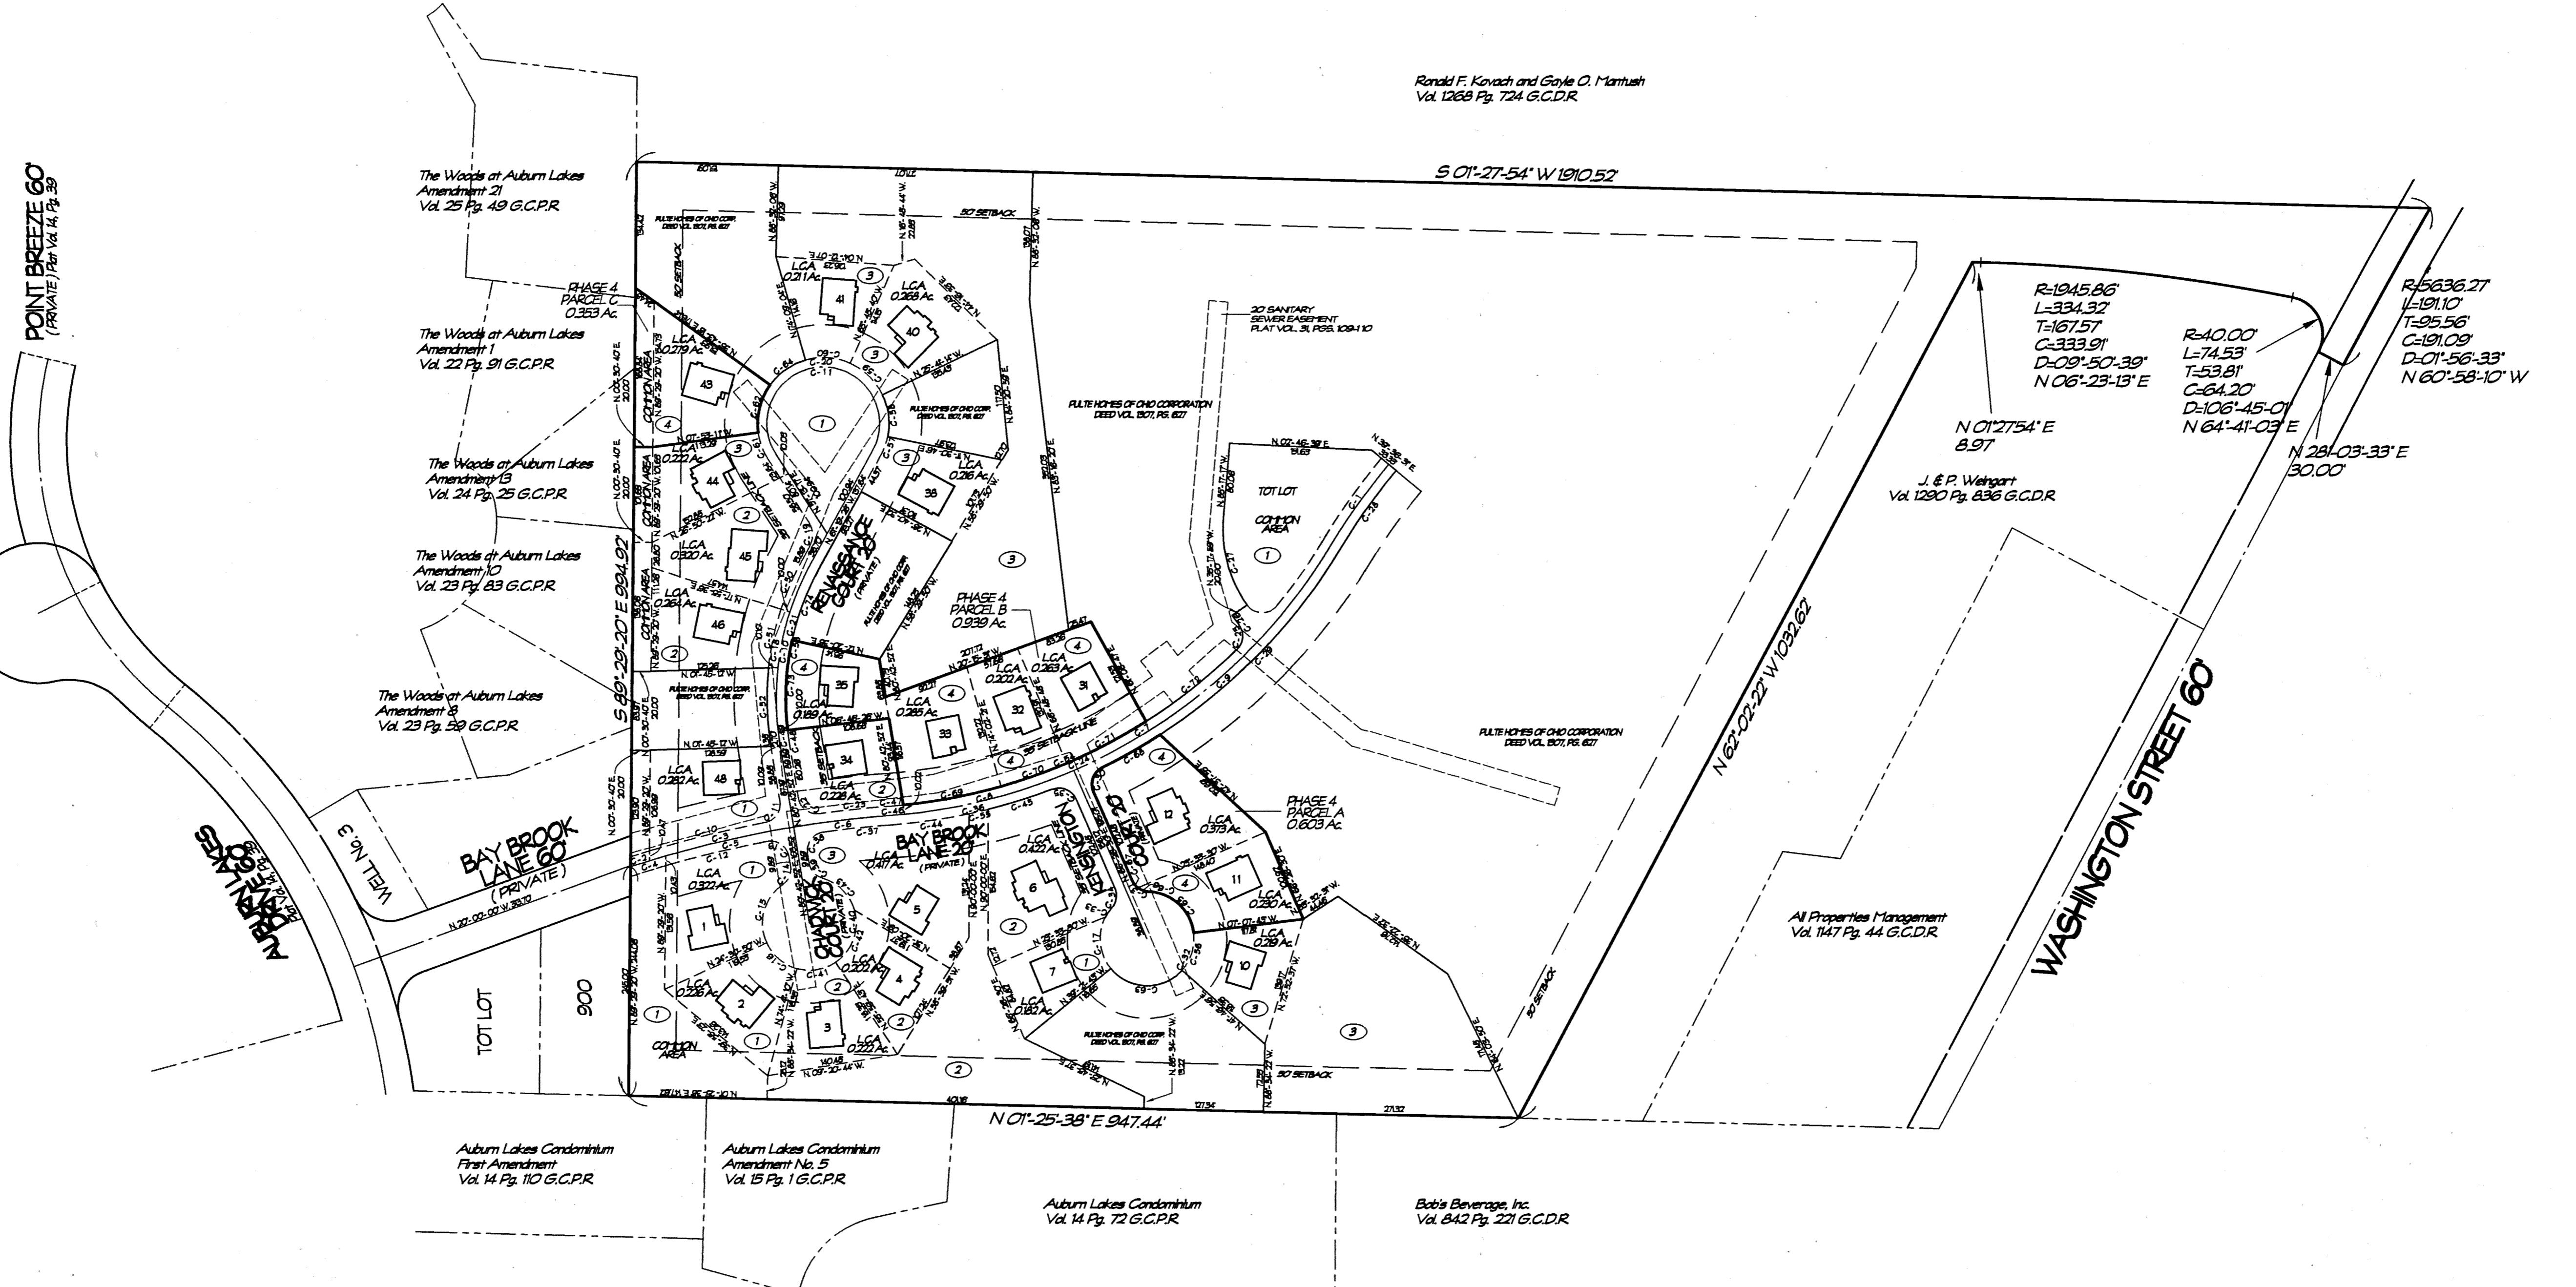

THE UNDERSIGNED HEREBY CERTIFIES THAT THIS PLAT WAS PREPARED FROM AN ACTUAL SURVEY, THAT THE SAME SHOWS GRAPHICALLY, IN SO FAR AS POSSIBLE, THE LOCATION OF BOUNDARIES, THE LOCATION, EXTENSION, DESCRIPTION AND DIMENSIONS OF ALL BUILDINGS AND AREAS OF LIMITED COMMON AREAS, THE LOCATION AND DIMENSIONS OF ALL APPURTENANT EASEMENTS, THAT THERE ARE NO ENCROACHMENTS UPON THE SUBJECT PREMISES NOR FROM THE SUBJECT PREMISES UPON ANY OTHER REAL PROPERTY SURVEYED, INCLUDING THE RIGHT-OF-WAY LINES FOR WASHINGTON STREET AND BAY BROOK LANE ARE CONTOUROUS TO THE PERIMETER LINES OF THE PREMISES ALONG THEIR ENTIRE LENGTH. THE PURPOSE OF THESE CERTIFICATIONS IS TO COMPLY WITH THE REQUIREMENTS OF THE PROVISIONS OF ORC SECTION 531.07, INCLUDING THE REQUIREMENT THAT THIS PLAT ACCURATELY SHOWS THE BUILDINGS AS CONSTRUCTED.

I FURTHER CERTIFY THAT PLATE HOMES OF OHIO CORP. AND RESOURCE TITLE, INC., THAT THE PREMISES WERE ESTABLISHED BY ACTUAL FIELD MEASUREMENTS AND THAT MONUMENTS WERE FOUND OR SET AS SHOWN HEREON.

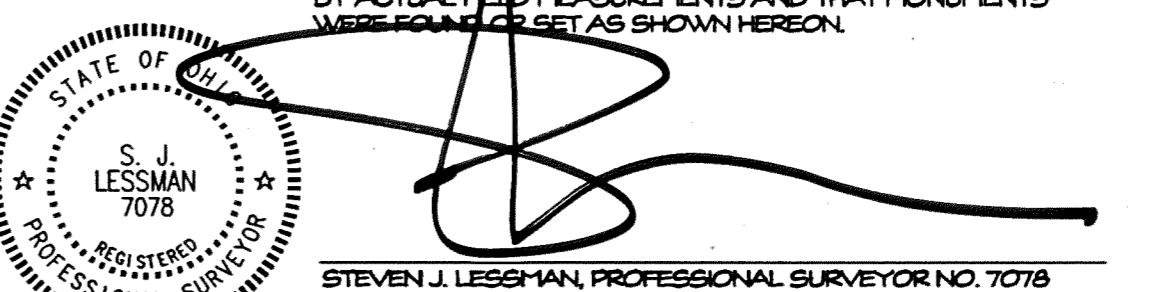


EXHIBIT "A"

DECLARATION OF CONDOMINIUM FOR
AUBURN CROSSINGS


MASTER SITE PLAN

SCALE: 1" = 100' AUG 2001 SHEET 2 OF 25


LESSMAN, BENDER & ASSOCIATES
Engineers - Surveyors - Planners

Village Station 401 South Street Chardon Ohio 44024
Phone: (440) 286-7204 Fax: (440) 286-3535

V.33 · P32

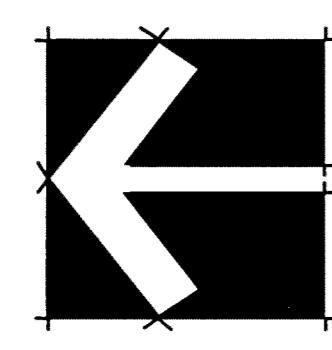


0 100 200 300

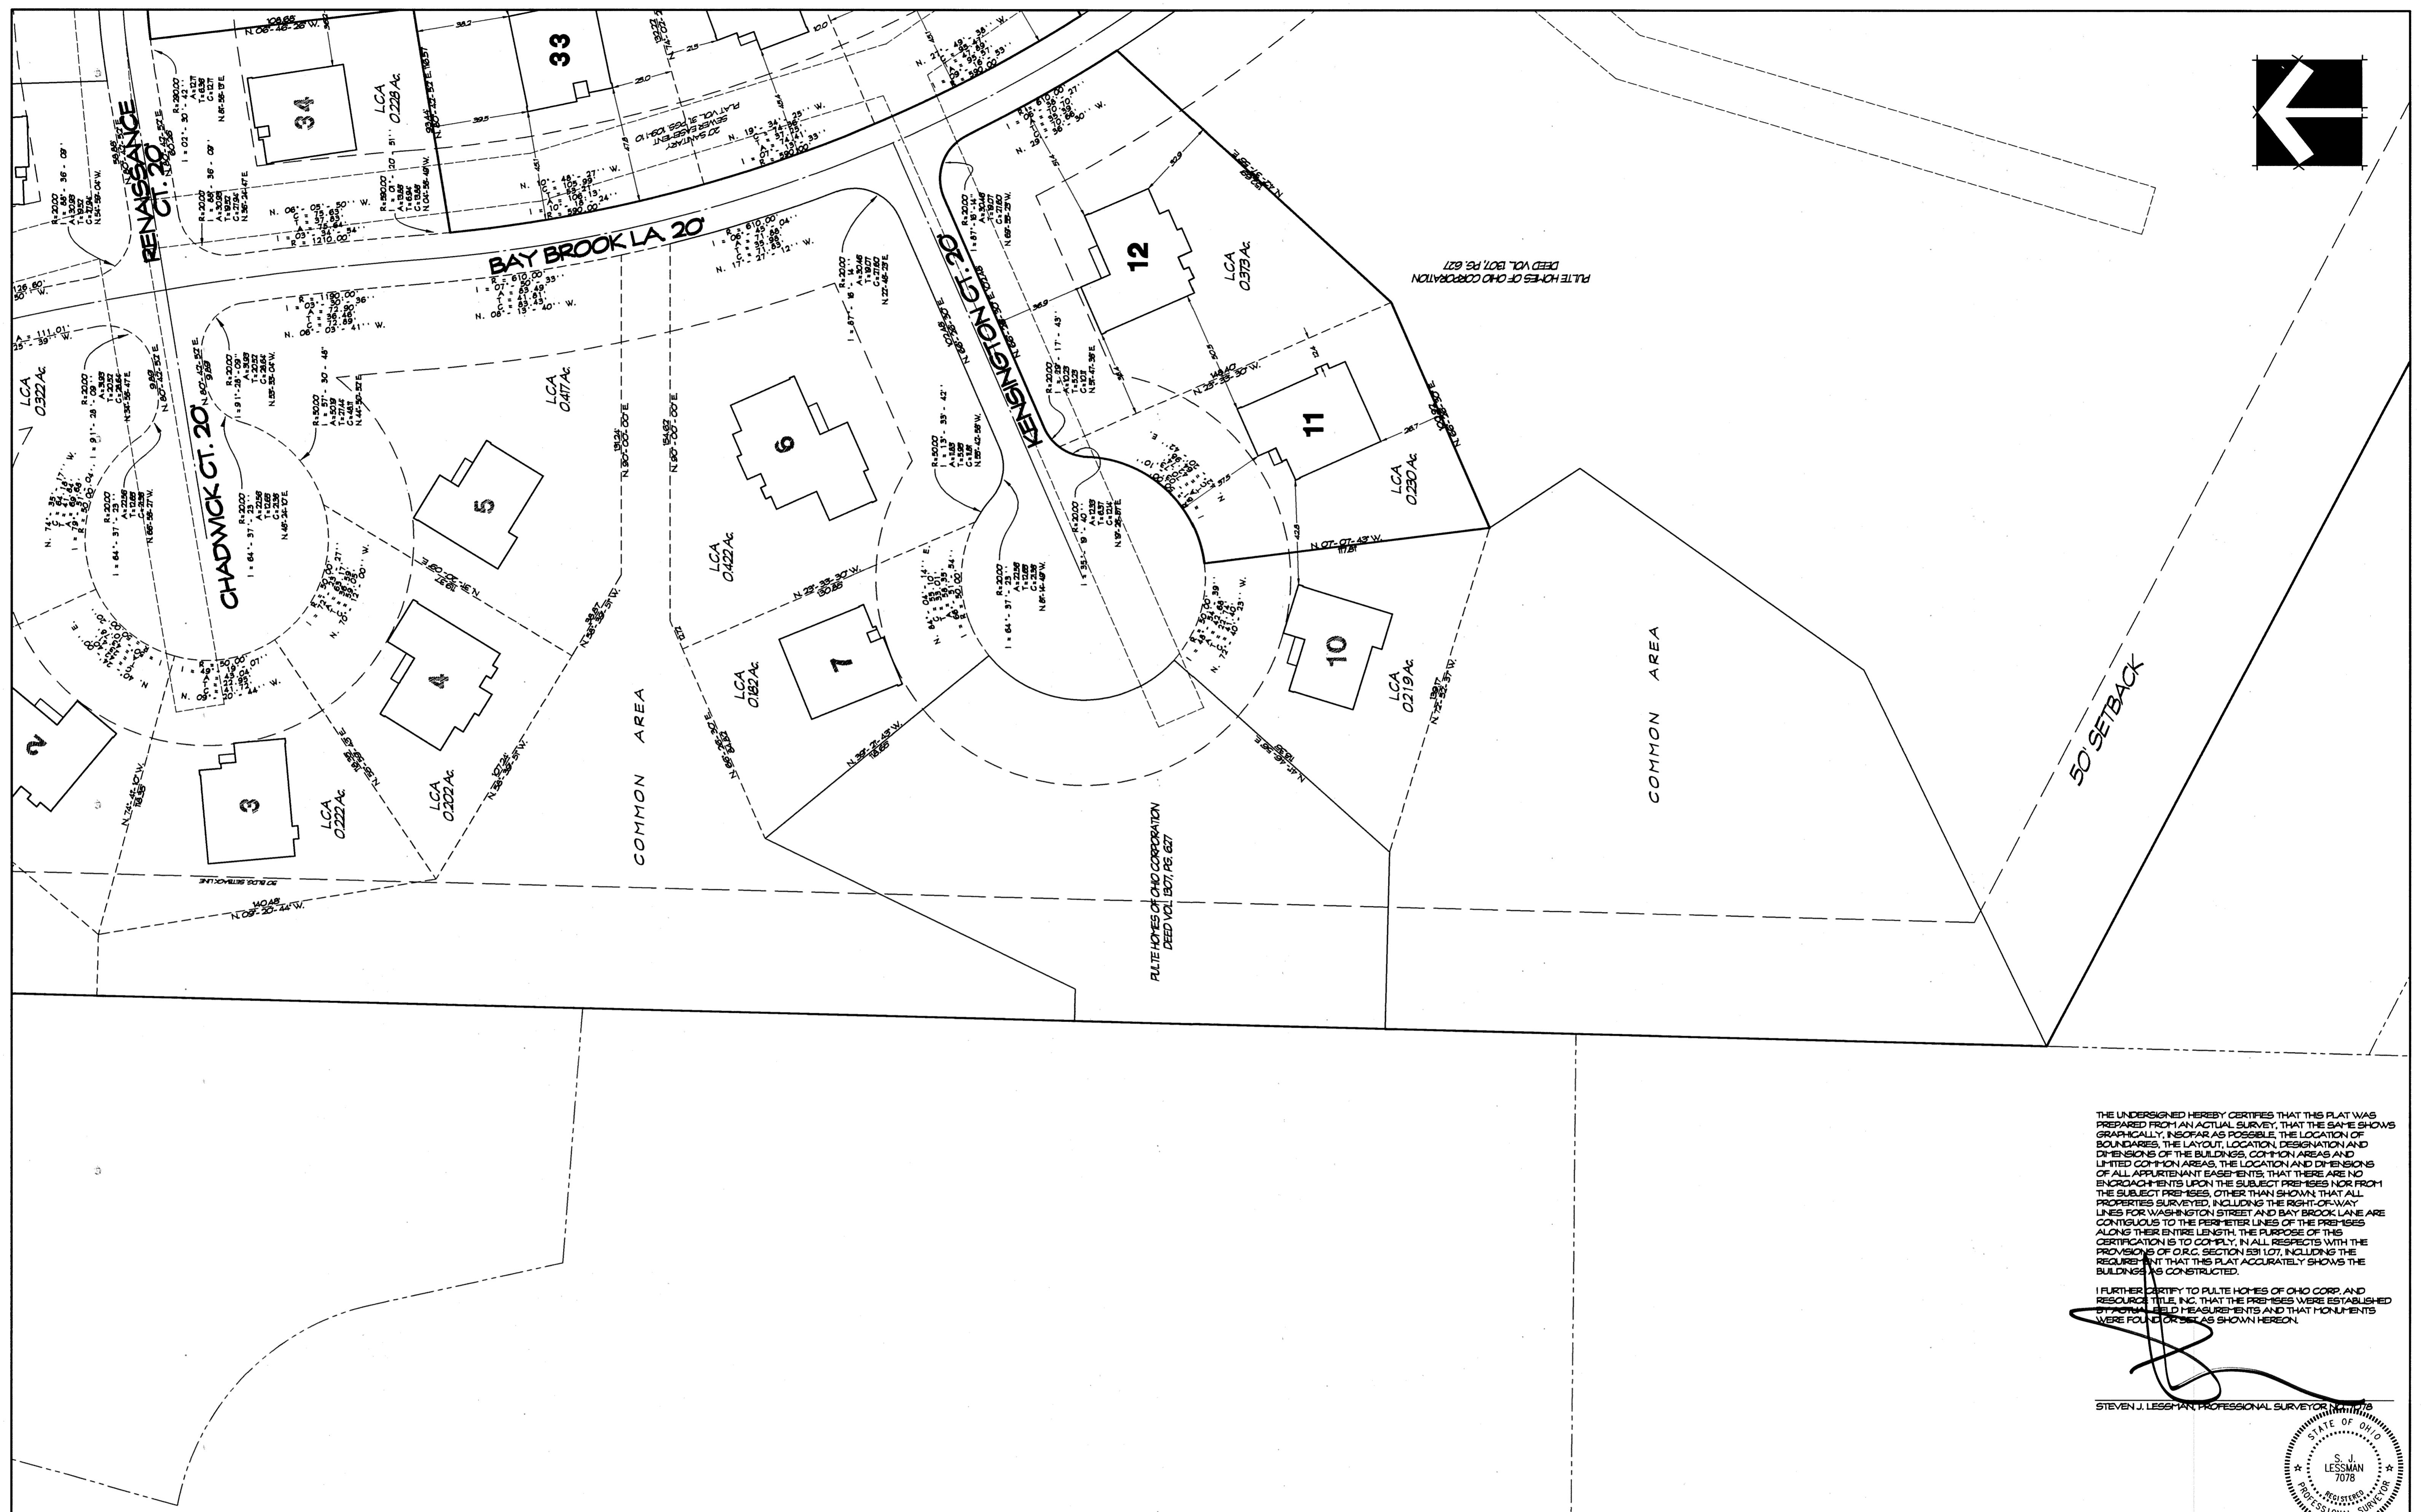


V33 · P33

EXHIBIT "A"

DECLARATION OF CONDOMINIUM FOR AUBURN CROSSINGS	
UNIT NOS. 11 & 12 MASTER SITE PLAN	
SCALE: 1 = 30'	AUG 2001 SHEET 3 OF 25
LESSMAN, BENDER & ASSOCIATES Engineers - Surveyors - Planners	

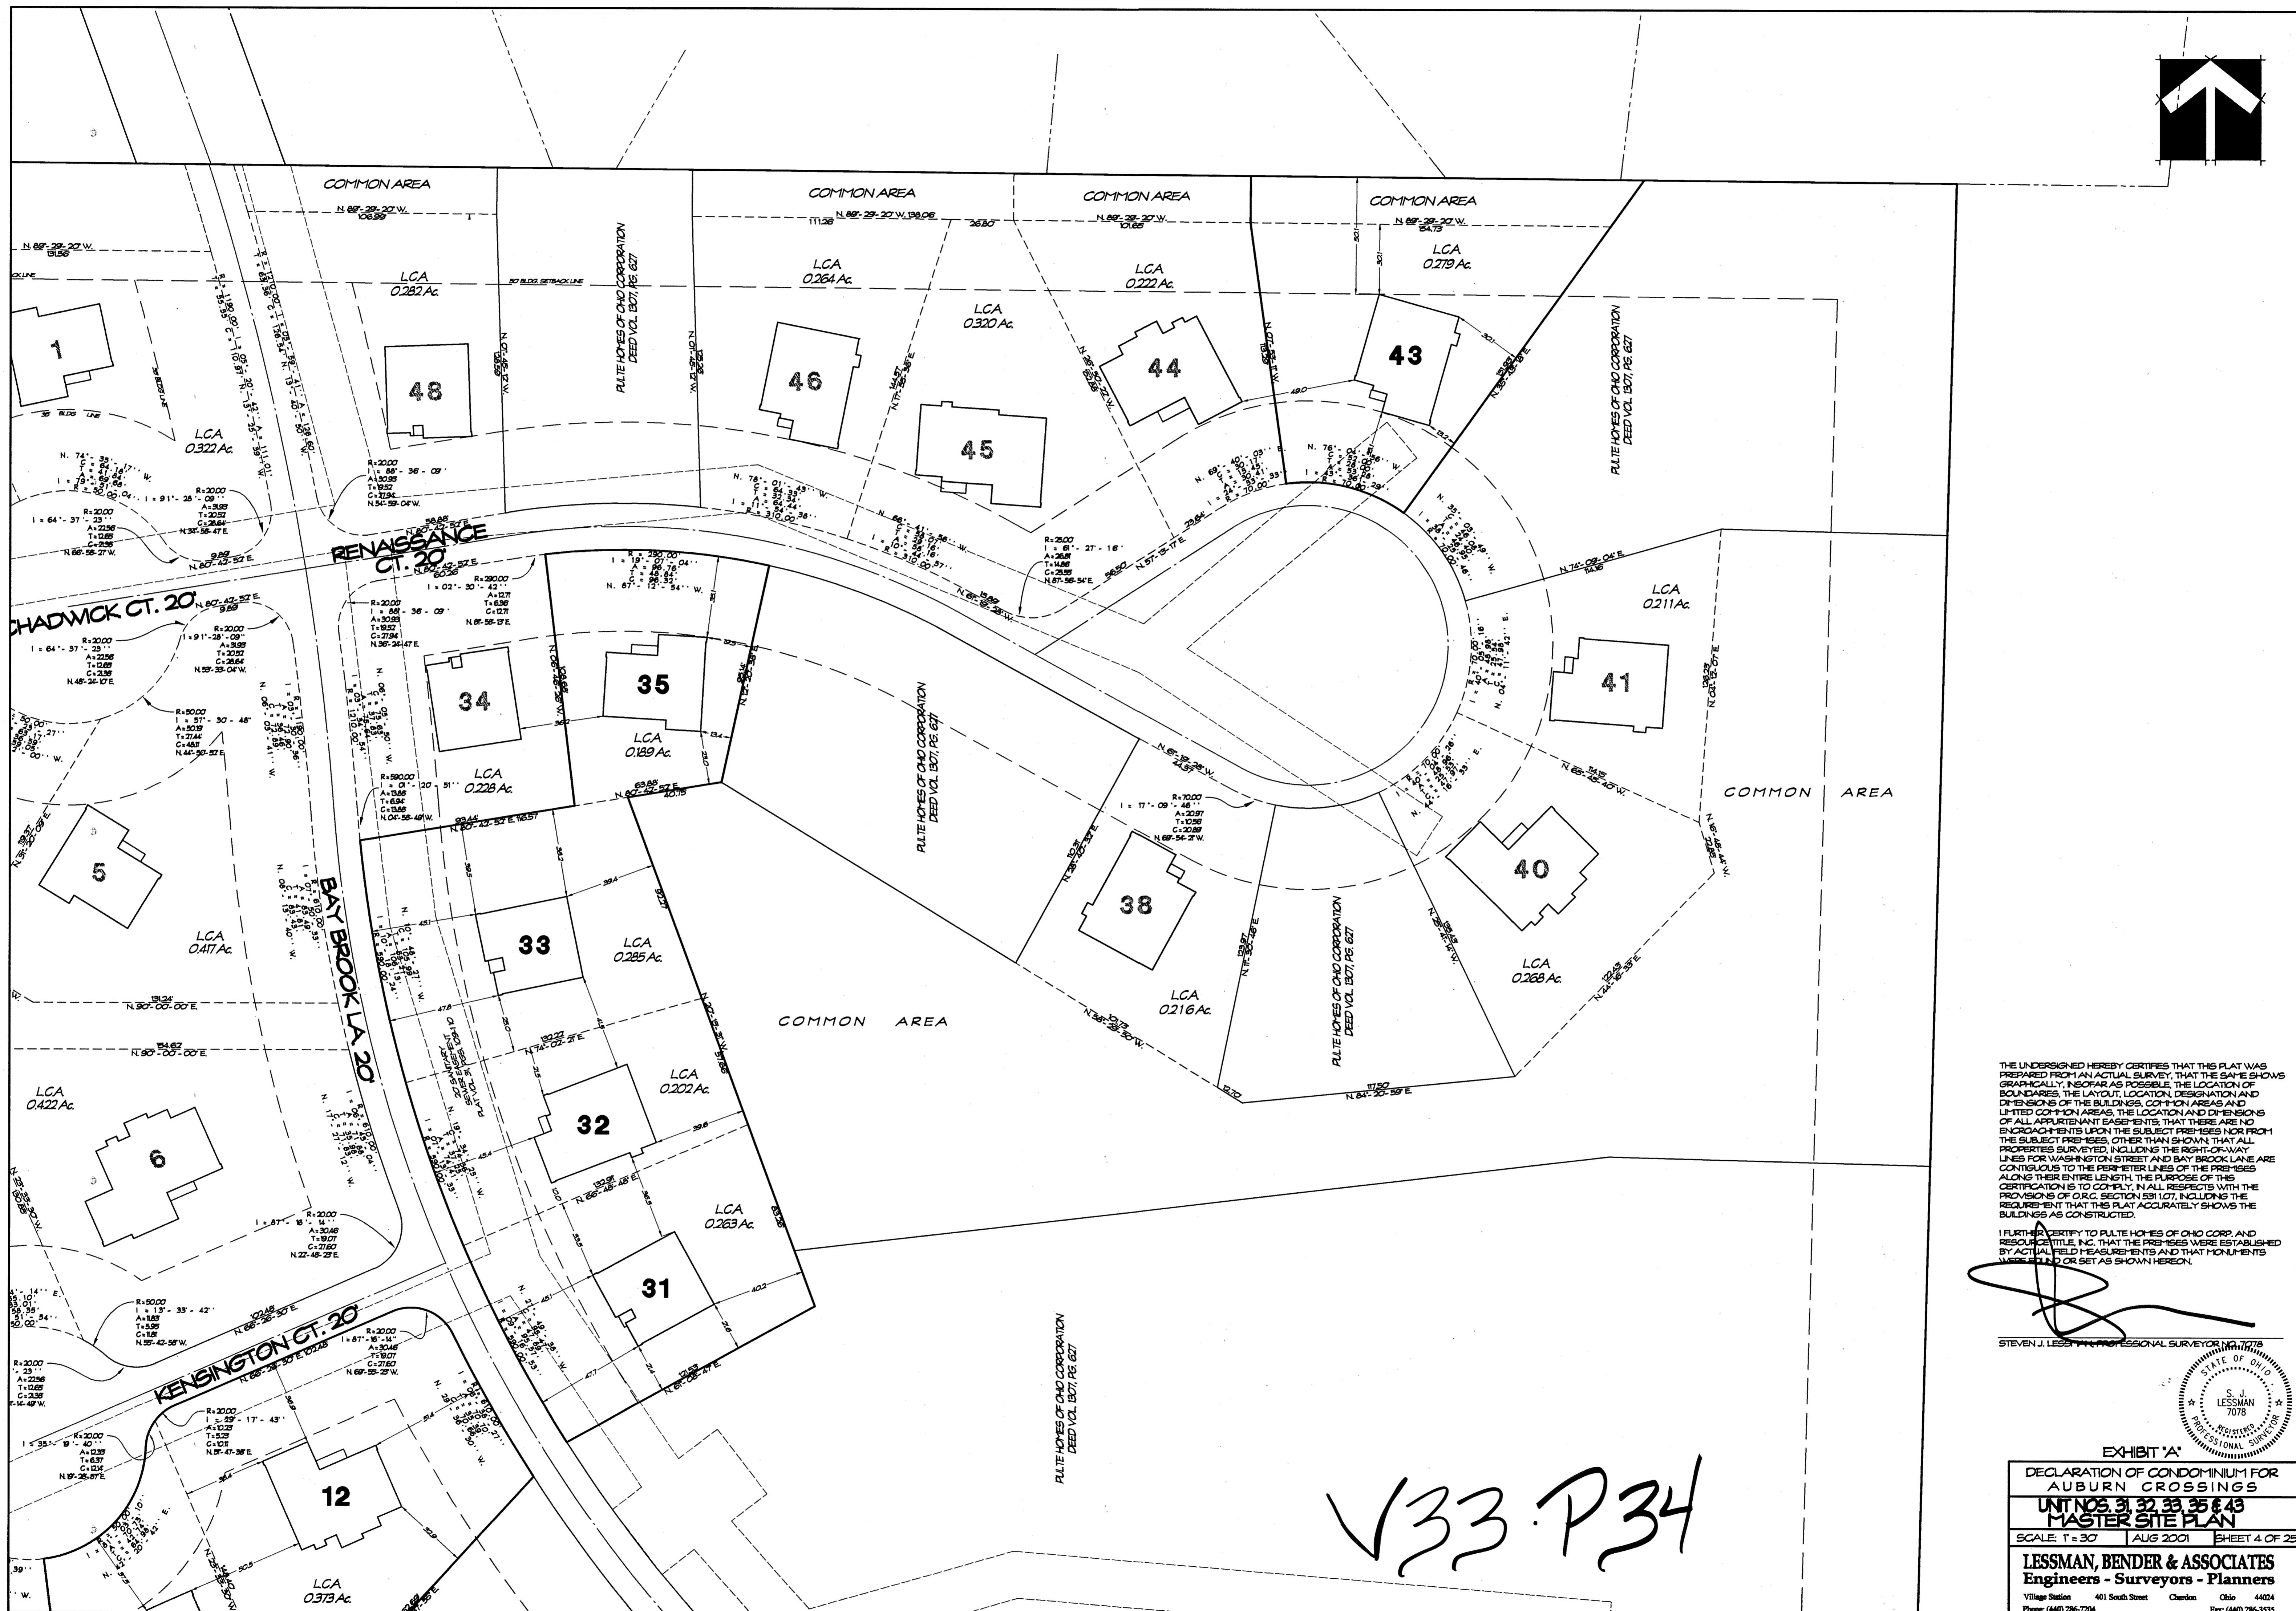

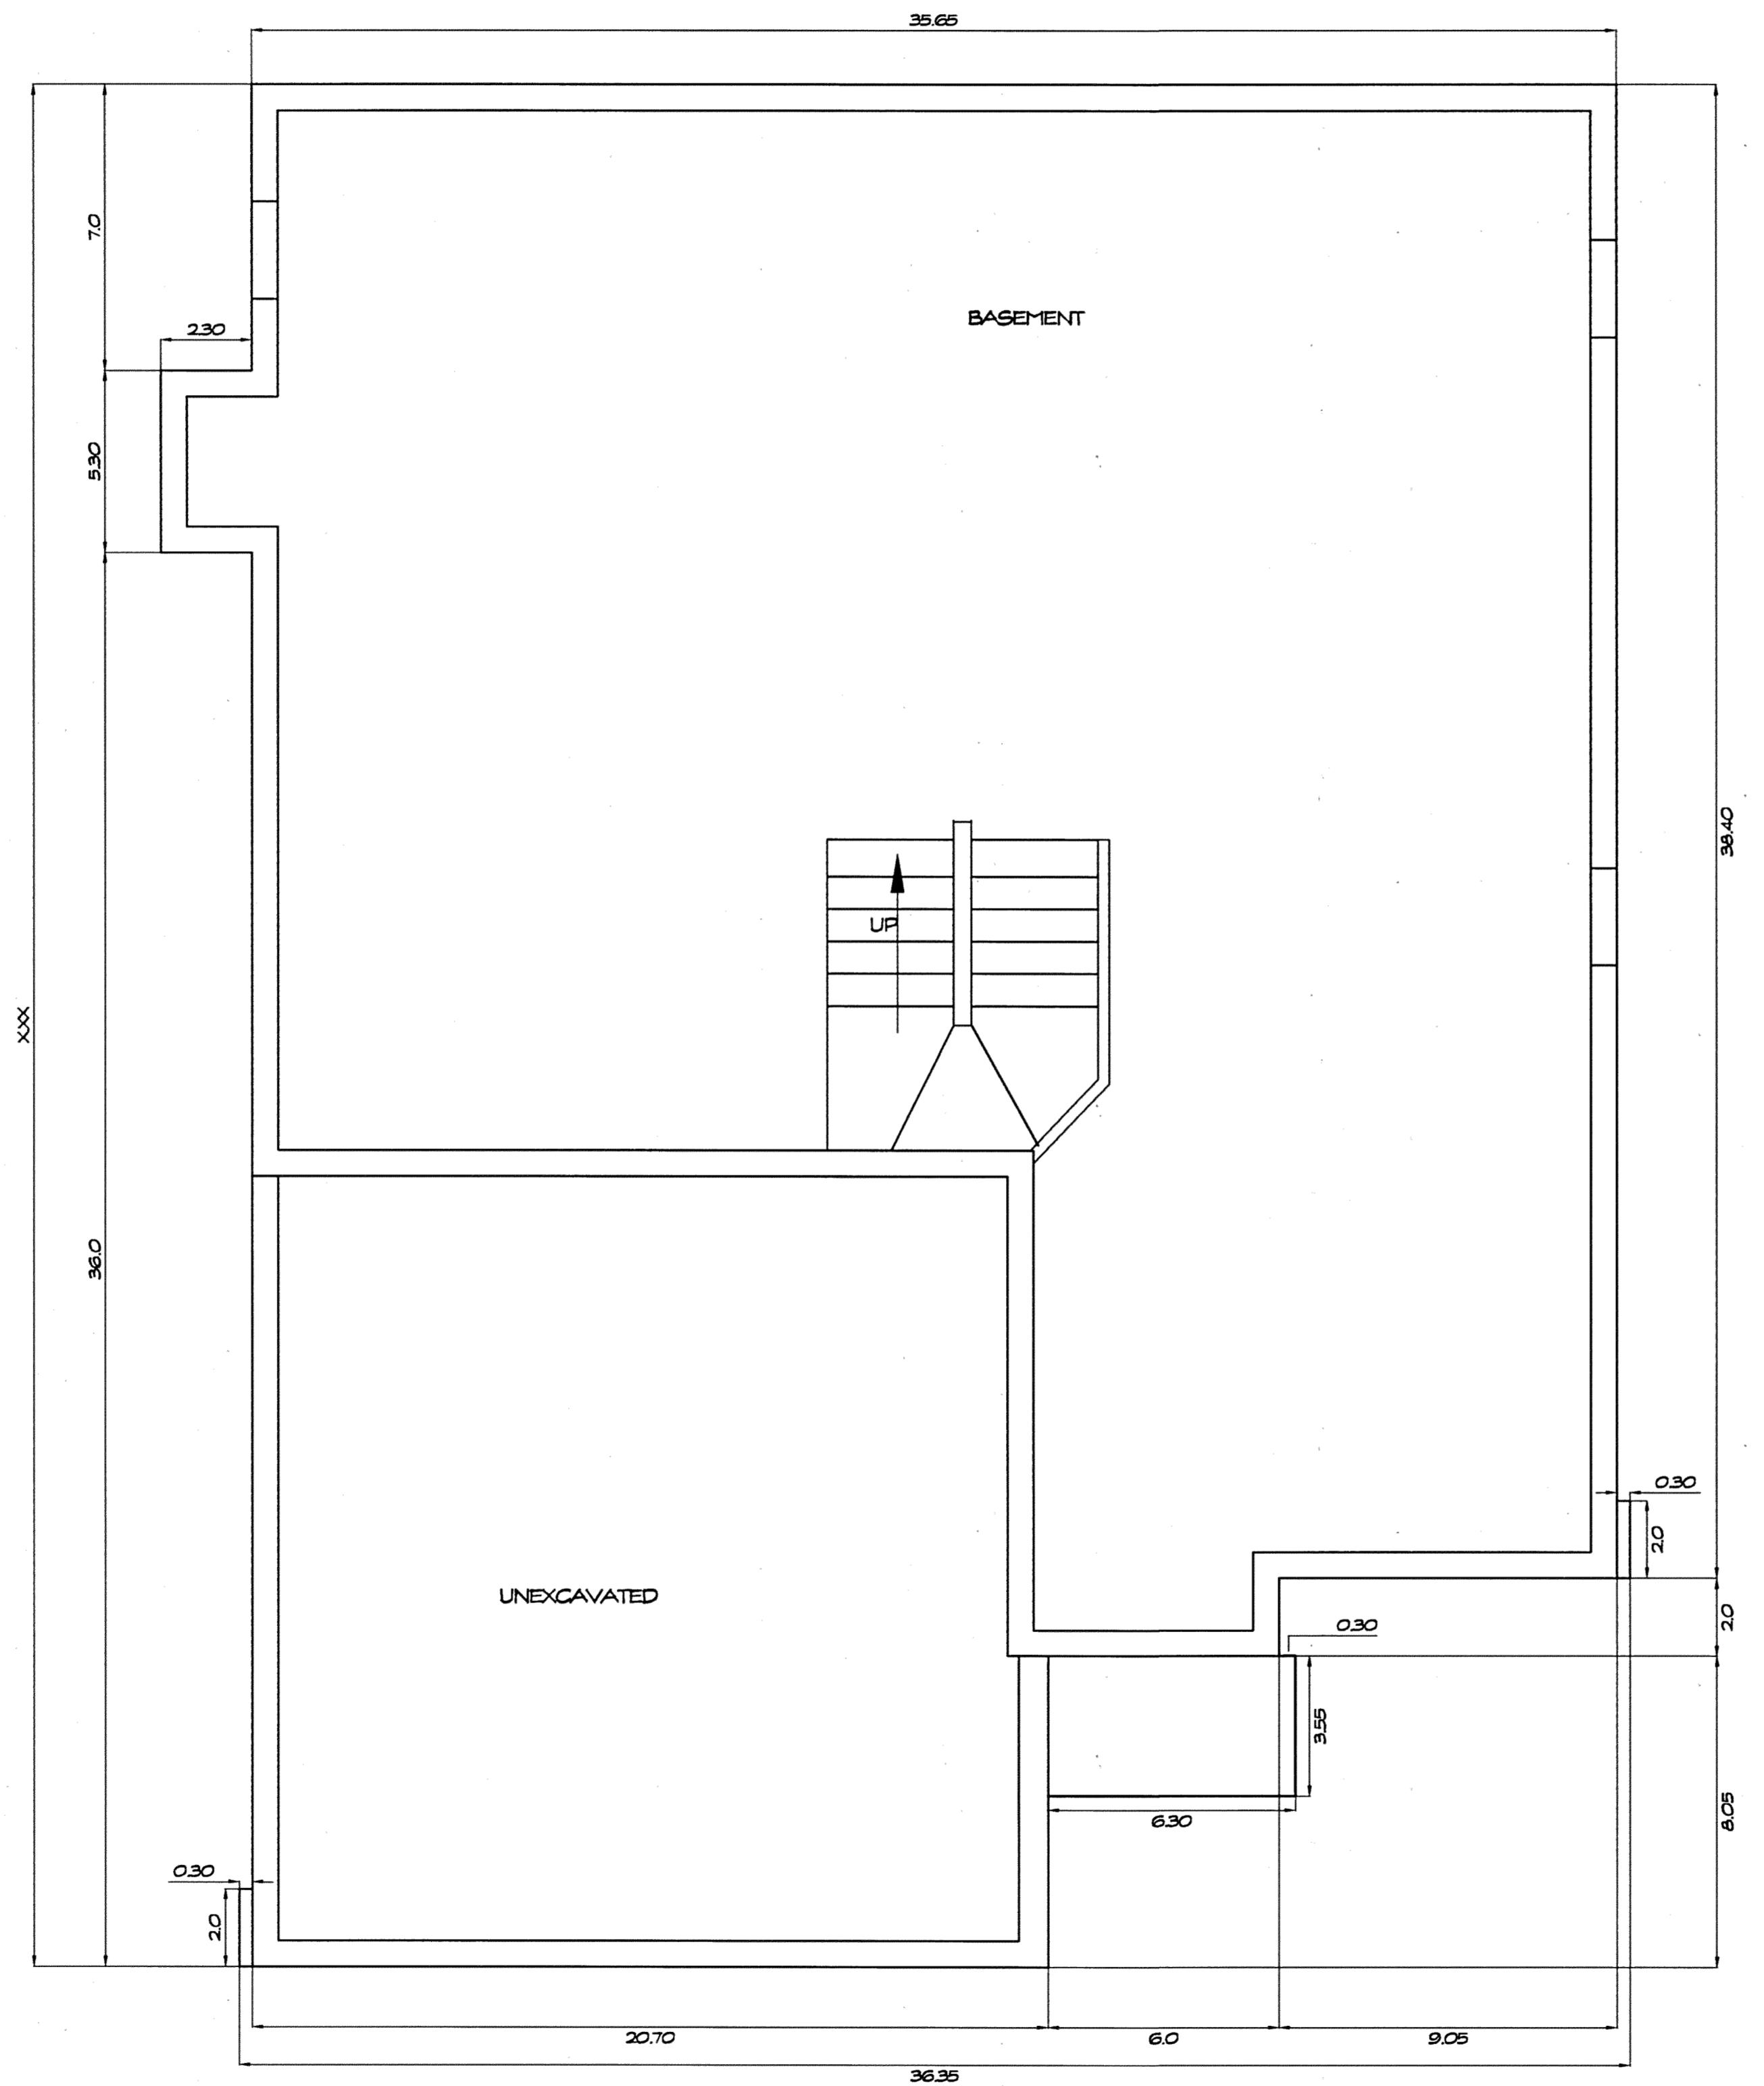

FOUNDATION PLAN

1/4" = 1'-0"

EXHIBIT "A"



DECLARATION OF CONDOMINIUM FOR
AUBURN CROSSINGS

UNIT 11


SCALE: 1/4" = 1'-0" | AUGUST, 2001 | SHEET 5 OF 25

LESSMAN, BENDER & ASSOCIATES
Engineers - Surveyors - Planners

Village Station 401 South Street Chardon Ohio 44024
Phone: (440) 286-7204 Fax: (440) 286-3535

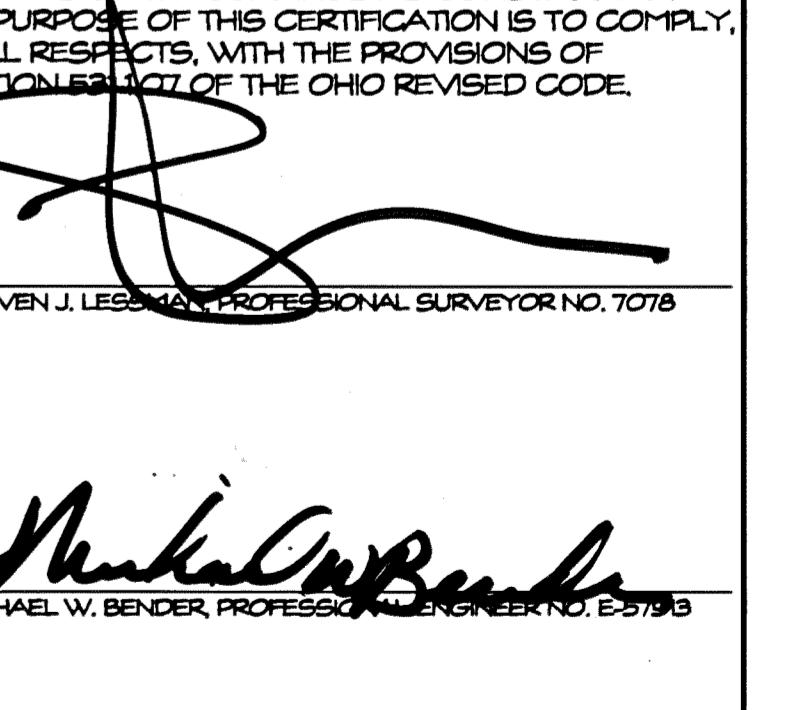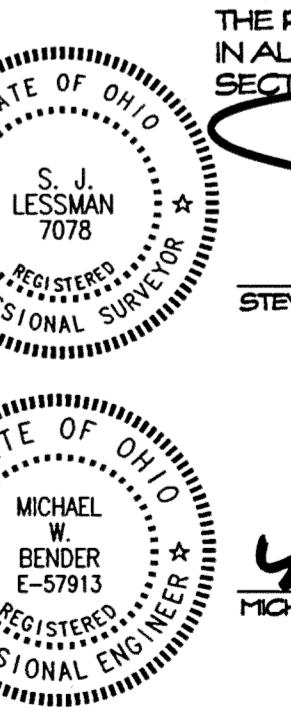

V33 P35

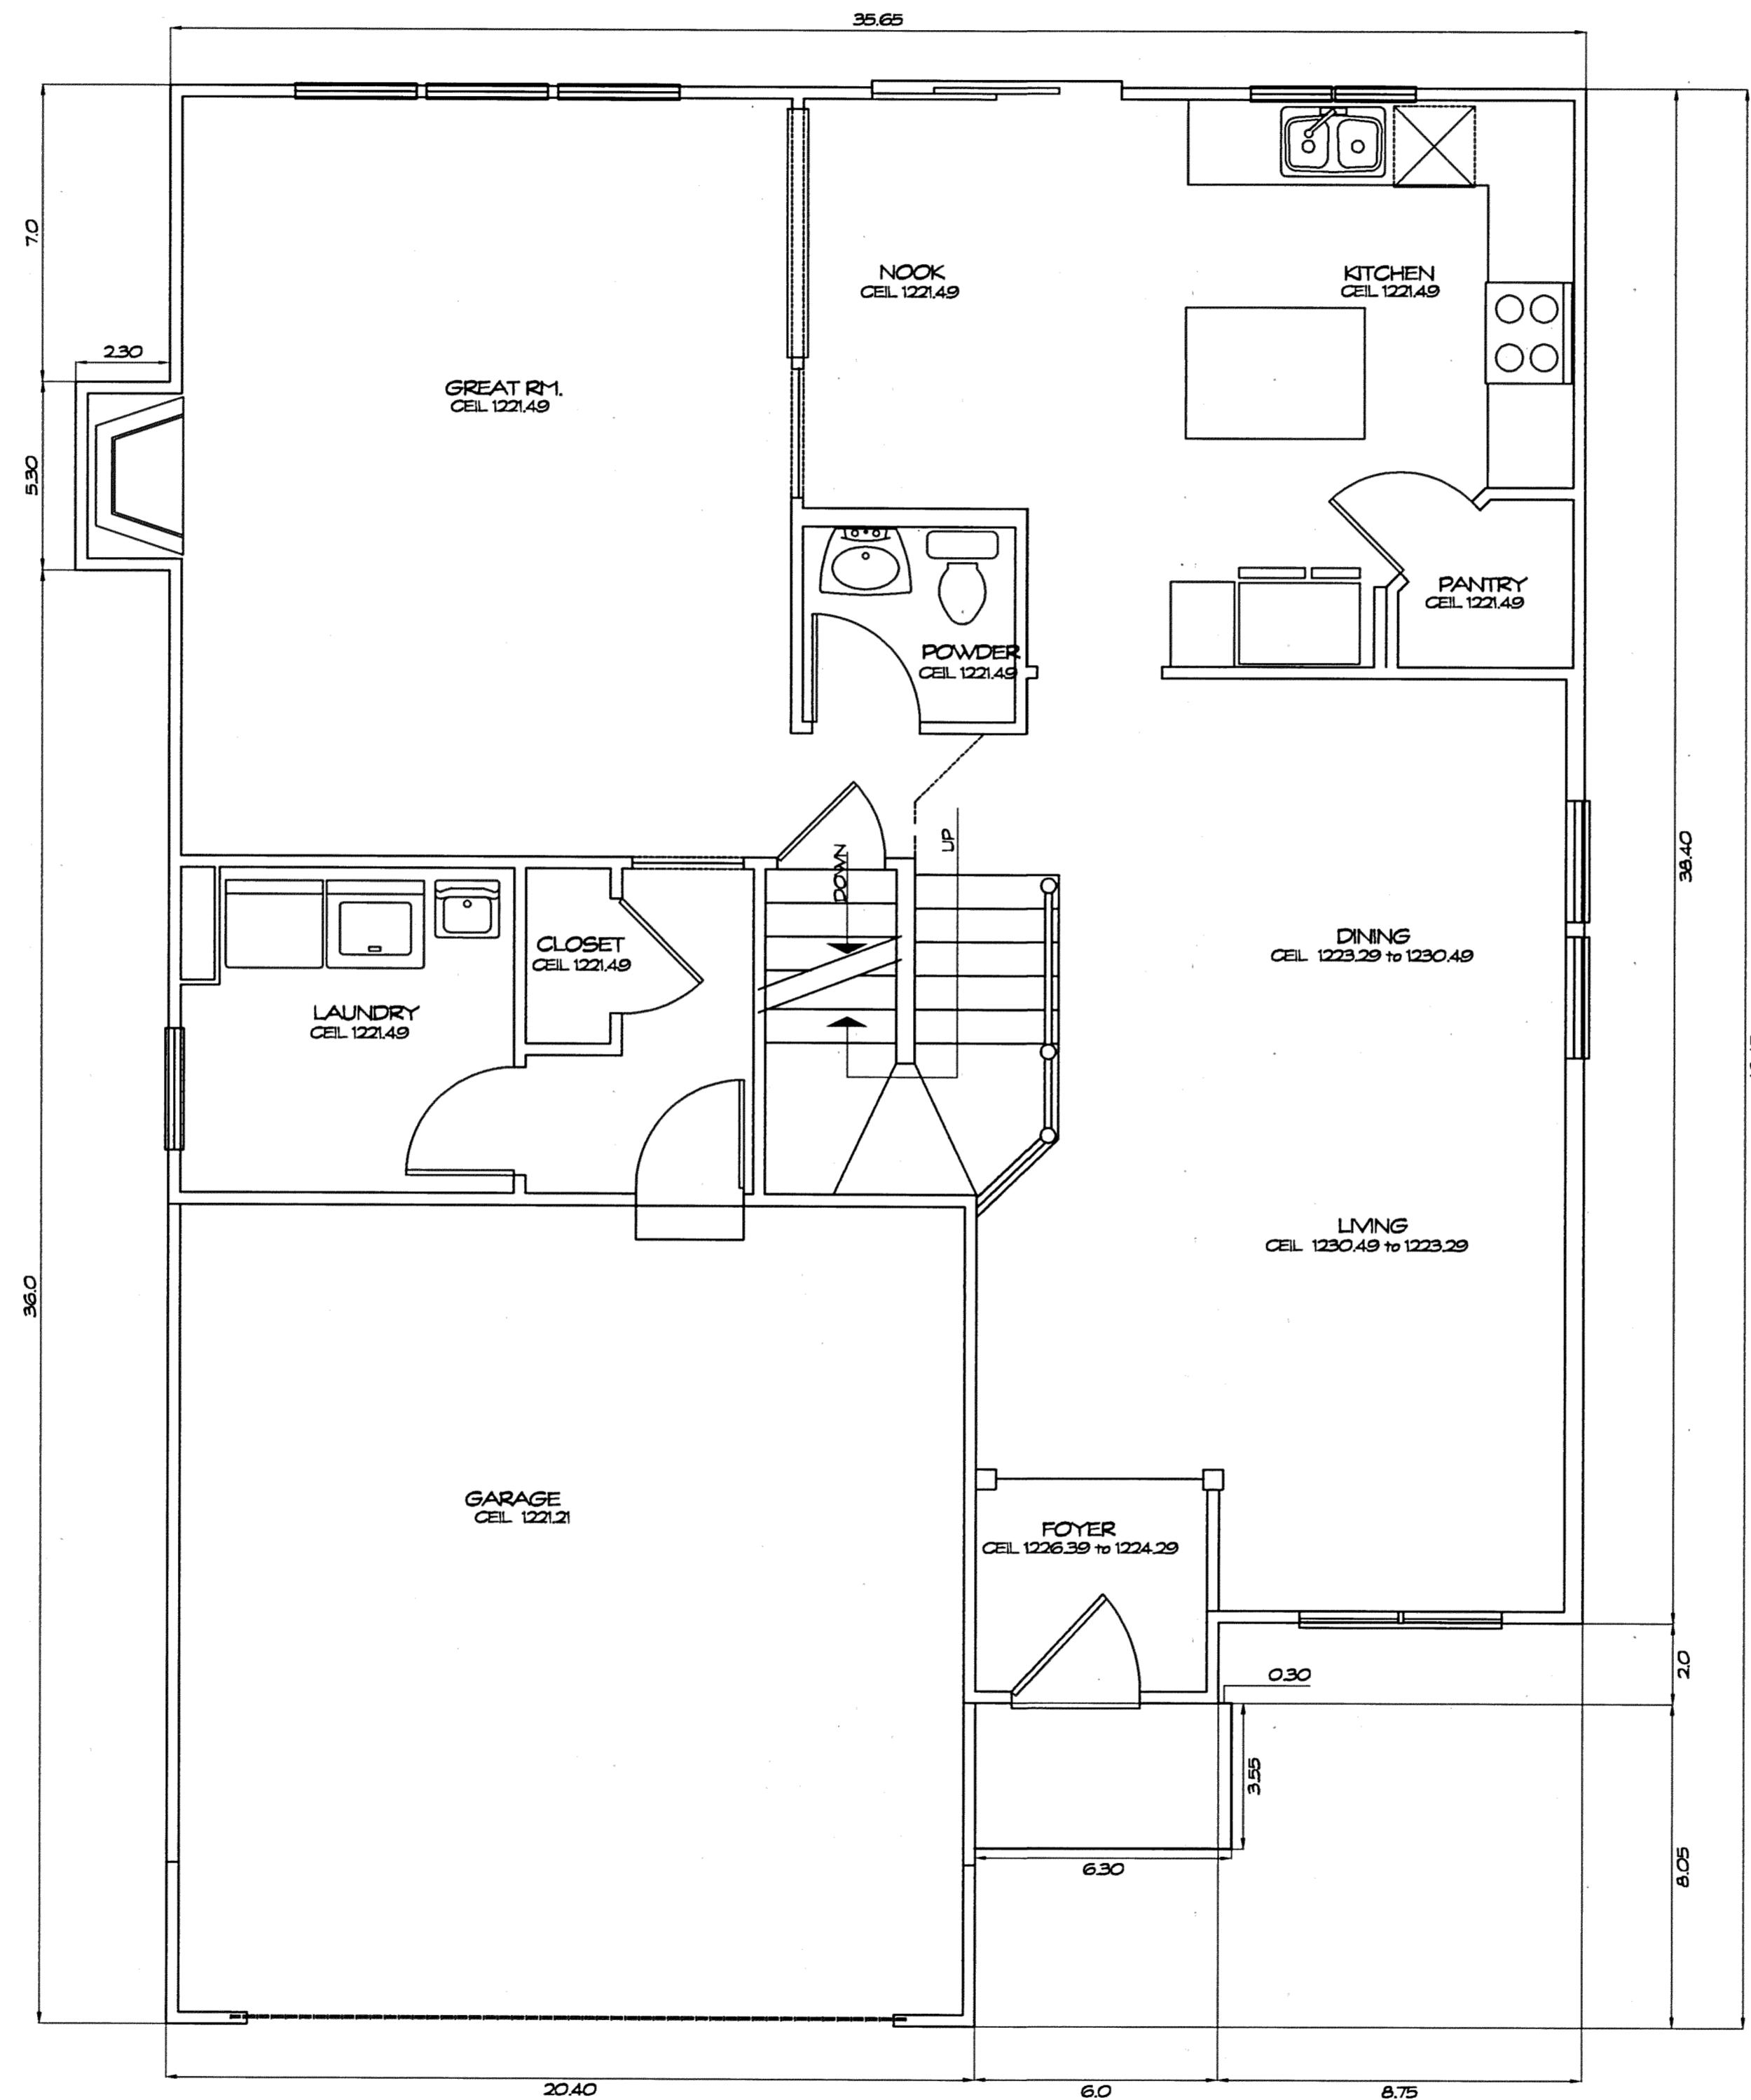


FIRST FLOOR PLAN

1/4" = 1'-0"


UNIT	GARAGE ELEV. FLOOR CEILING	SQ. FT.	BASEMENT ELEV. FLOOR CEILING	SQ. FT.	1ST FLOOR ELEV. FLOOR CEILING	SQ. FT.	2ND FLOOR ELEV. FLOOR CEILING	SQ. FT.	TOTAL SQ. FT.
11	1210.51 / 1221.21	431	1203.61 / 1211.51	1172	1212.49 / See Plan	1194	1222.49 / See Plan	1095	3892

V33 P36

THE UNDERSIGNED HEREBY CERTIFIES THAT THESE DRAWINGS SHOW GRAPHICALLY, IN SO FAR AS POSSIBLE, THE LAYOUT, LOCATION, DESIGNATION, AND DIMENSIONS OF THE COMMON AREAS AND FACILITIES AND LIMITED COMMON AREAS AND FACILITIES OF THE BUILDINGS AS CONSTRUCTED. THE PURPOSE OF THIS CERTIFICATION IS TO COMPLY, IN ALL RESPECTS, WITH THE PROVISIONS OF SECTION 5B 1.07 OF THE OHIO REVISED CODE.

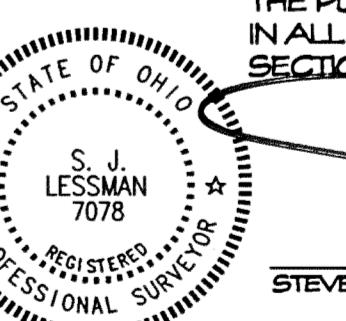

STEVEN J. LESSMAN, PROFESSIONAL SURVEYOR NO. 7078

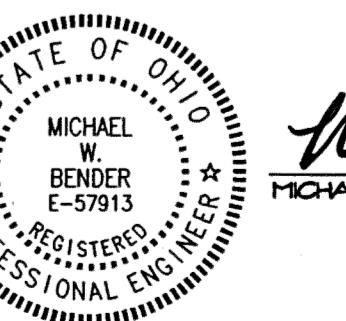

MICHAEL W. BENDER, PROFESSIONAL ENGINEER NO. E-57913


EXHIBIT "A"

DECLARATION OF CONDOMINIUM FOR
AUBURN CROSSINGS

UNIT 11

SCALE: 1/4" = 1'-0" AUGUST, 2001 SHEET 6 OF 25

LESSMAN, BENDER & ASSOCIATES
Engineers - Surveyors - PlannersVillage Station 401 South Street Chardon Ohio 44024
Phone: (440) 286-7204 Fax: (440) 286-3535

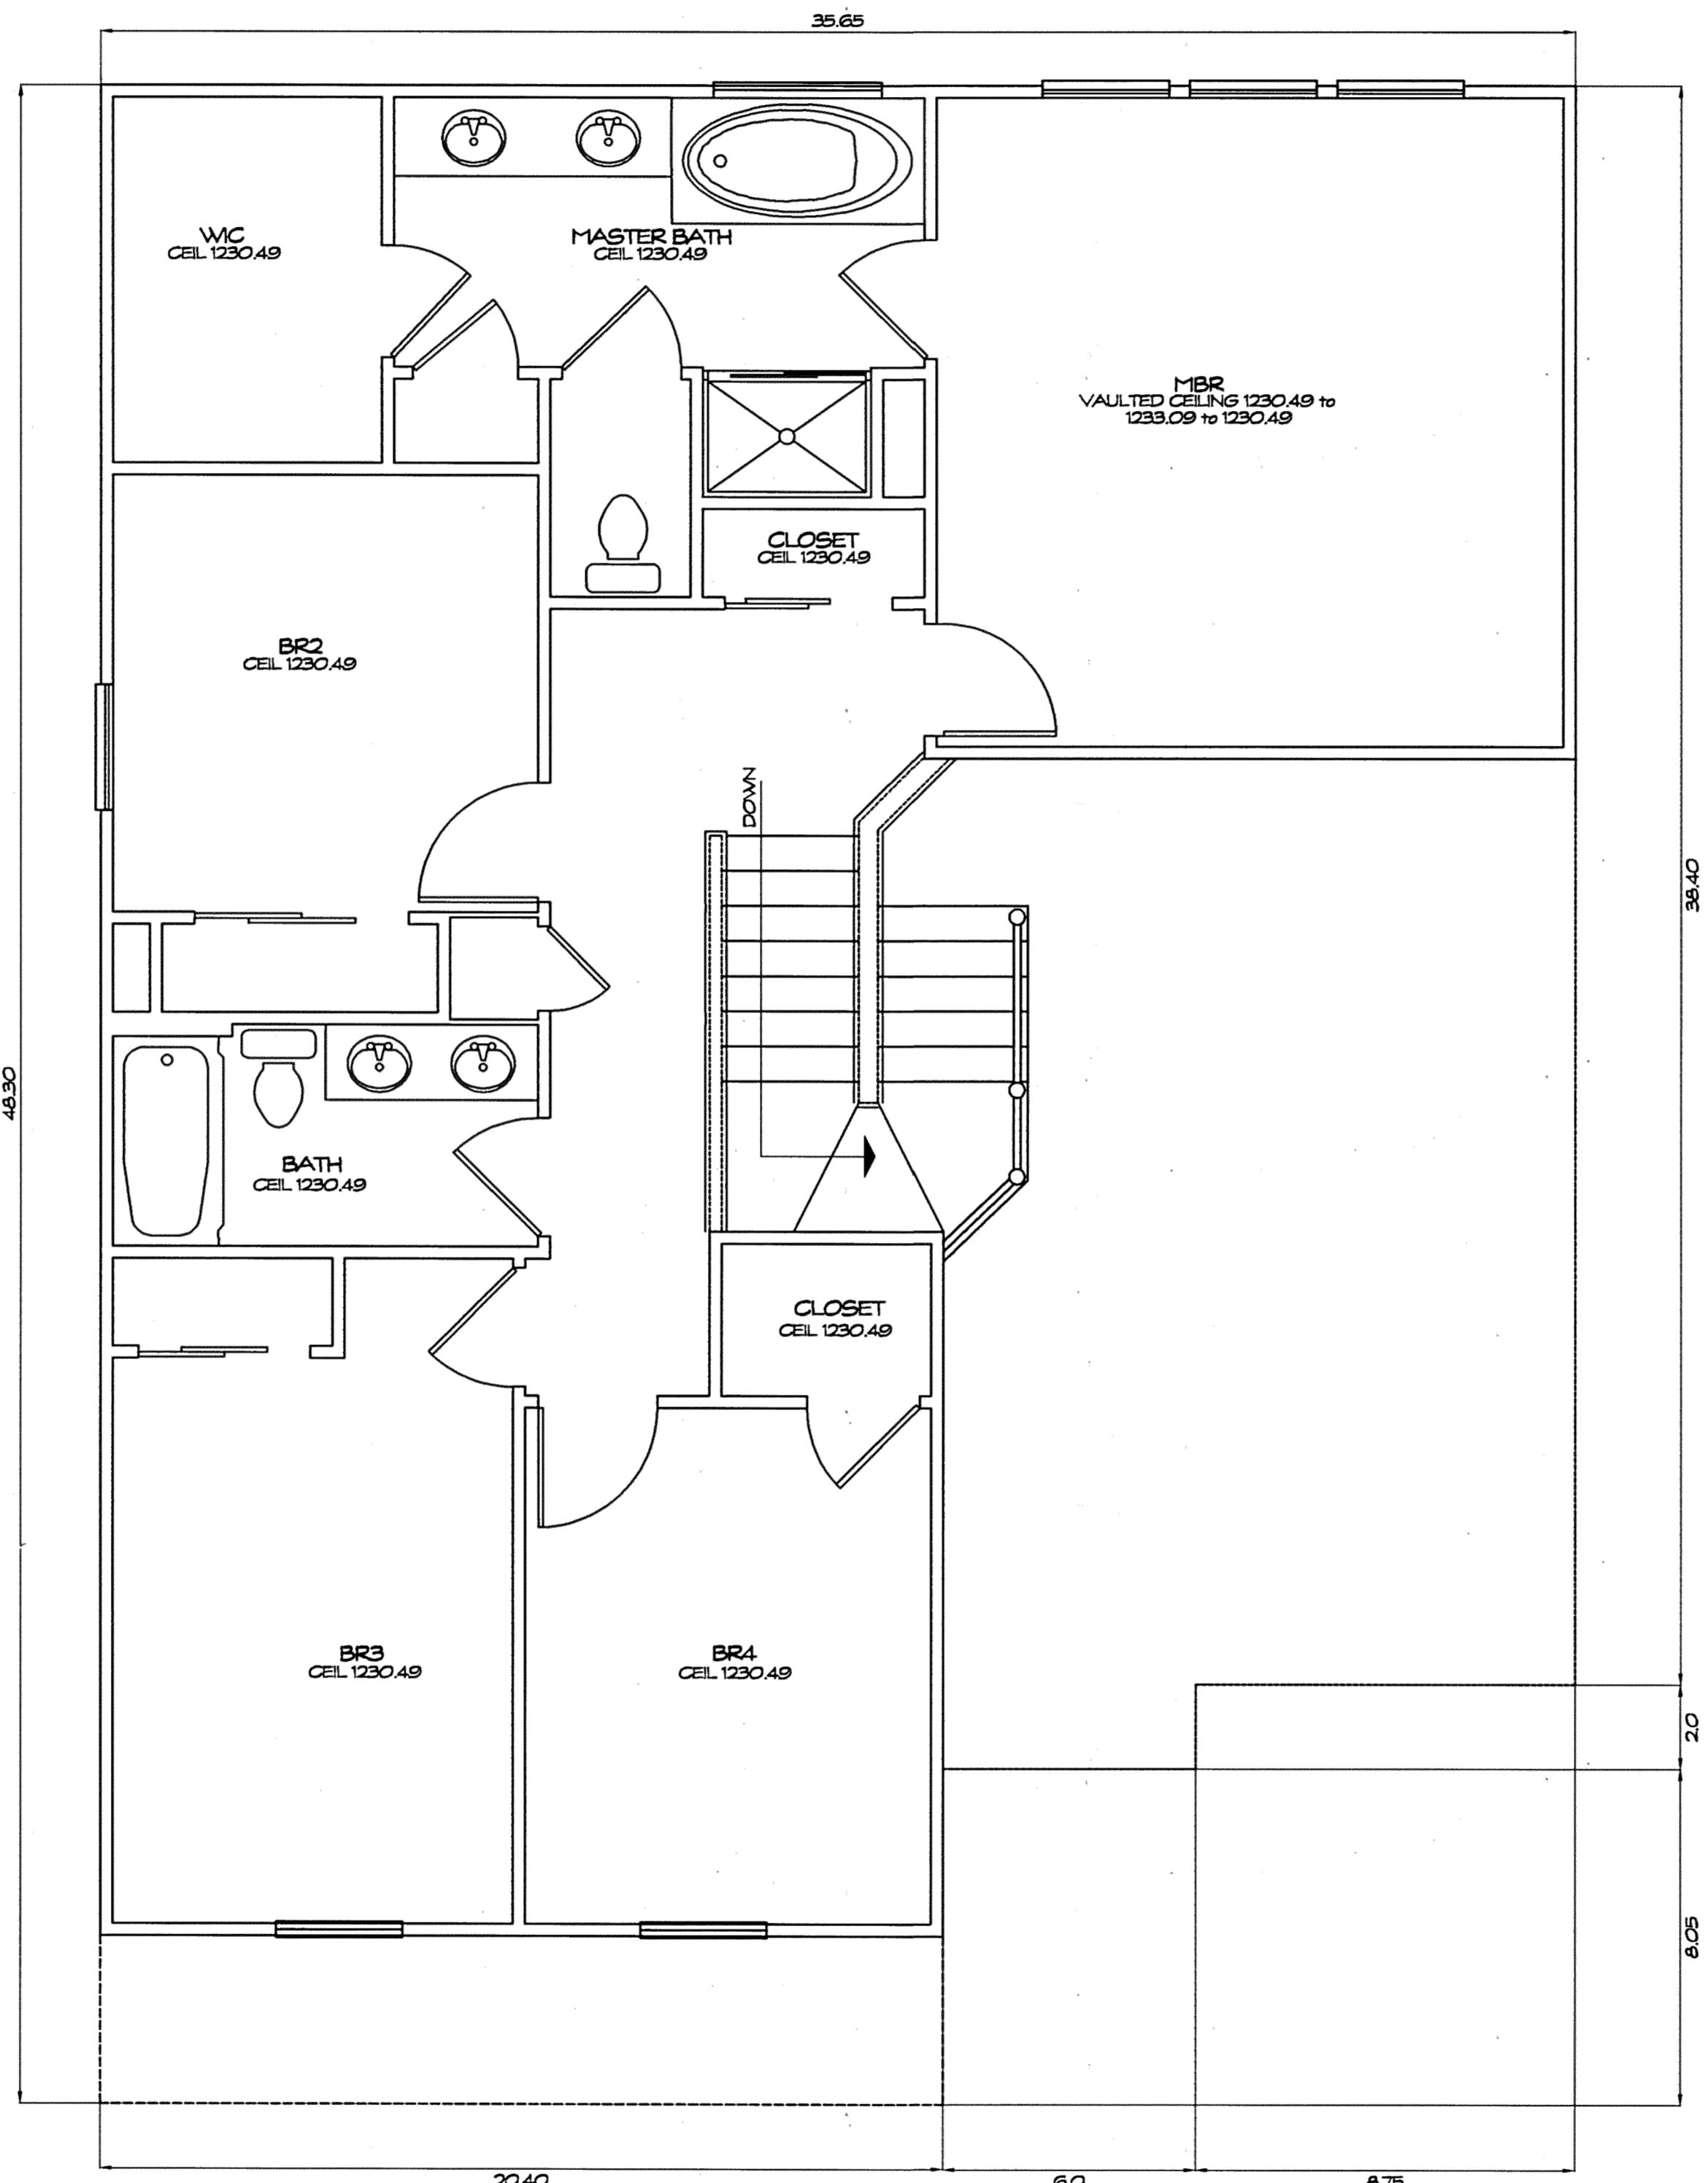


SECOND FLOOR PLAN
 $\frac{1}{4}'' = 1'-0''$

THE UNDERSIGNED HEREBY CERTIFIES THAT THESE DRAWINGS SHOW GRAPHICALLY, IN SO FAR AS POSSIBLE, THE LAYOUT, LOCATION, DESIGNATION, AND DIMENSIONS OF THE COMMON AREAS AND FACILITIES AND LIMITED COMMON AREAS AND FACILITIES OF THE BUILDINGS AS CONSTRUCTED. THE PURPOSE OF THIS CERTIFICATION IS TO COMPLY, IN ALL RESPECTS, WITH THE PROVISIONS OF SECTION 5311.07 OF THE OHIO REVISED CODE.



STEVEN J. LESSMAN, PROFESSIONAL SURVEYOR NO. 7078

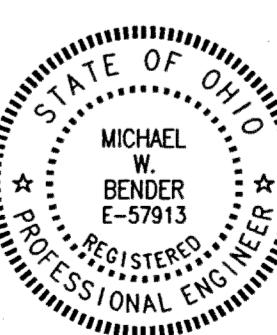

STEVEN J. LESSMAN, PROFESSIONAL SURVEYOR NO. 7078

EXHIBIT "A"


DECLARATION OF CONDOMINIUM FOR
AUBURN CROSSINGS

UNIT 11

SCALE: $\frac{1}{4}'' = 1'-0''$ | AUGUST, 2001 | SHEET 7 OF 25

LESSMAN, BENDER & ASSOCIATES
Engineers - Surveyors - Planners


Village Station 401 South Street Chardon OH 44024
Phone: (440) 286-7204 Fax: (440) 286-3535

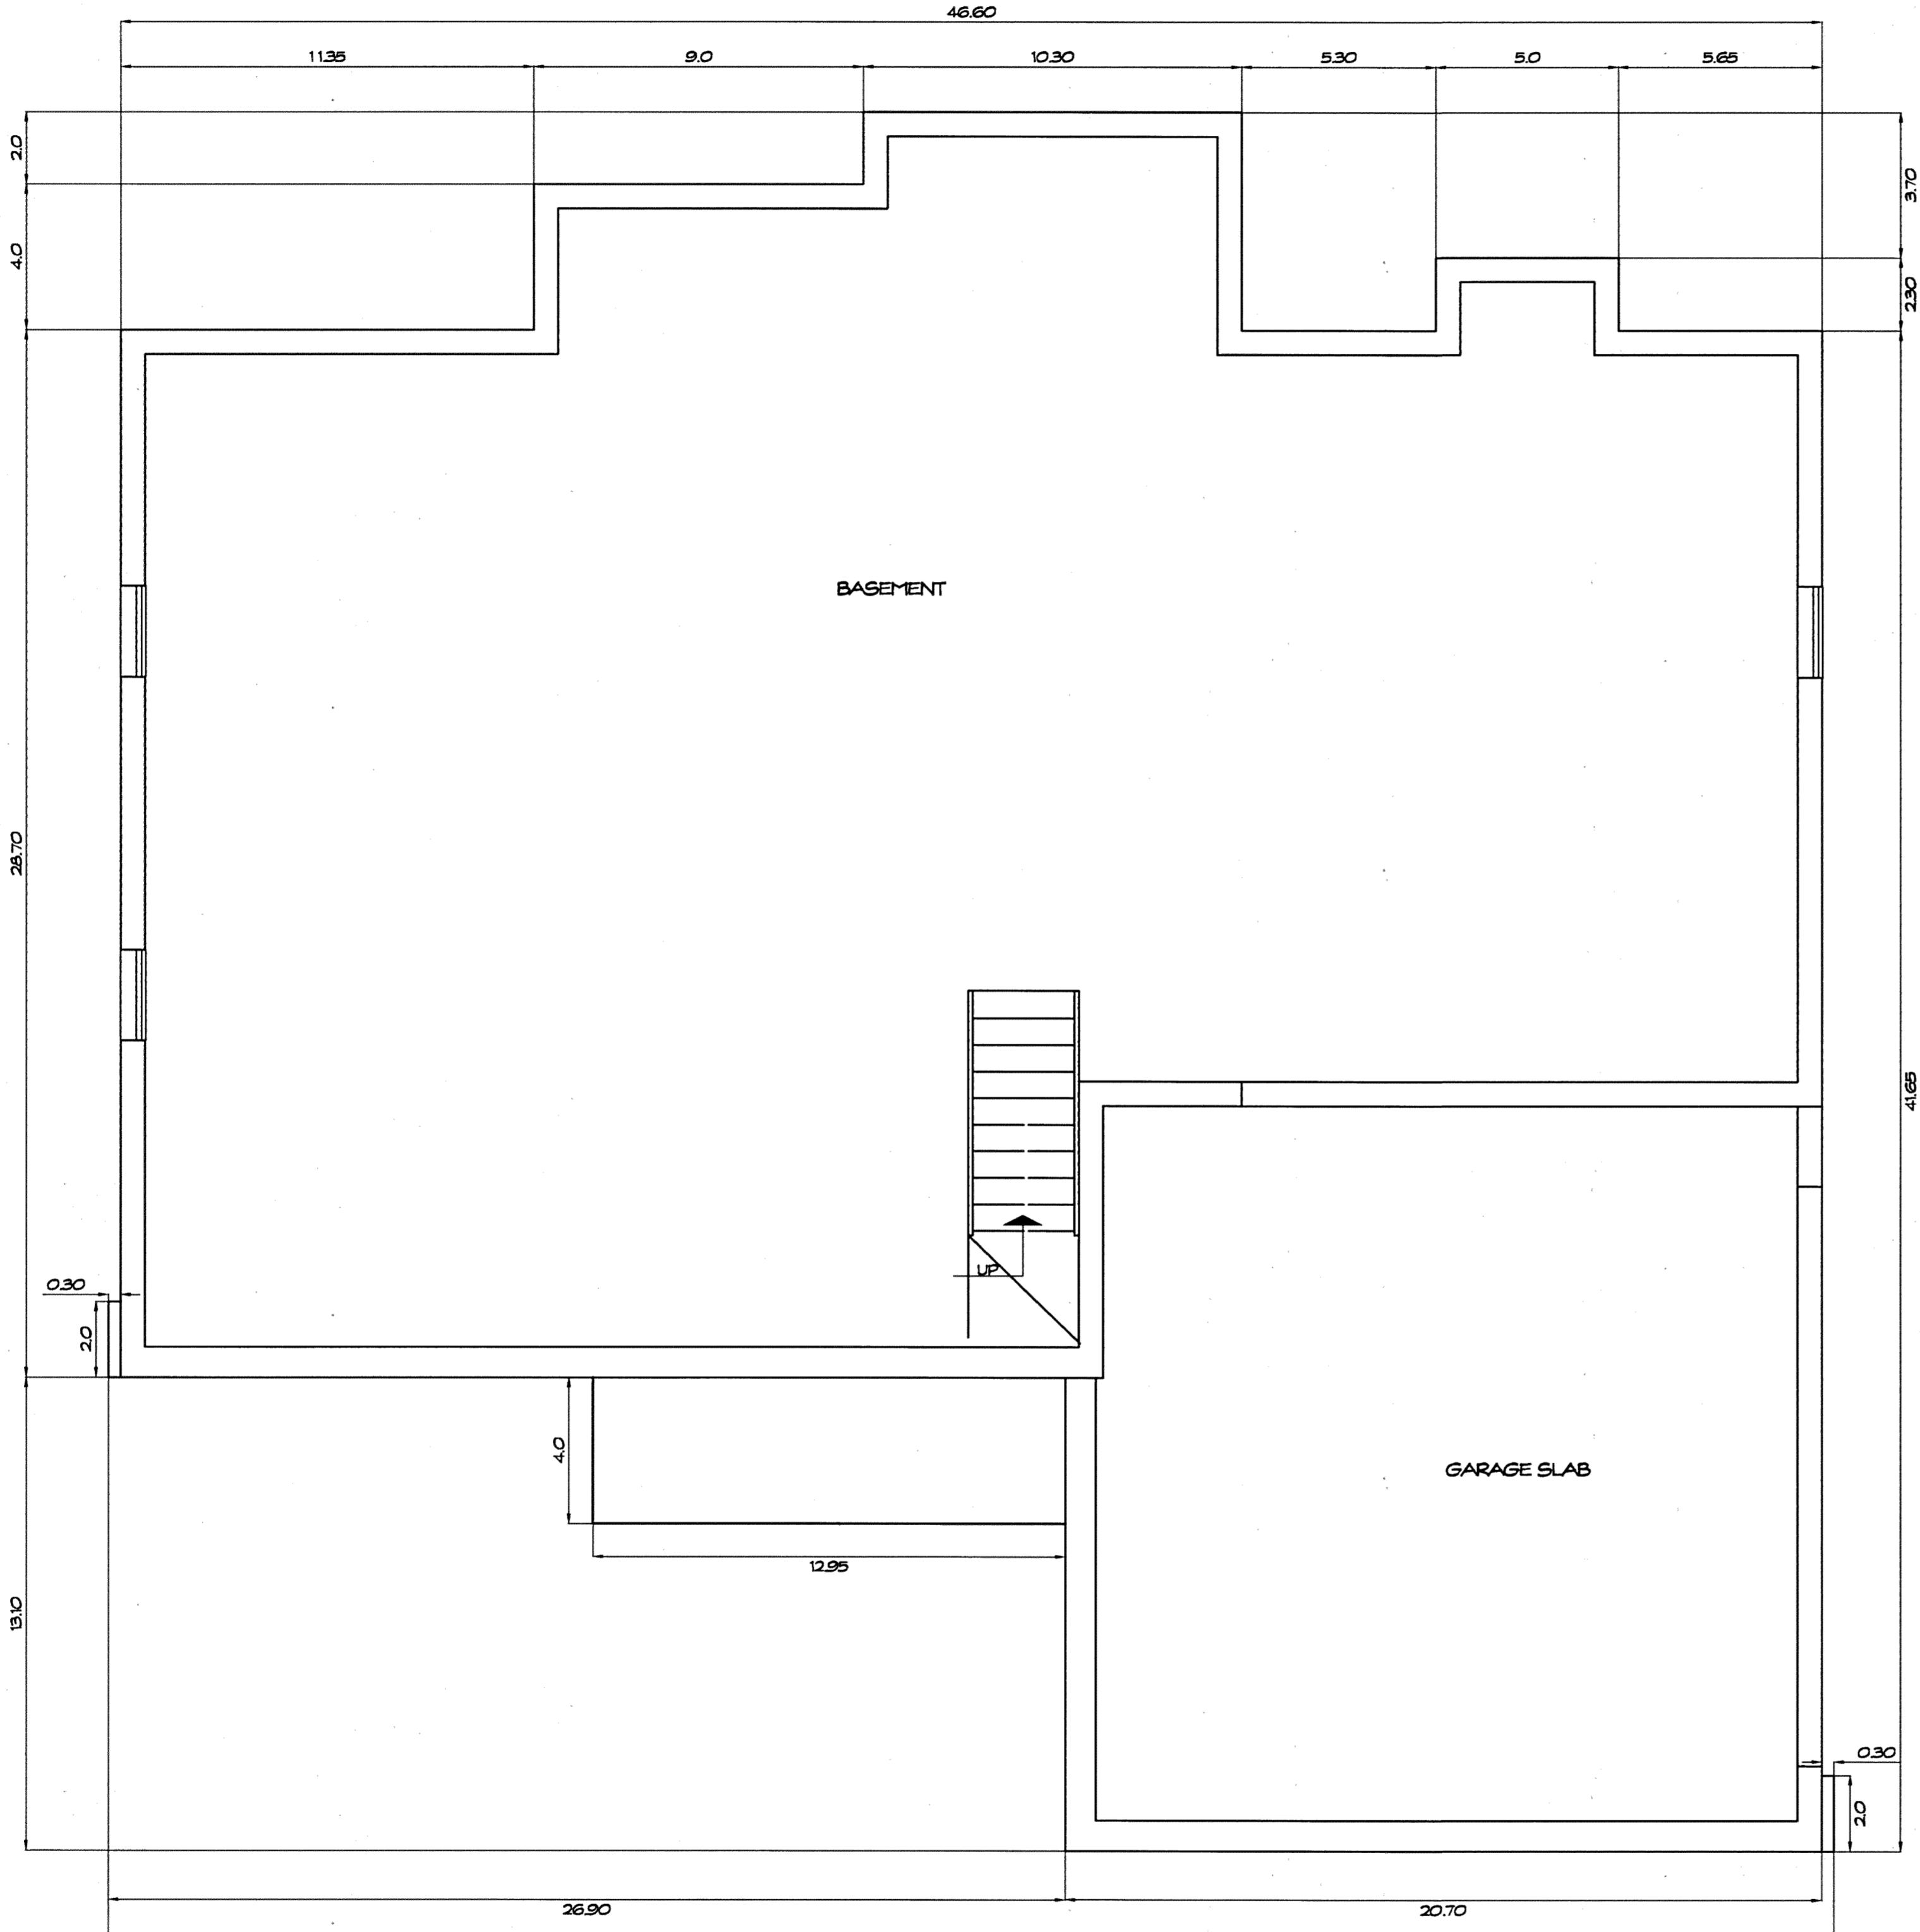


FOUNDATION PLAN

SCALE: 1/4" = 1'-0"

THE UNDERSIGNED HEREBY CERTIFIES THAT THESE DRAWINGS SHOW GRAPHICALLY, IN SO FAR AS POSSIBLE, THE LAYOUT, LOCATION, DESIGNATION, AND DIMENSIONS OF THE COMMON AREAS AND FACILITIES AND LIMITED COMMON AREAS AND FACILITIES OF THE BUILDINGS AS CONSTRUCTED. THE PURPOSE OF THIS CERTIFICATION IS TO COMPLY, IN ALL RESPECTS, WITH THE PROVISIONS OF SECTION 4507 OF THE OHIO REVISED CODE.

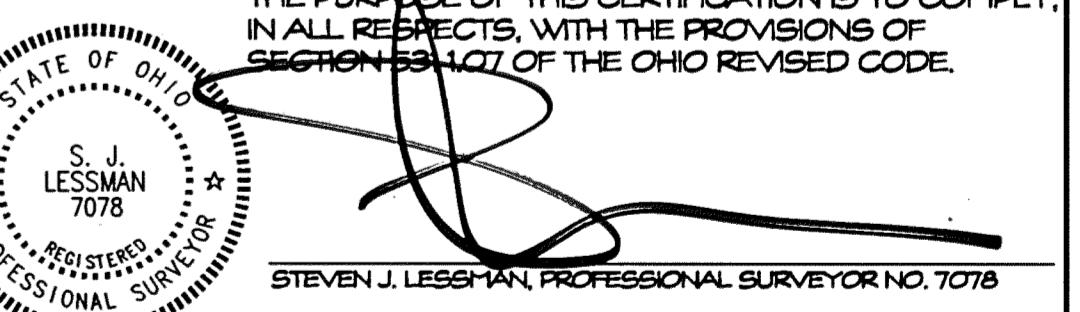

STEVEN J. LESSMAN, PROFESSIONAL SURVEYOR NO. 7078

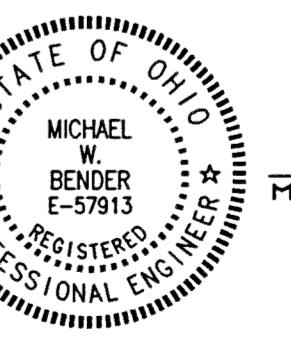

MICHAEL W. BENDER, PROFESSIONAL ENGINEER NO. E-57913

EXHIBIT "A"

**DECLARATION OF CONDOMINIUM FOR
AUBURN CROSSINGS**

UNIT 12

SCALE: 1/4" = 1'-0" | AUGUST, 2001 | SHEET 8 OF 25

**LESSMAN, BENDER & ASSOCIATES
Engineers - Surveyors - Planners**

Village Station 401 South Street Chardon Ohio 44024
Phone: (440) 286-7204 Fax: (440) 286-3535

V33 P38




UNIT	GARAGE ELEV.		BASEMENT ELEV.		1ST FLOOR ELEV.		2ND FLOOR ELEV.		TOTAL SQ.FT.				
	FLOOR	CEILING	SQ. FT.	FLOOR	CEILING	SQ. FT.	FLOOR	CEILING	SQ. FT.				
12	1210.95	1222.25	429	1204.18	1211.98	1284	1213.21	See Plan	1336	1223.36	See Plan	1260	4309


FAM. RM. FLR. 1212.51

V33 P39

THE UNDERSIGNED HEREBY CERTIFIES THAT THESE DRAWINGS SHOW GRAPHICALLY, IN SO FAR AS POSSIBLE, THE LAYOUT, LOCATION, DESIGNATION, AND DIMENSIONS OF THE COMMON AREAS AND FACILITIES AND LIMITED COMMON AREAS AND FACILITIES OF THE BUILDINGS AS CONSTRUCTED. THE PURPOSE OF THIS CERTIFICATION IS TO COMPLY, IN ALL RESPECTS, WITH THE PROVISIONS OF SECTION 5311.07 OF THE OHIO REVISED CODE.

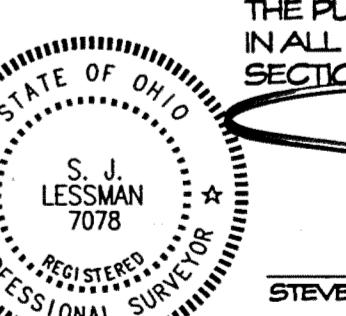

STEVEN J. LESSMAN, PROFESSIONAL SURVEYOR NO. 7078

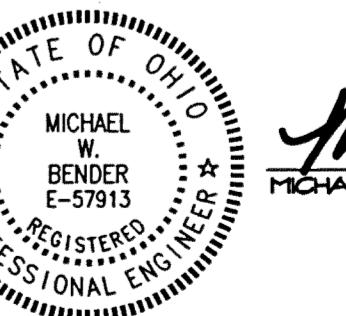

MICHAEL W. BENDER, PROFESSIONAL ENGINEER NO. E-5793


EXHIBIT "A"

DECLARATION OF CONDOMINIUM FOR AUBURN CROSSINGS



UNIT 12

SCALE: 1/4" = 1'-0" AUGUST, 2001 SHEET 9 OF 25

LESSMAN, BENDER & ASSOCIATES
Engineers - Surveyors - PlannersVillage Station 401 South Street Chardon Ohio 44024
Phone: (440) 286-7204 Fax: (440) 286-3535

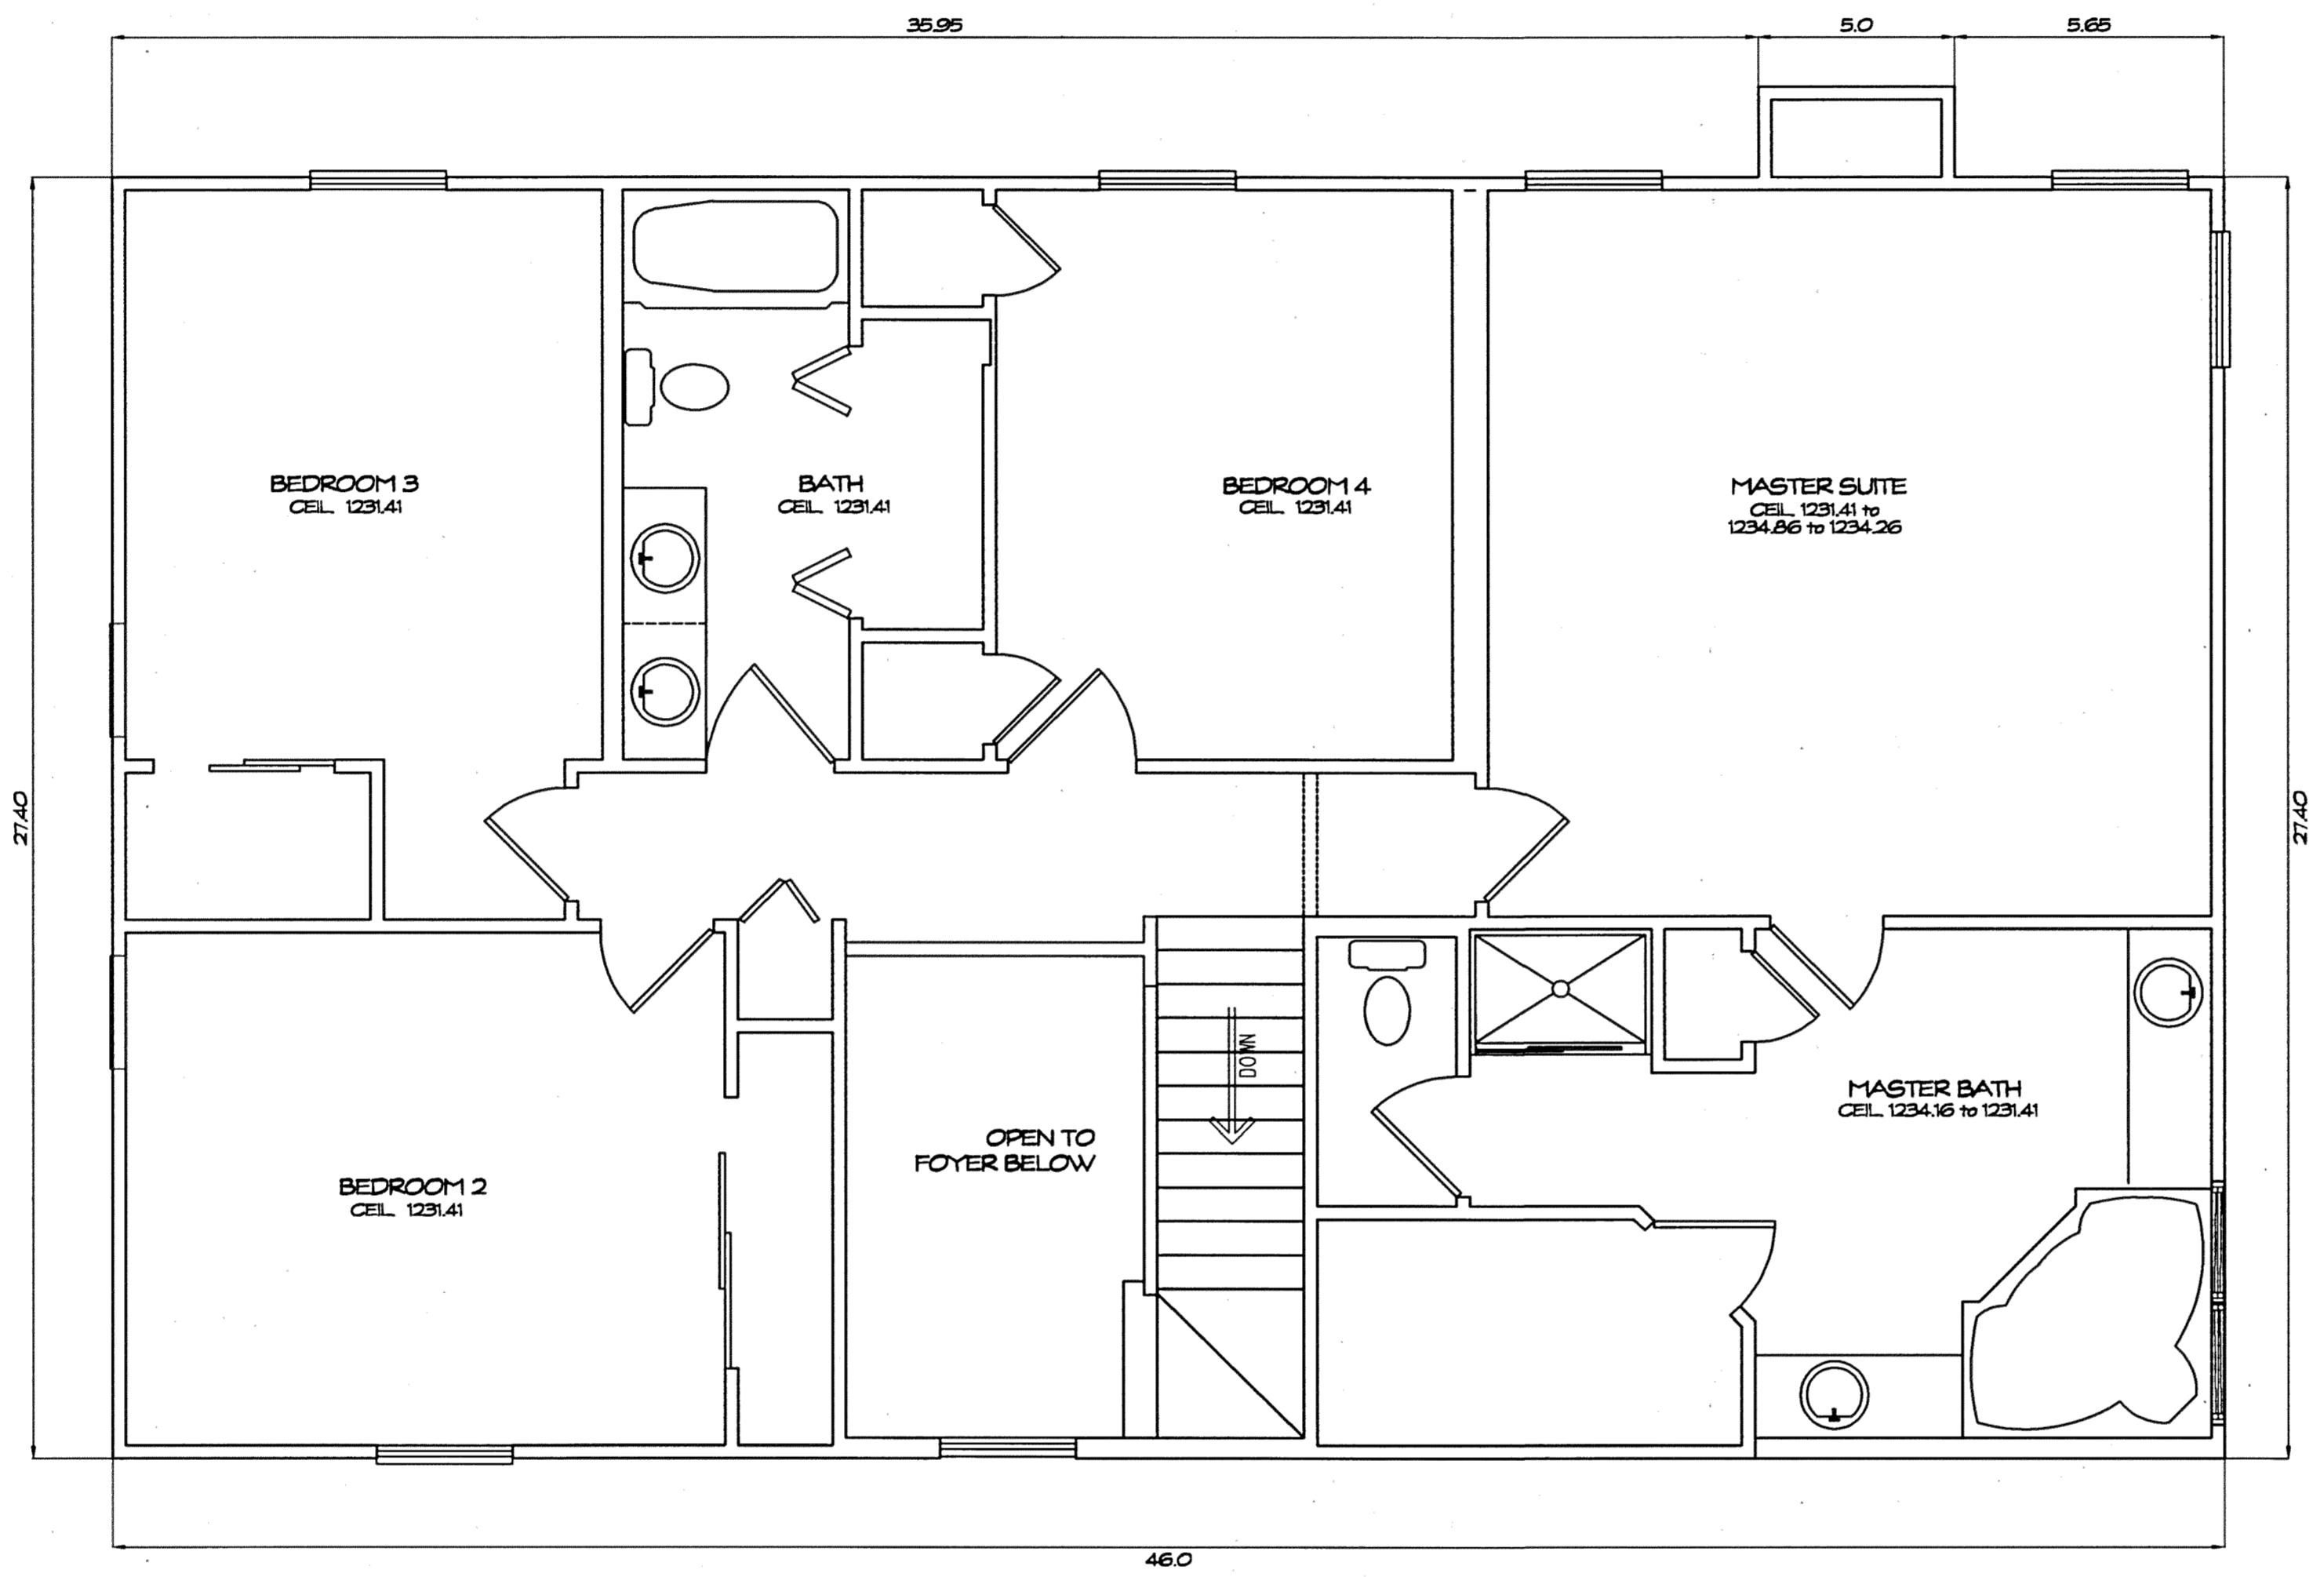


THE UNDERSIGNED HEREBY CERTIFIES THAT THESE DRAWINGS SHOW GRAPHICALLY, INsofar AS POSSIBLE, THE LAYOUT, LOCATION, DESIGNATION, AND DIMENSIONS OF THE COMMON AREAS AND FACILITIES AND LIMITED COMMON AREAS AND FACILITIES OF THE BUILDINGS AS CONSTRUCTED. THE PURPOSE OF THIS CERTIFICATION IS TO COMPLY, IN ALL RESPECTS, WITH THE PROVISIONS OF SECTION 5311.07 OF THE OHIO REVISED CODE.

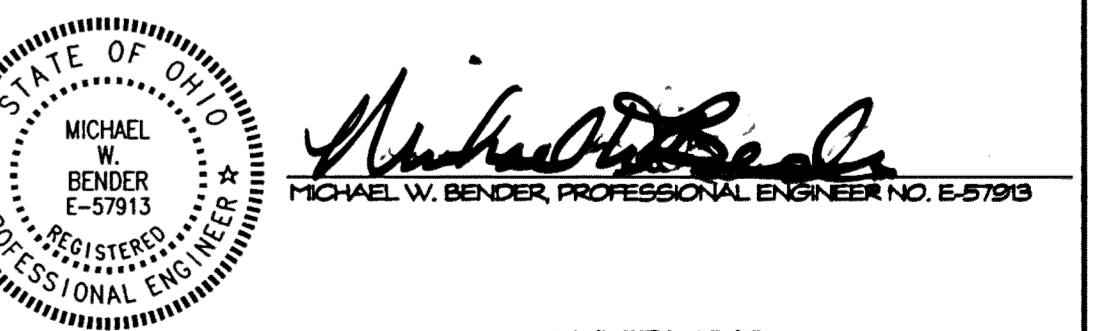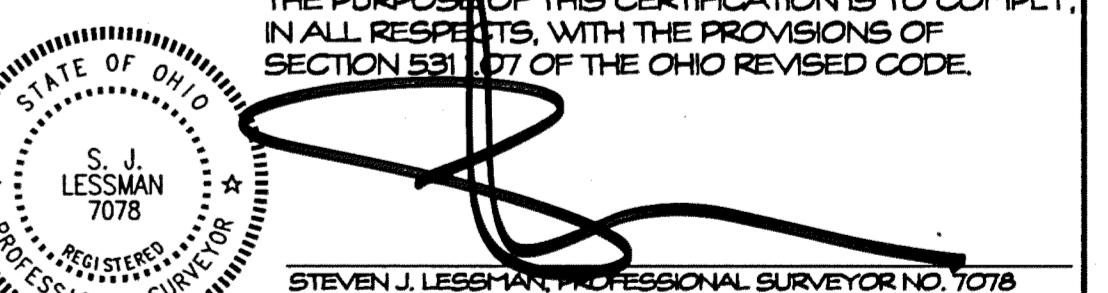

Michael W. Bender

EXHIBIT "A"
DECLARATION OF CONDOMINIUM FOR
AUBURN CROSSINGS
UNIT 12
SCALE: 1/4" = 1'-0" AUGUST, 2001 SHEET 10 OF 25
LESSMAN, BENDER & ASSOCIATES
Engineers - Surveyors - Planners
Village Station 401 South Street Chardon Ohio 44024
Phone: (440) 286-7204 Fax: (440) 286-3335

V33 P40

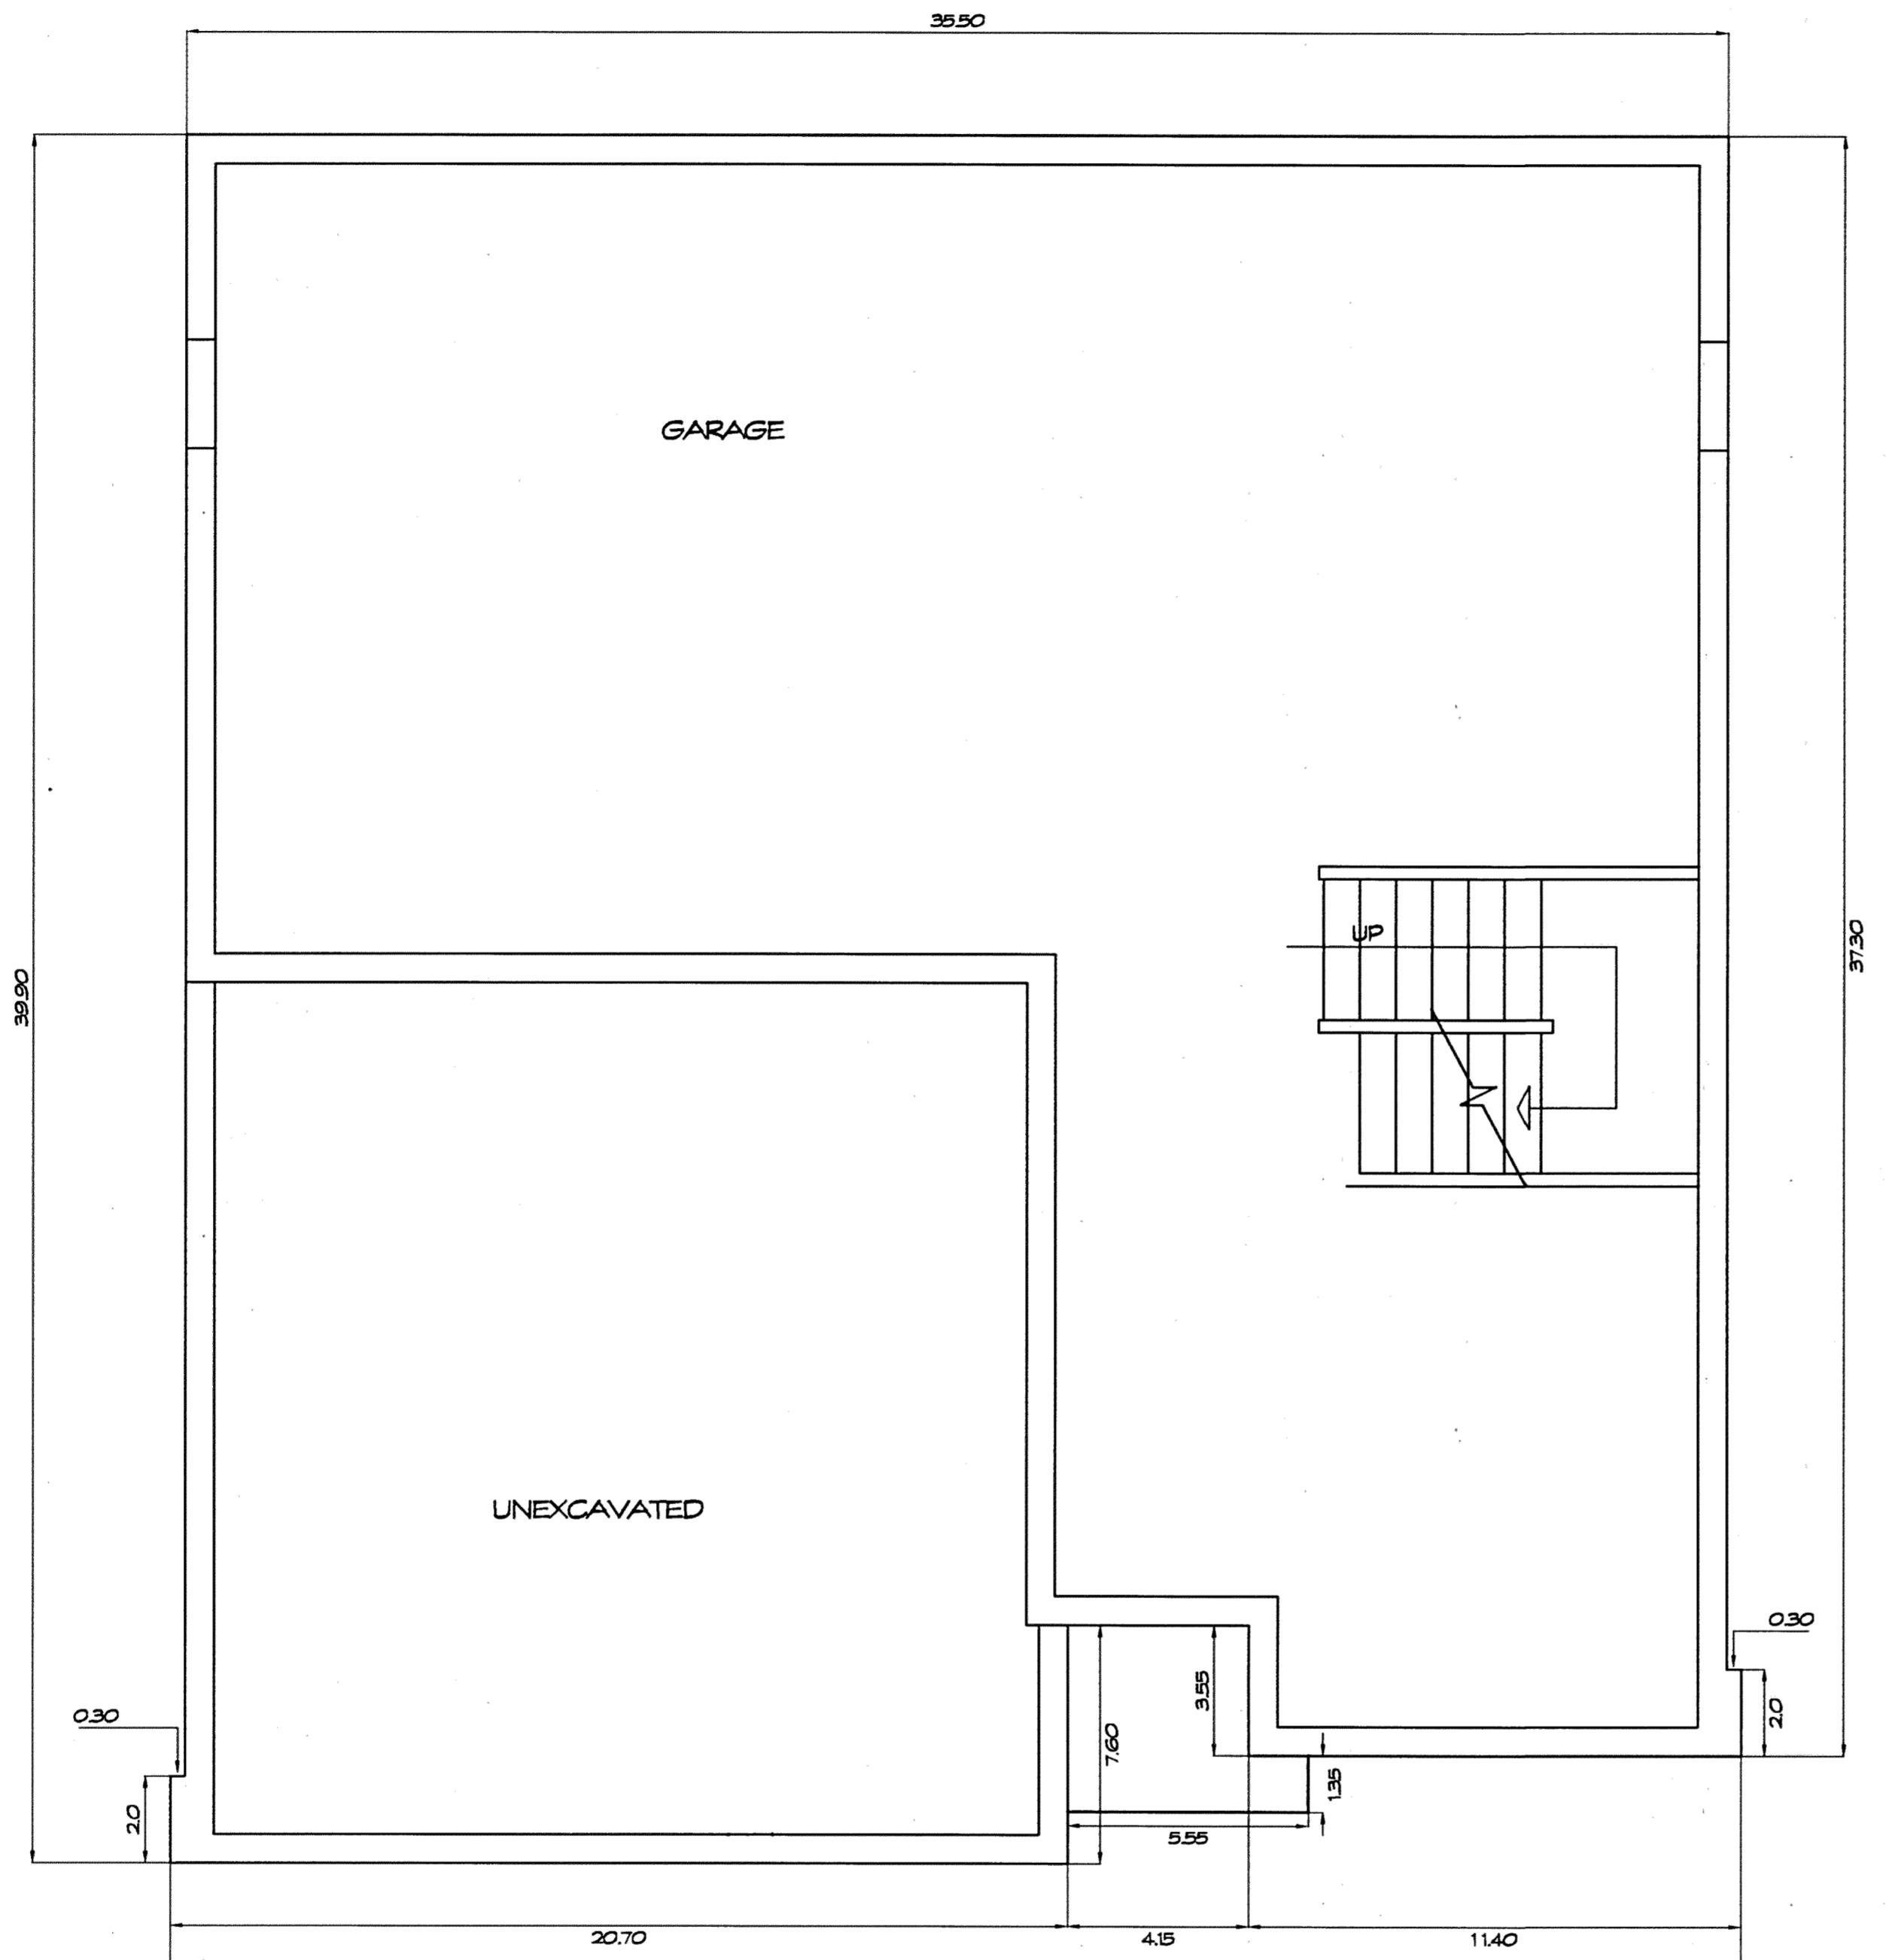
FOUNDATION PLAN

1/4" = 1'-0"

THE UNDERSIGNED HEREBY CERTIFIES THAT THESE DRAWINGS SHOW GRAPHICALLY, INsofar AS POSSIBLE, THE LAYOUT, LOCATION, DESIGNATION, AND DIMENSIONS OF THE COMMON AREAS AND FACILITIES AND LIMITED COMMON AREAS AND FACILITIES OF THE BUILDINGS AS CONSTRUCTED. THE PURPOSE OF THIS CERTIFICATION IS TO COMPLY, IN ALL RESPECTS, WITH THE PROVISIONS OF SECTION 53107 OF THE OHIO REVISED CODE.



STEVEN J. LESSMAN, PROFESSIONAL SURVEYOR NO. 7078

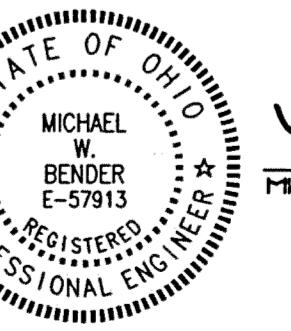

MICHAEL W. BENDER, PROFESSIONAL ENGINEER NO. E-57913

EXHIBIT "A"


DECLARATION OF CONDOMINIUM FOR
AUBURN CROSSINGS

UNIT 31

SCALE: 1/4" = 1'-0" AUGUST, 2001 SHEET 11 OF 25

LESSMAN, BENDER & ASSOCIATES
Engineers - Surveyors - Planners401 South Street Chardon Ohio 44024
Phone: (440) 286-7204 Fax: (440) 286-3535

V33-P41

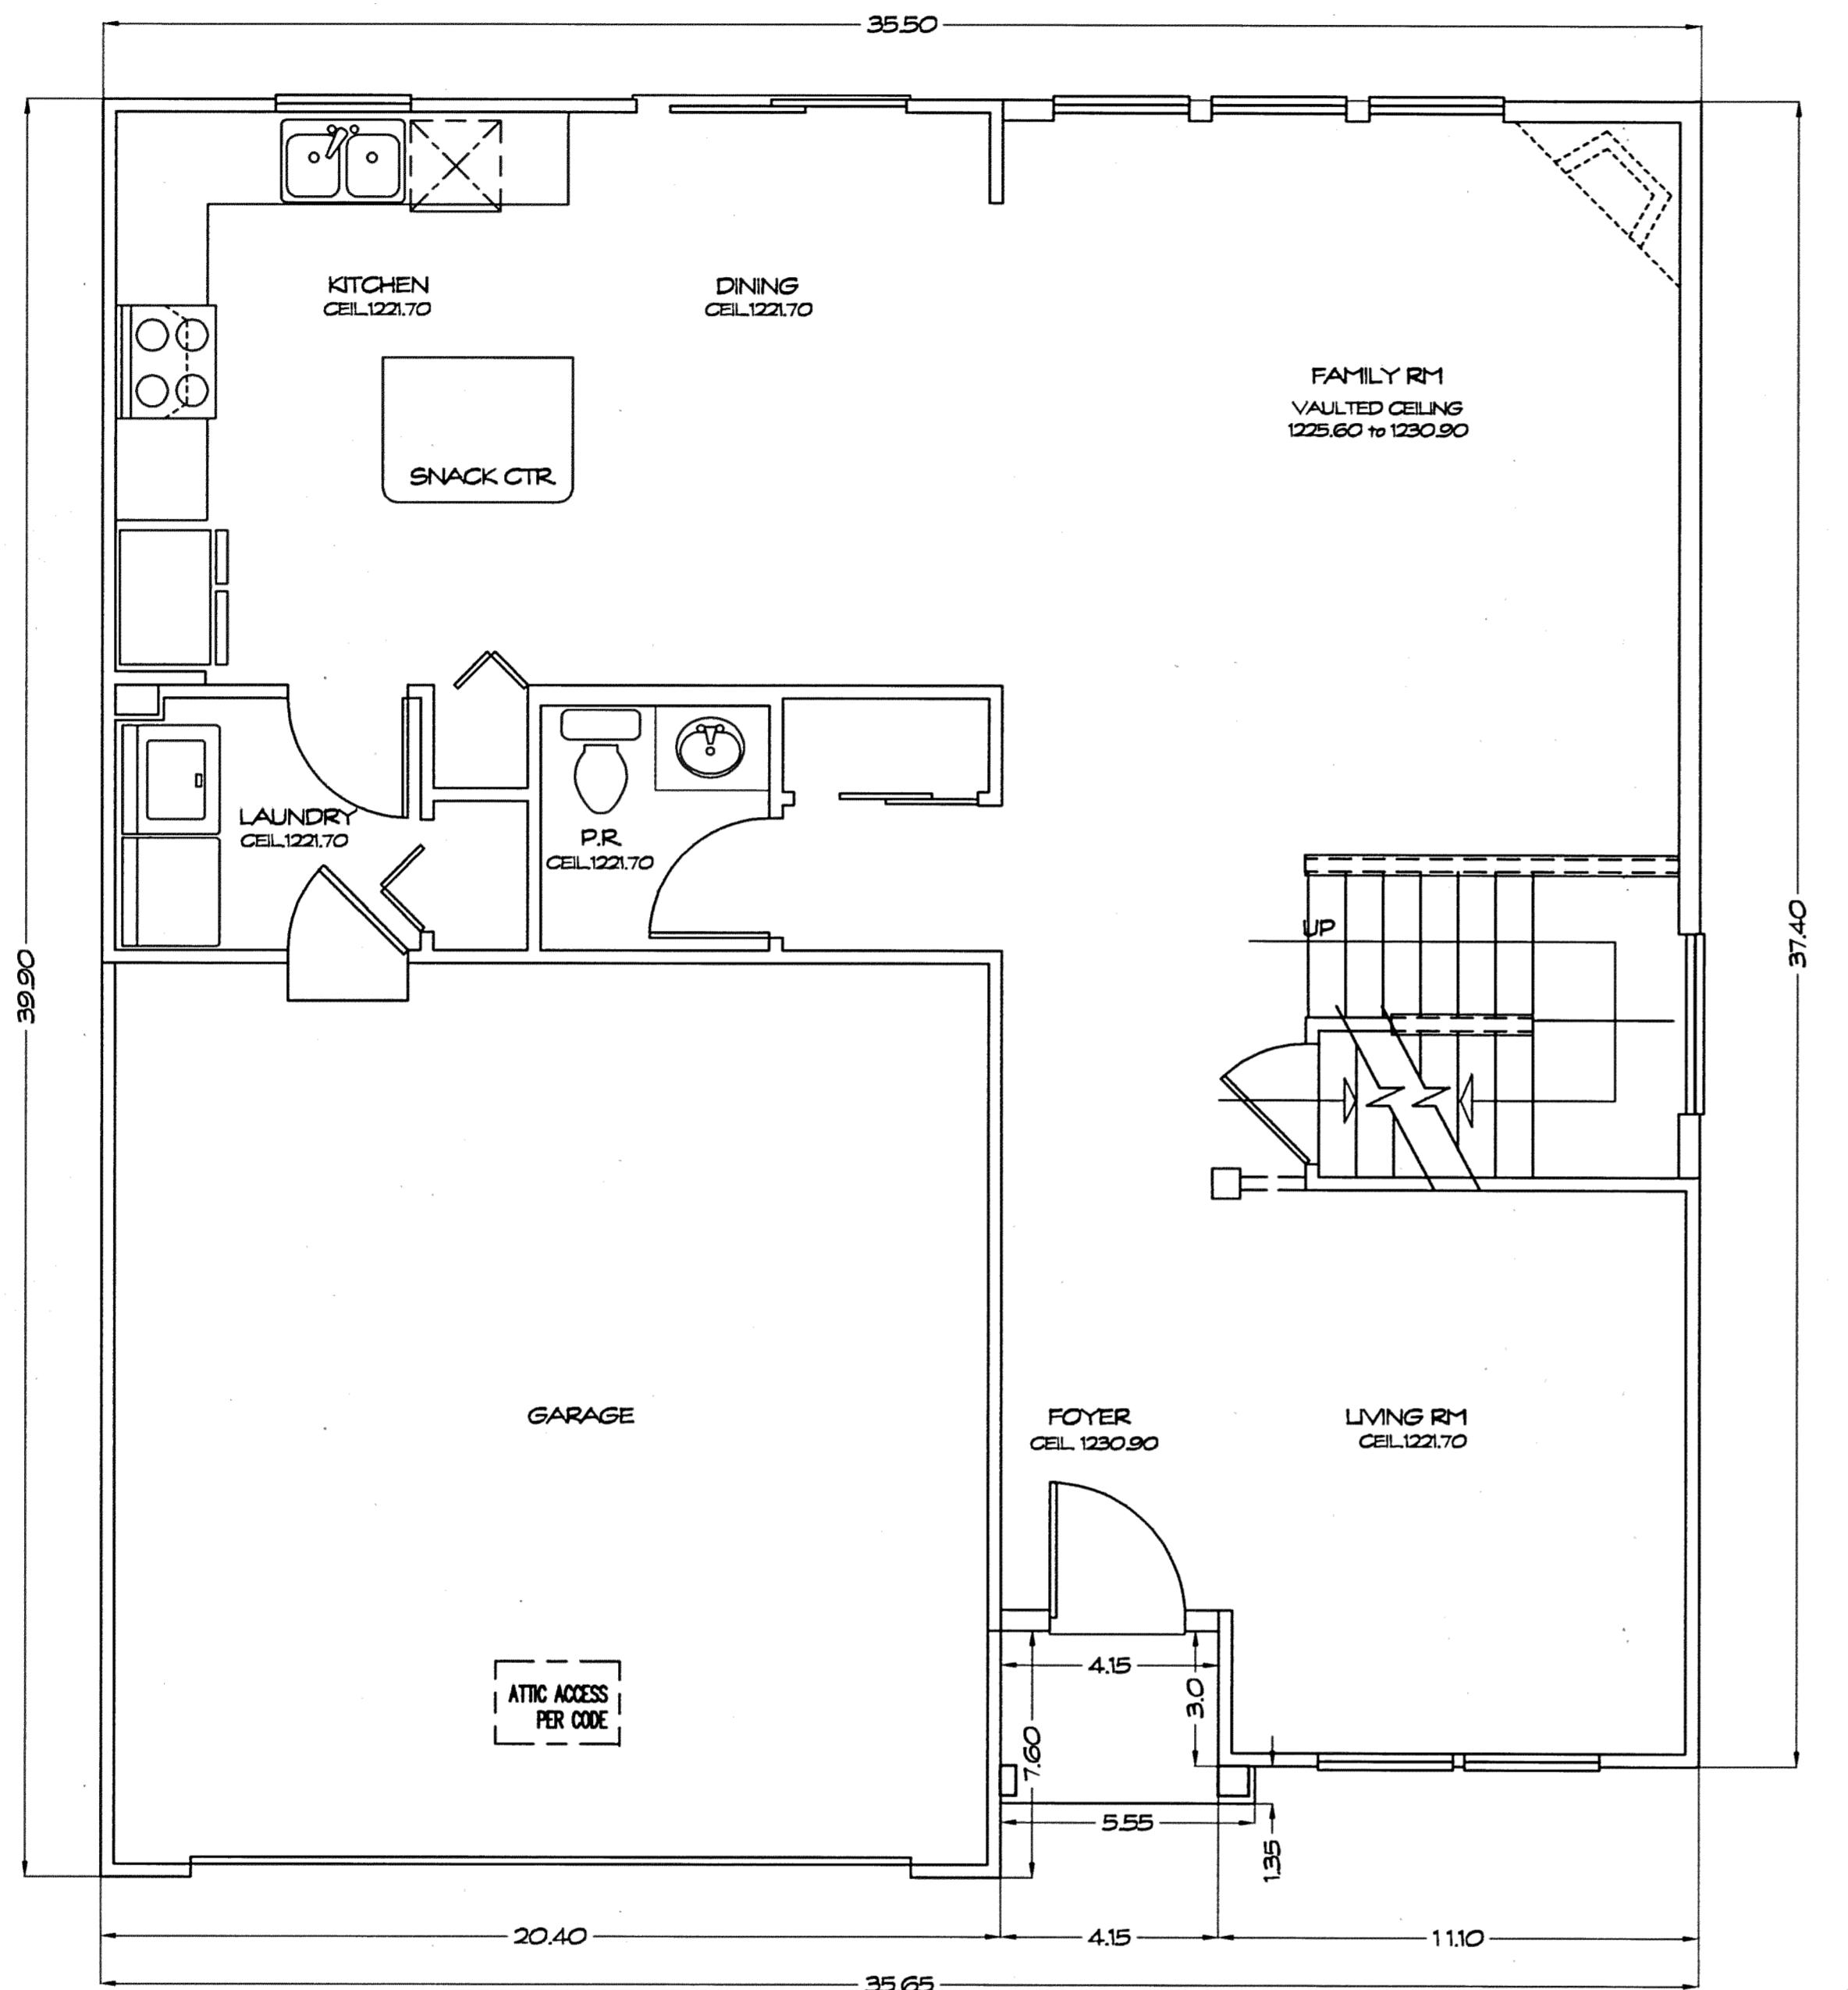


FIRST FLOOR PLAN


$\frac{1}{4}'' = 1'-0''$

UNIT	GARAGE ELEV.		BASEMENT ELEV.	SQ. FT.		1ST FLOOR ELEV.	SQ. FT.		2ND FLOOR ELEV.	SQ. FT.		TOTAL SQ. FT.	
	FLOOR	CEILING		FLOOR	CEILING		FLOOR	CEILING		FLOOR	CEILING		
31	12'11.43	12'21.63	422	12'04.65	12'12.45	9'11	12'13.70	See Plan	9'11	12'22.90	See Plan	12'04	3460

THE UNDERSIGNED HEREBY CERTIFIES THAT THESE DRAWINGS SHOW GRAPHICALLY, IN SO FAR AS POSSIBLE, THE LAYOUT, LOCATION, DESIGNATION, AND DIMENSIONS OF THE COMMON AREAS AND FACILITIES AND LIMITED COMMON AREAS AND FACILITIES OF THE BUILDINGS AS CONSTRUCTED. THE PURPOSE OF THIS CERTIFICATION IS TO COMPLY, IN ALL RESPECTS, WITH THE PROVISIONS OF SECTION 531107 OF THE OHIO REVISED CODE.

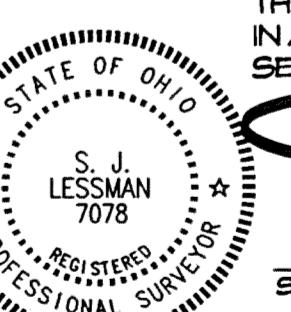

STEVEN J. LESSMAN, PROFESSIONAL SURVEYOR NO. 7078

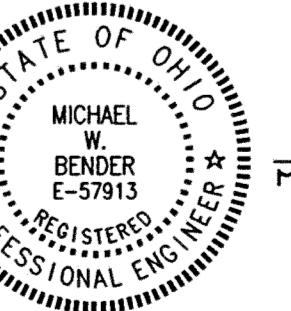

MICHAEL W. BENDER, PROFESSIONAL ENGINEER NO. E-57913

Michael W. Bender
EXHIBIT 'A'

DECLARATION OF CONDOMINIUM FOR
AUBURN CROSSINGS


UNIT 31

SCALE: $\frac{1}{4}'' = 1'-0''$ AUGUST, 2001 SHEET 12 OF 25

LESSMAN, BENDER & ASSOCIATES
Engineers - Surveyors - Planners

Village Station 401 South Street Chardon Ohio 44024
Phone: (440) 286-7204 Fax: (440) 286-3535

V33-R2/2

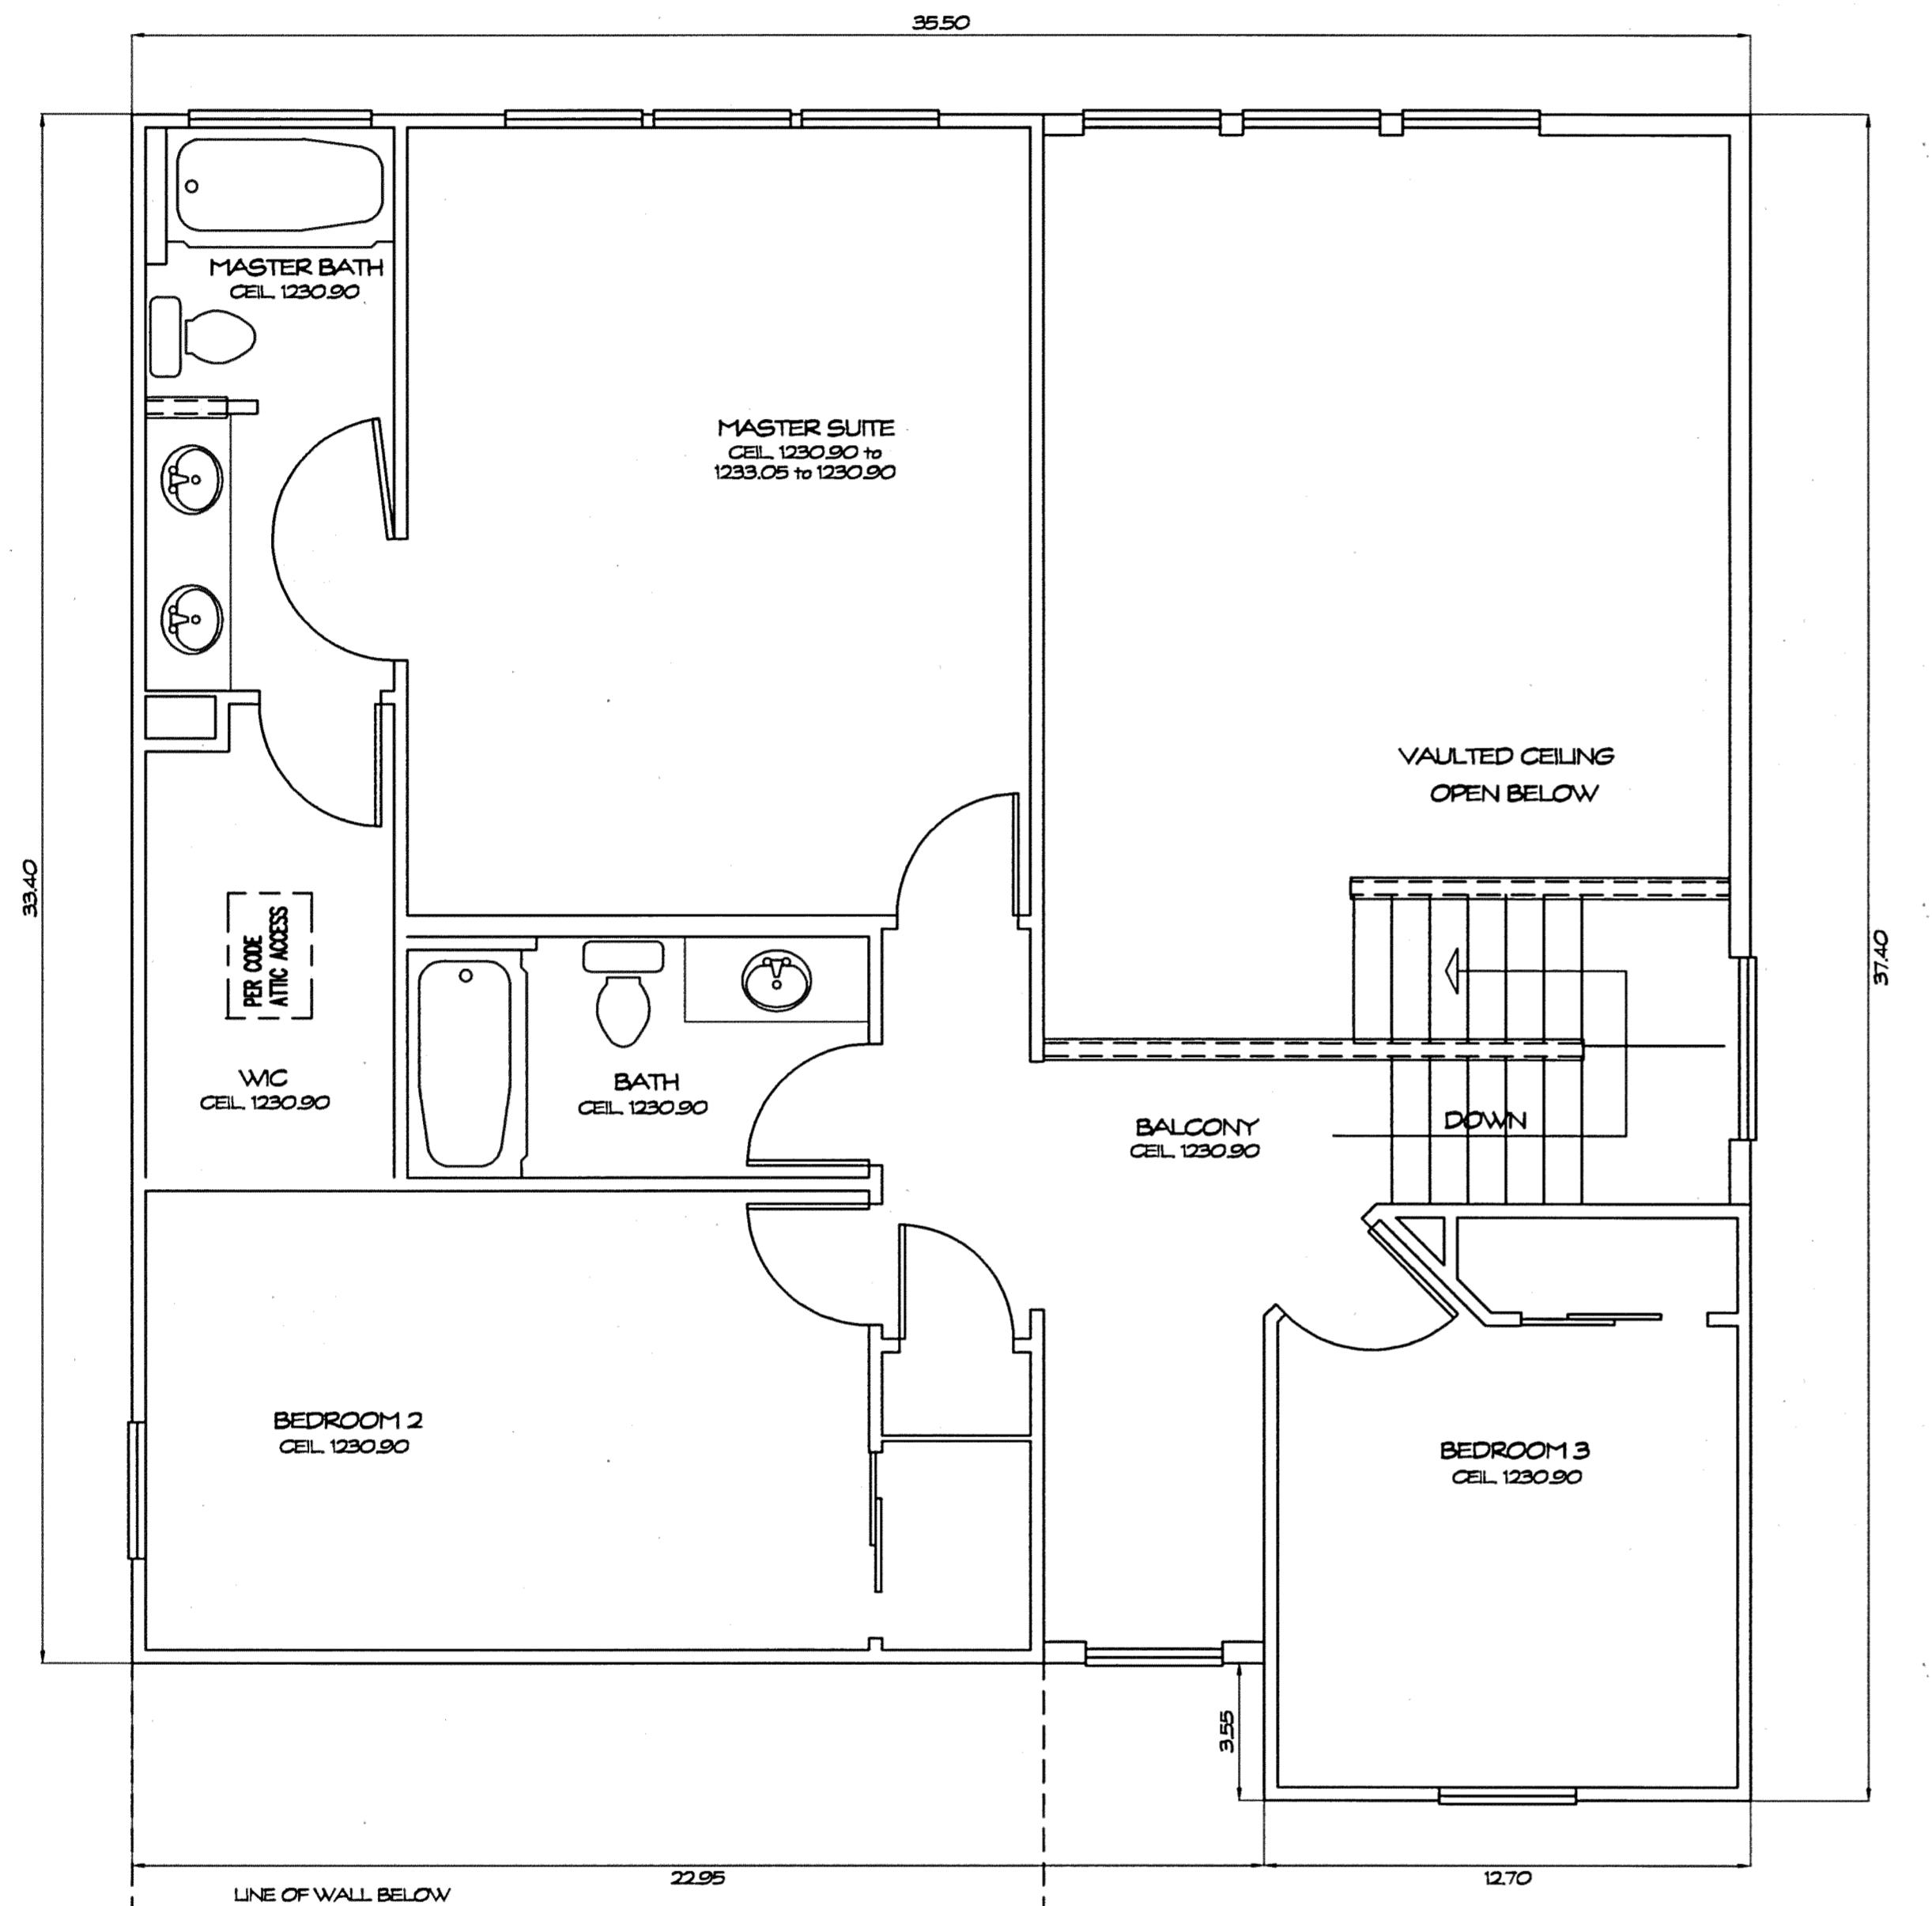


SECOND FLOOR PLAN

1/4" = 1'-0"

THE UNDERSIGNED HEREBY CERTIFIES THAT THESE DRAWINGS SHOW GRAPHICALLY, IN SO FAR AS POSSIBLE, THE LAYOUT, LOCATION, DESIGNATION, AND DIMENSIONS OF THE COMMON AREAS AND FACILITIES AND LIMITED COMMON AREAS AND FACILITIES OF THE BUILDINGS AS CONSTRUCTED. THE PURPOSE OF THIS CERTIFICATION IS TO COMPLY, IN ALL RESPECTS, WITH THE PROVISIONS OF SECTION 531.1(D) OF THE OHIO REVISED CODE.



STEVEN J. LESSMAN, PROFESSIONAL SURVEYOR NO. 7078

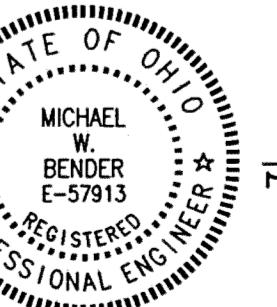

MICHAEL W. BENDER, PROFESSIONAL ENGINEER NO. E-57913

EXHIBIT "A"

DECLARATION OF CONDOMINIUM FOR
AUBURN CROSSINGS


UNIT 31

SCALE: 1/4" = 1'-0" | AUGUST, 2001 | SHEET 13 OF 25

LESSMAN, BENDER & ASSOCIATES
Engineers - Surveyors - Planners

Village Station 401 South Street Chardon Ohio 44024
Phone: (440) 286-7204 Fax: (440) 286-3335

V33 P13

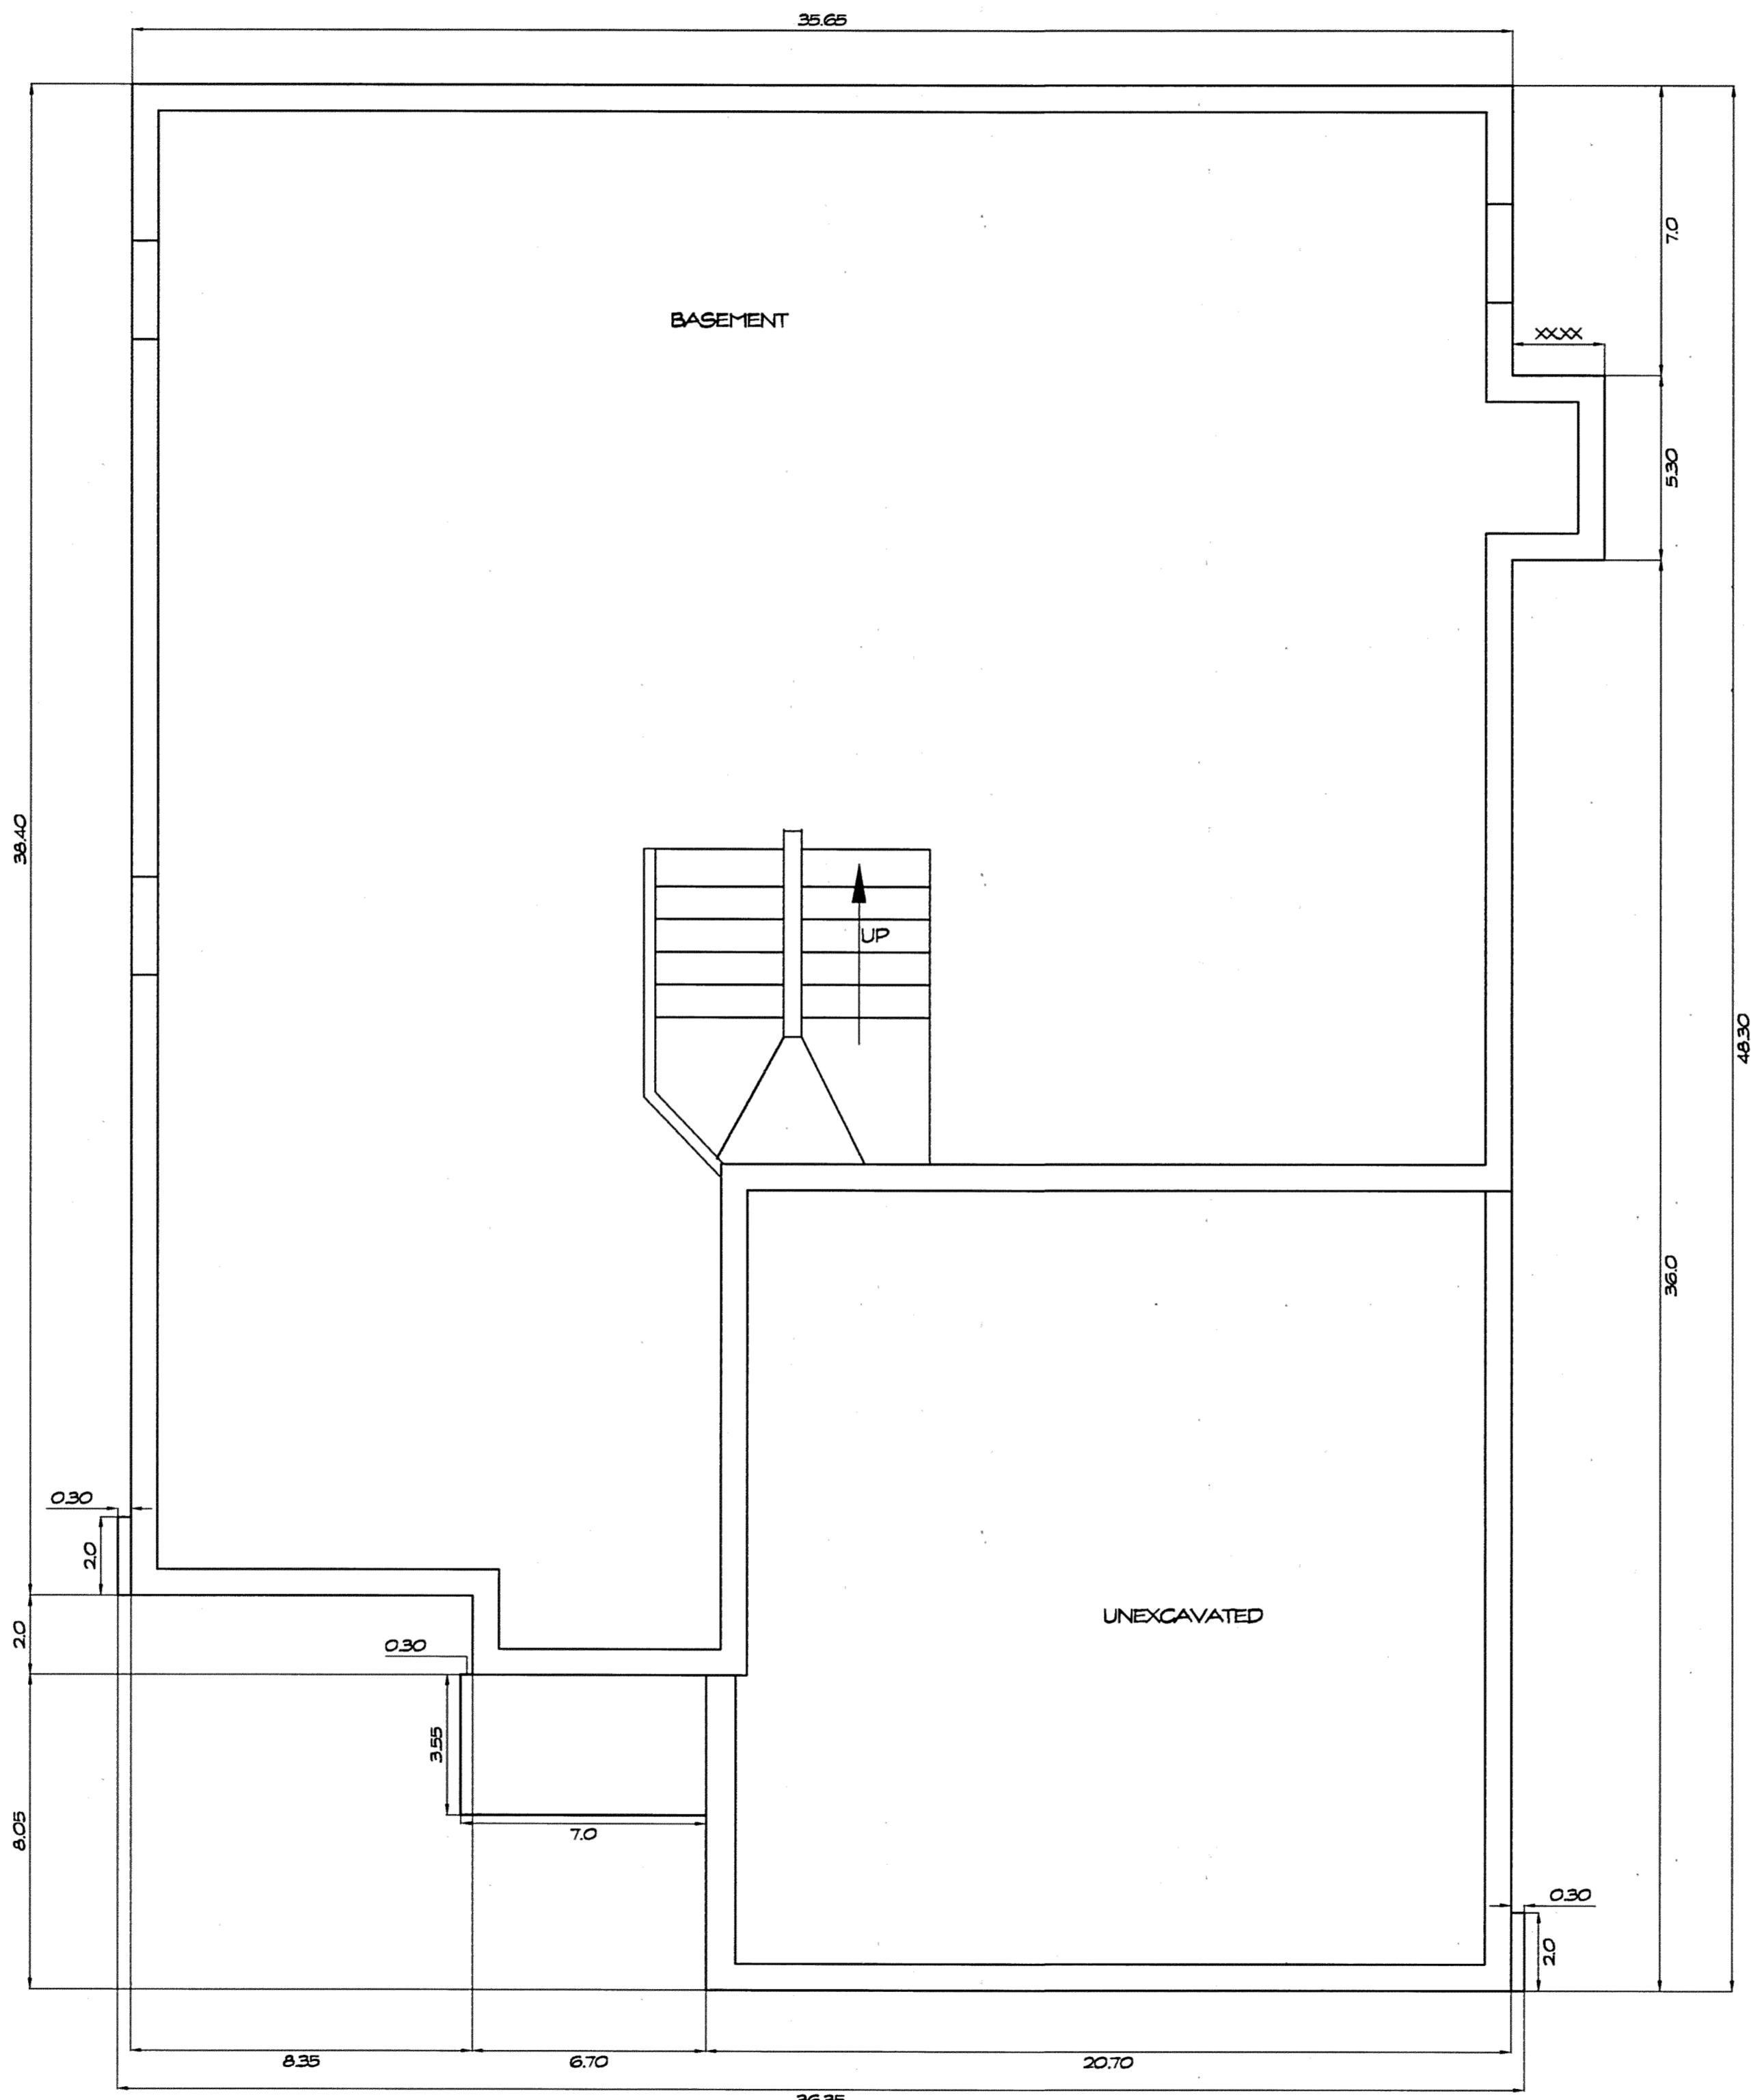


FOUNDATION PLAN

1/4" = 1'-0"


V33-P44

EXHIBIT "A"

DECLARATION OF CONDOMINIUM FOR AUBURN CROSSINGS			
UNIT 32			
SCALE: 1/4" = 1'-0" AUGUST, 2001 SHEET 14 OF 25			
LESSMAN, BENDER & ASSOCIATES Engineers - Surveyors - Planners			
Village Station	401 South Street	Chardon	Ohio
Phone: (440) 286-7204			44024
Fax: (440) 286-3535			

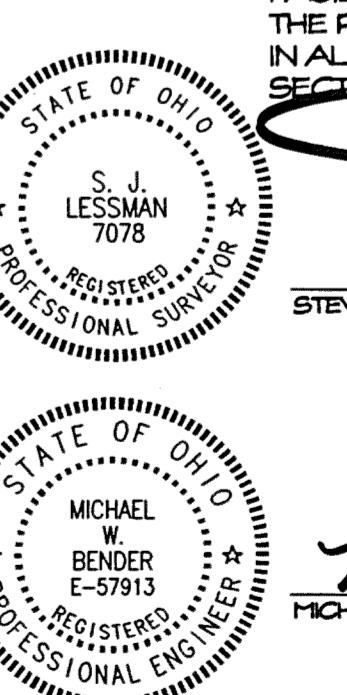

STEVEN J. LESSMAN, PROFESSIONAL SURVEYOR NO. 7078

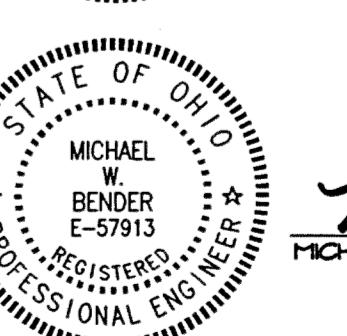

MICHAEL W. BENDER, REGISTERED PROFESSIONAL ENGINEER NO. E-57913

EXHIBIT "A"


DECLARATION OF CONDOMINIUM FOR
AUBURN CROSSINGS**UNIT 32**

SCALE: 1/4" = 1'-0" AUGUST, 2001 SHEET 14 OF 25

LESSMAN, BENDER & ASSOCIATES
Engineers - Surveyors - Planners

Village Station 401 South Street Chardon Ohio 44024

Phone: (440) 286-7204 Fax: (440) 286-3535

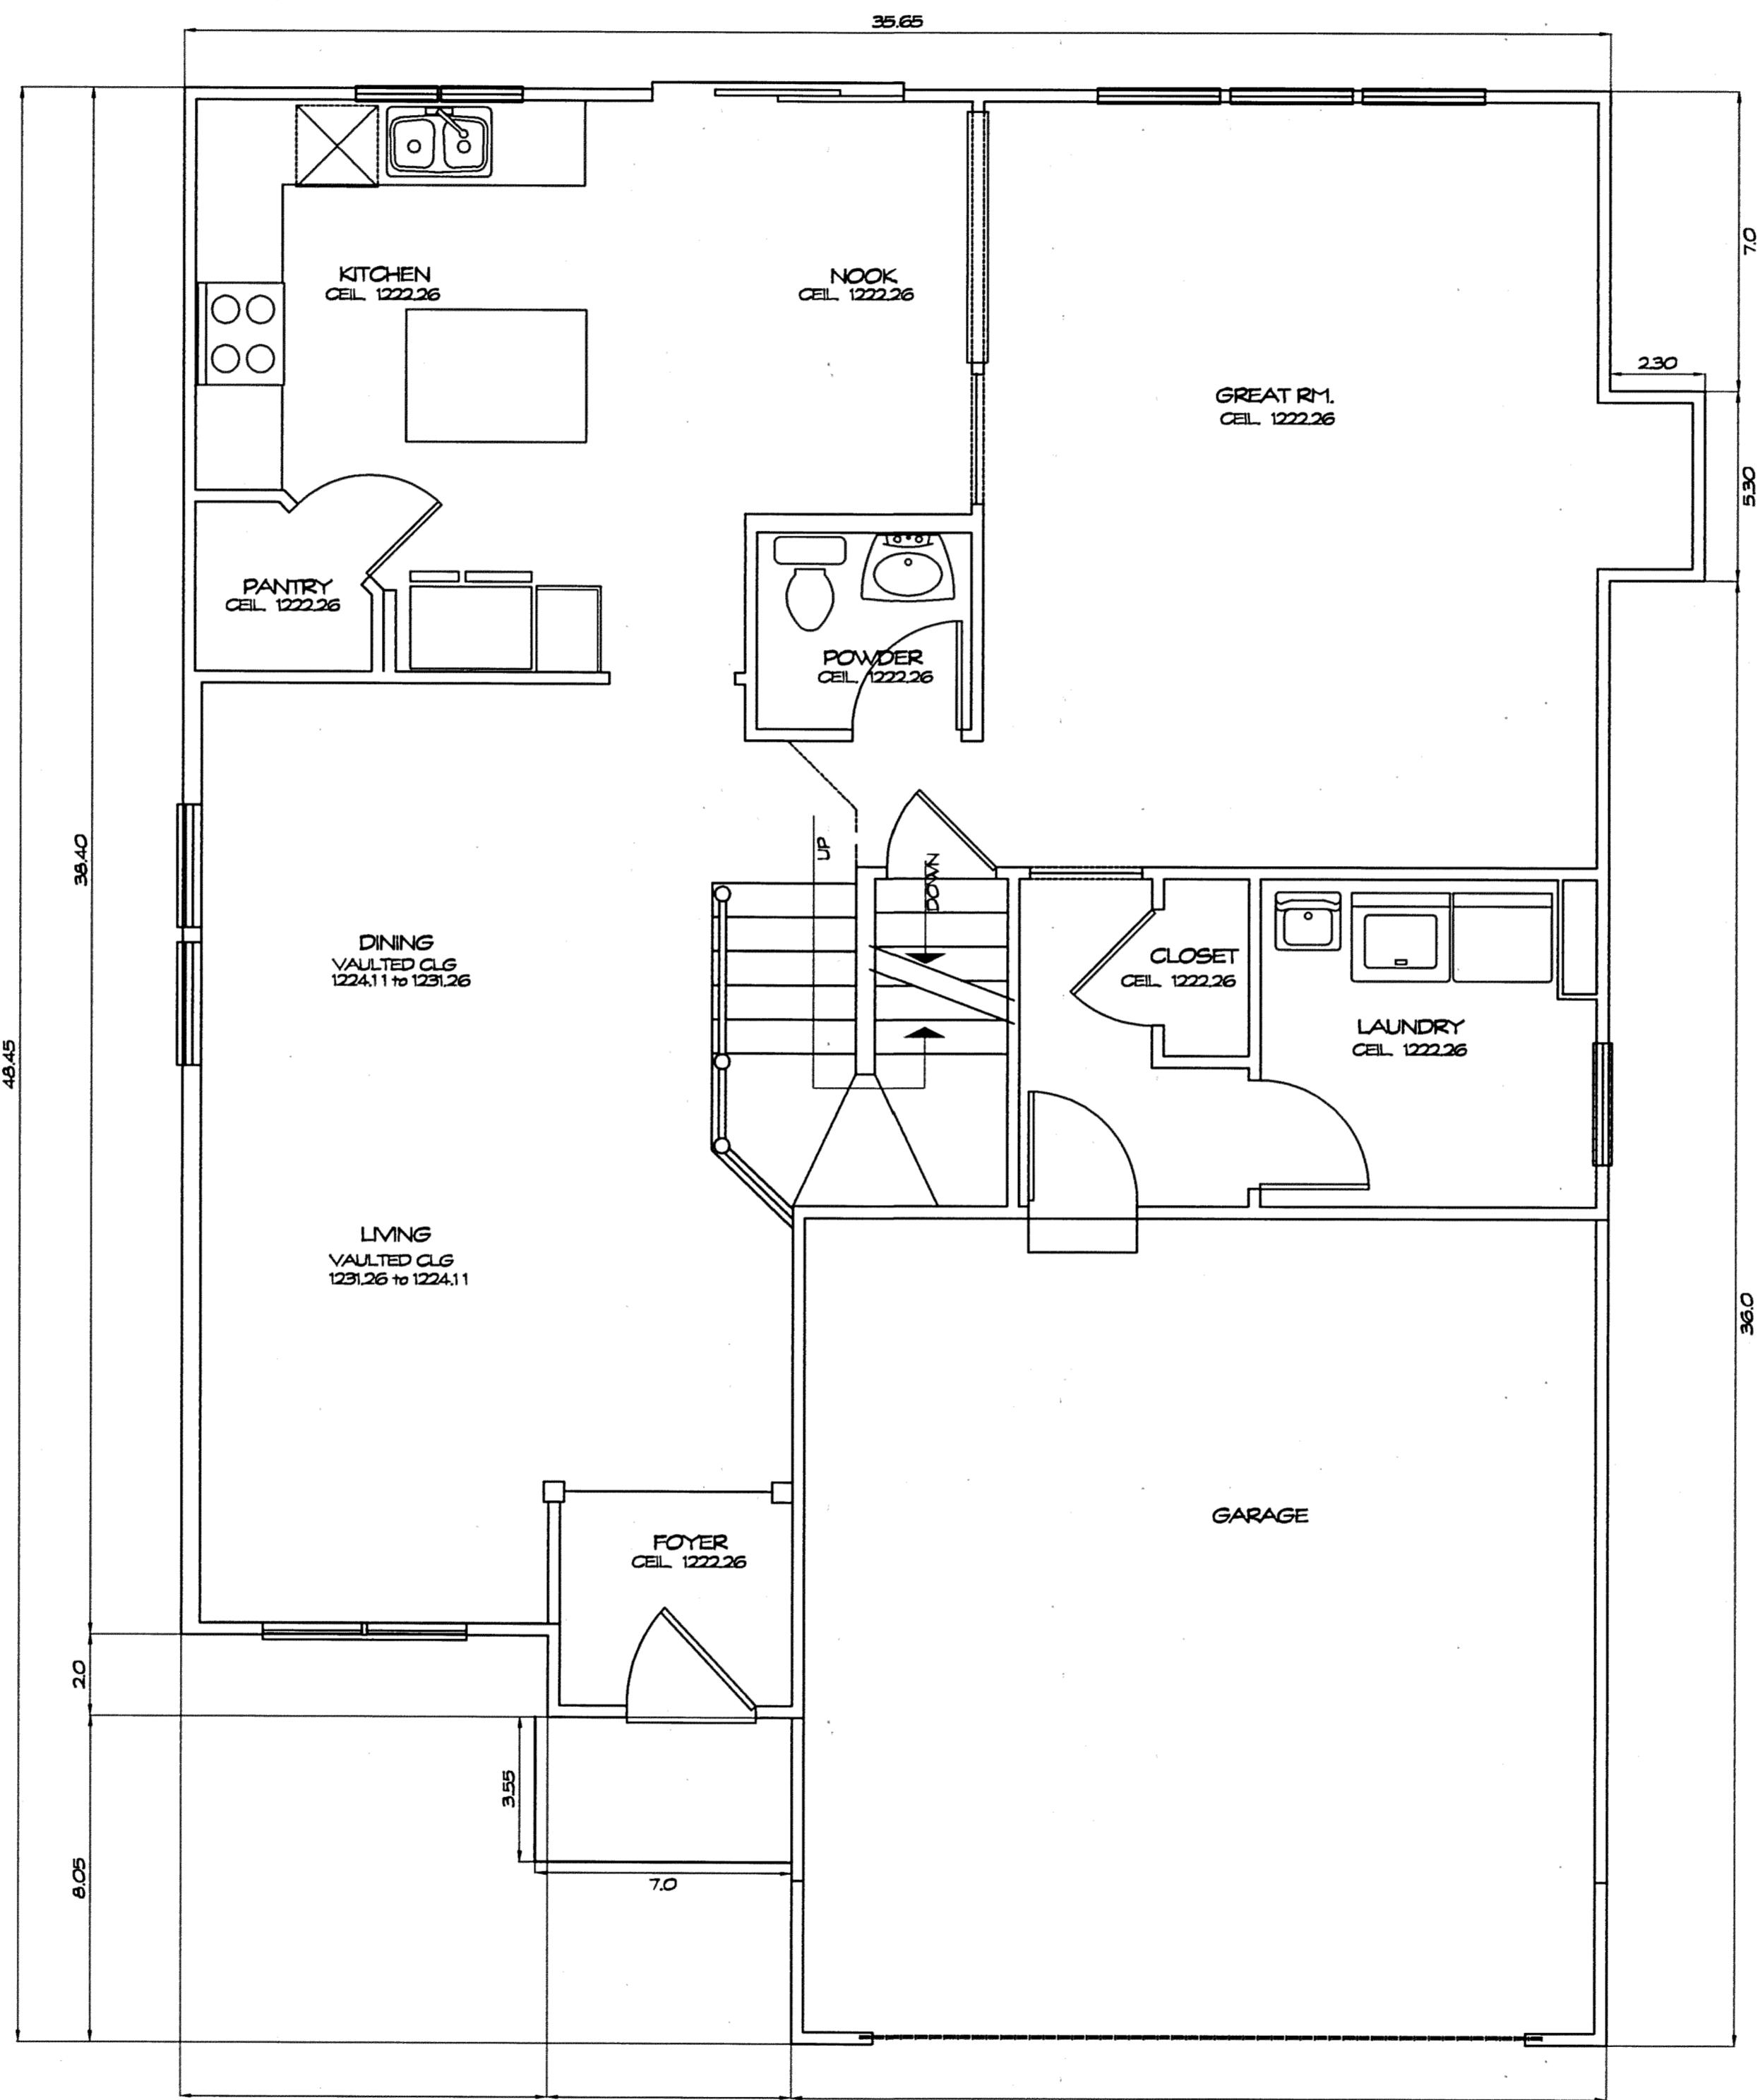

FIRST FLOOR PLAN

1/4" = 1'-0"

UNIT	GARAGE ELEV. FLOOR CEILING		SQ. FT.	BASEMENT ELEV. FLOOR CEILING		SQ. FT.	1ST FLOOR ELEV. FLOOR CEILING		SQ. FT.	2ND FLOOR ELEV. FLOOR CEILING		SQ. FT.	TOTAL SQ. FT.
32	1211.29	1222.14	429	1204.45	1212.20	1170	1213.26	See Plan	1195	1223.26	See Plan	1107	3801

THE UNDERSIGNED HEREBY CERTIFIES THAT THESE DRAWINGS SHOW GRAPHICALLY, IN SO FAR AS POSSIBLE, THE LAYOUT, LOCATION, DESIGNATION, AND DIMENSIONS OF THE COMMON AREAS AND FACILITIES AND LIMITED COMMON AREAS AND FACILITIES OF THE BUILDINGS AS CONSTRUCTED. THE PURPOSE OF THIS CERTIFICATION IS TO COMPLY, IN ALL RESPECTS, WITH THE PROVISIONS OF SECTION 5311.01 OF THE OHIO REVISED CODE.

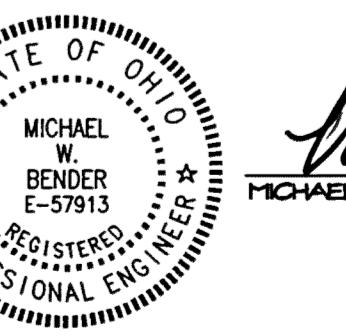
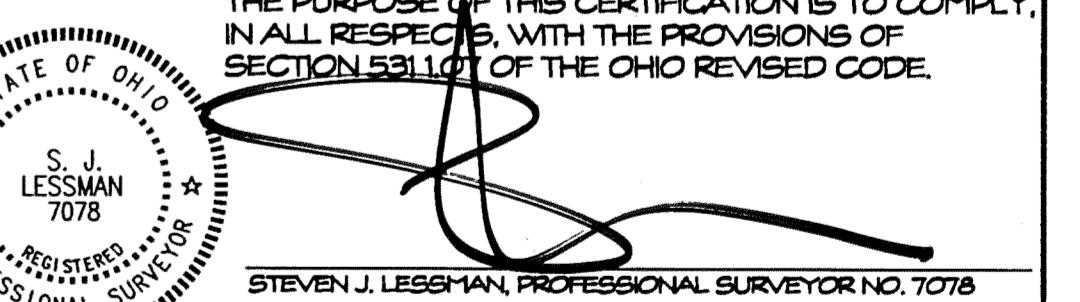


EXHIBIT "A"


DECLARATION OF CONDOMINIUM FOR
AUBURN CROSSINGS

UNIT 32

SCALE: 1/4" = 1'-0" | AUGUST, 2001 SHEET 15 OF 25

LESSMAN, BENDER & ASSOCIATES
Engineers - Surveyors - PlannersVillage Station 401 South Street Chardon Ohio 44024
Phone: (440) 286-7204 Fax: (440) 286-3335


V33-P45

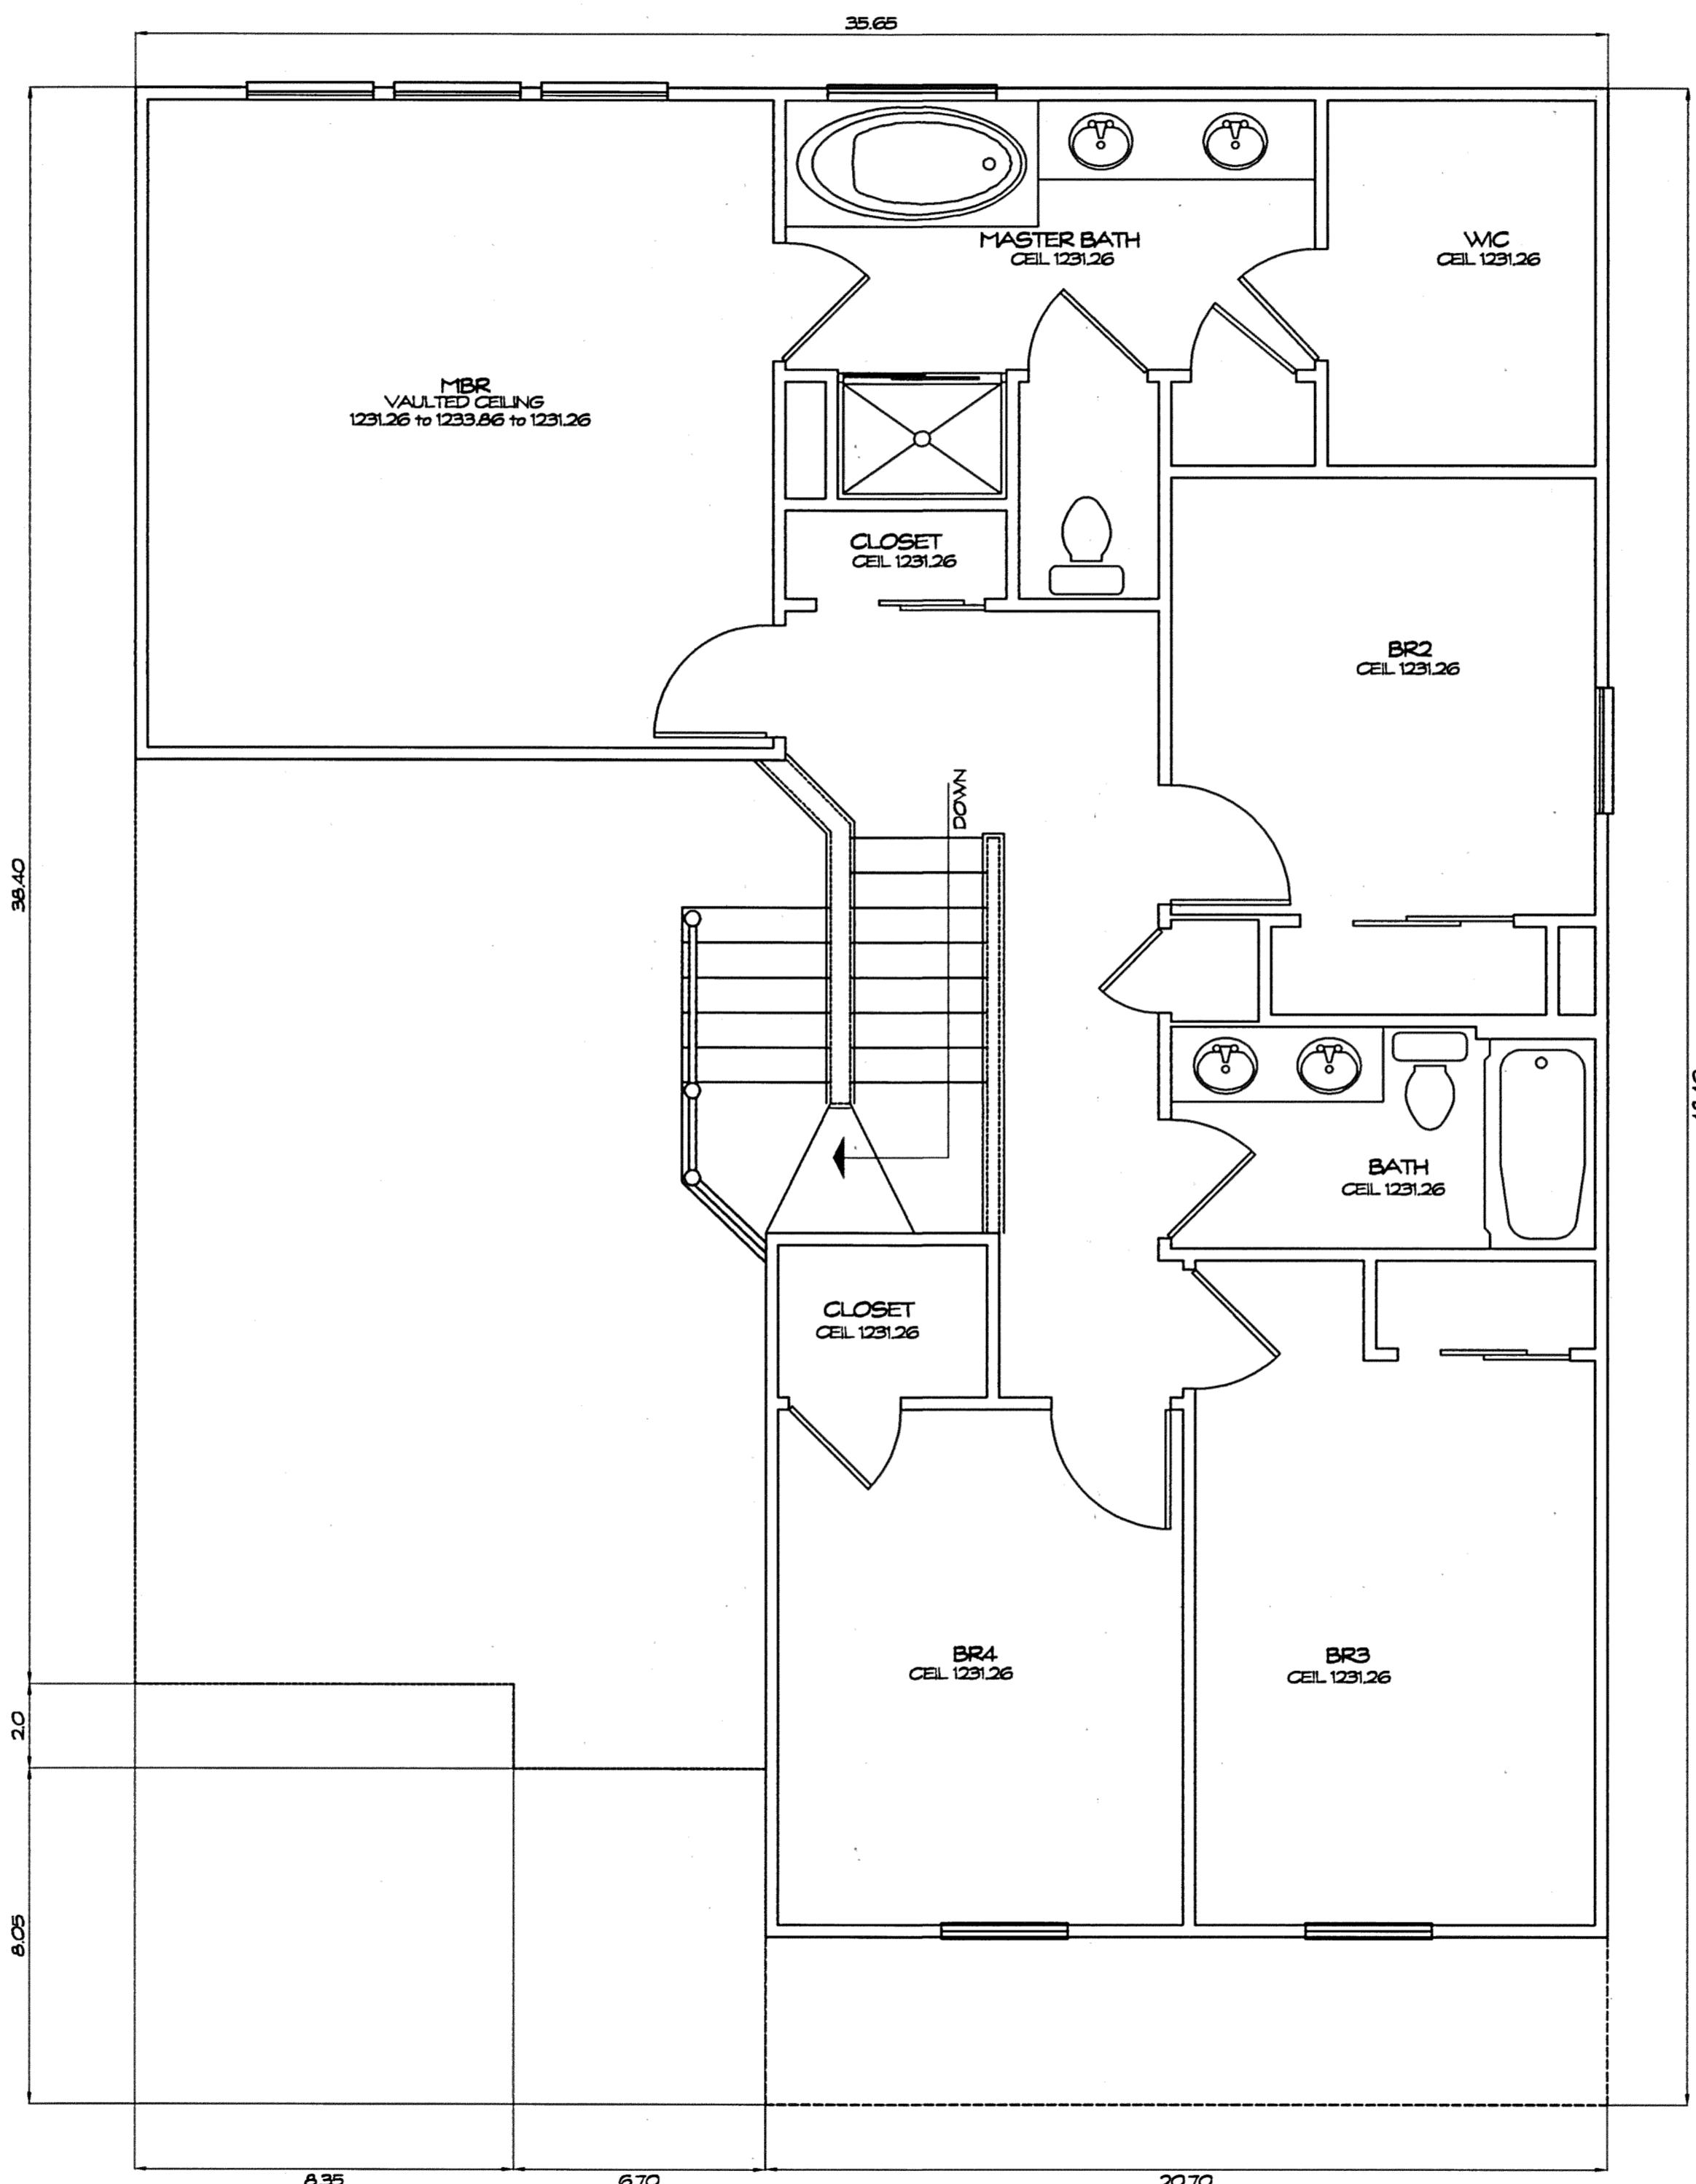


SECOND FLOOR PLAN
 $\frac{1}{4}'' = 1'-0''$

V33 P46


EXHIBIT "A"
DECLARATION OF CONDOMINIUM FOR
AUBURN CROSSINGS
UNIT 32
SCALE: $\frac{1}{4}'' = 1'-0''$ AUGUST, 2001 SHEET 16 OF 25
LESSMAN, BENDER & ASSOCIATES
Engineers - Surveyors - Planners
Village Station 401 South Street Chardon Ohio 44024
Phone: (440) 286-7204 Fax: (440) 286-3535

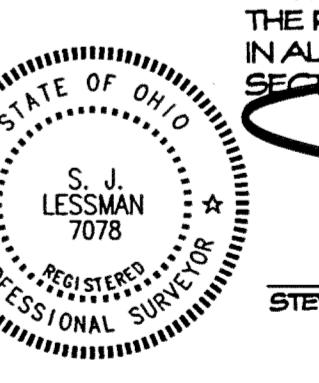

STEVEN J. LESSMAN, PROFESSIONAL SURVEYOR NO. 7078

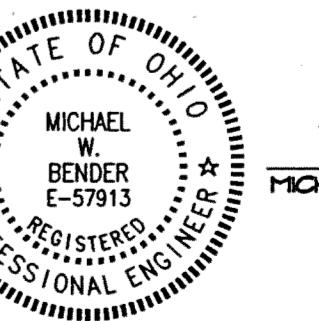


MICHAEL W. BENDER, PROFESSIONAL ENGINEER NO. E-57913

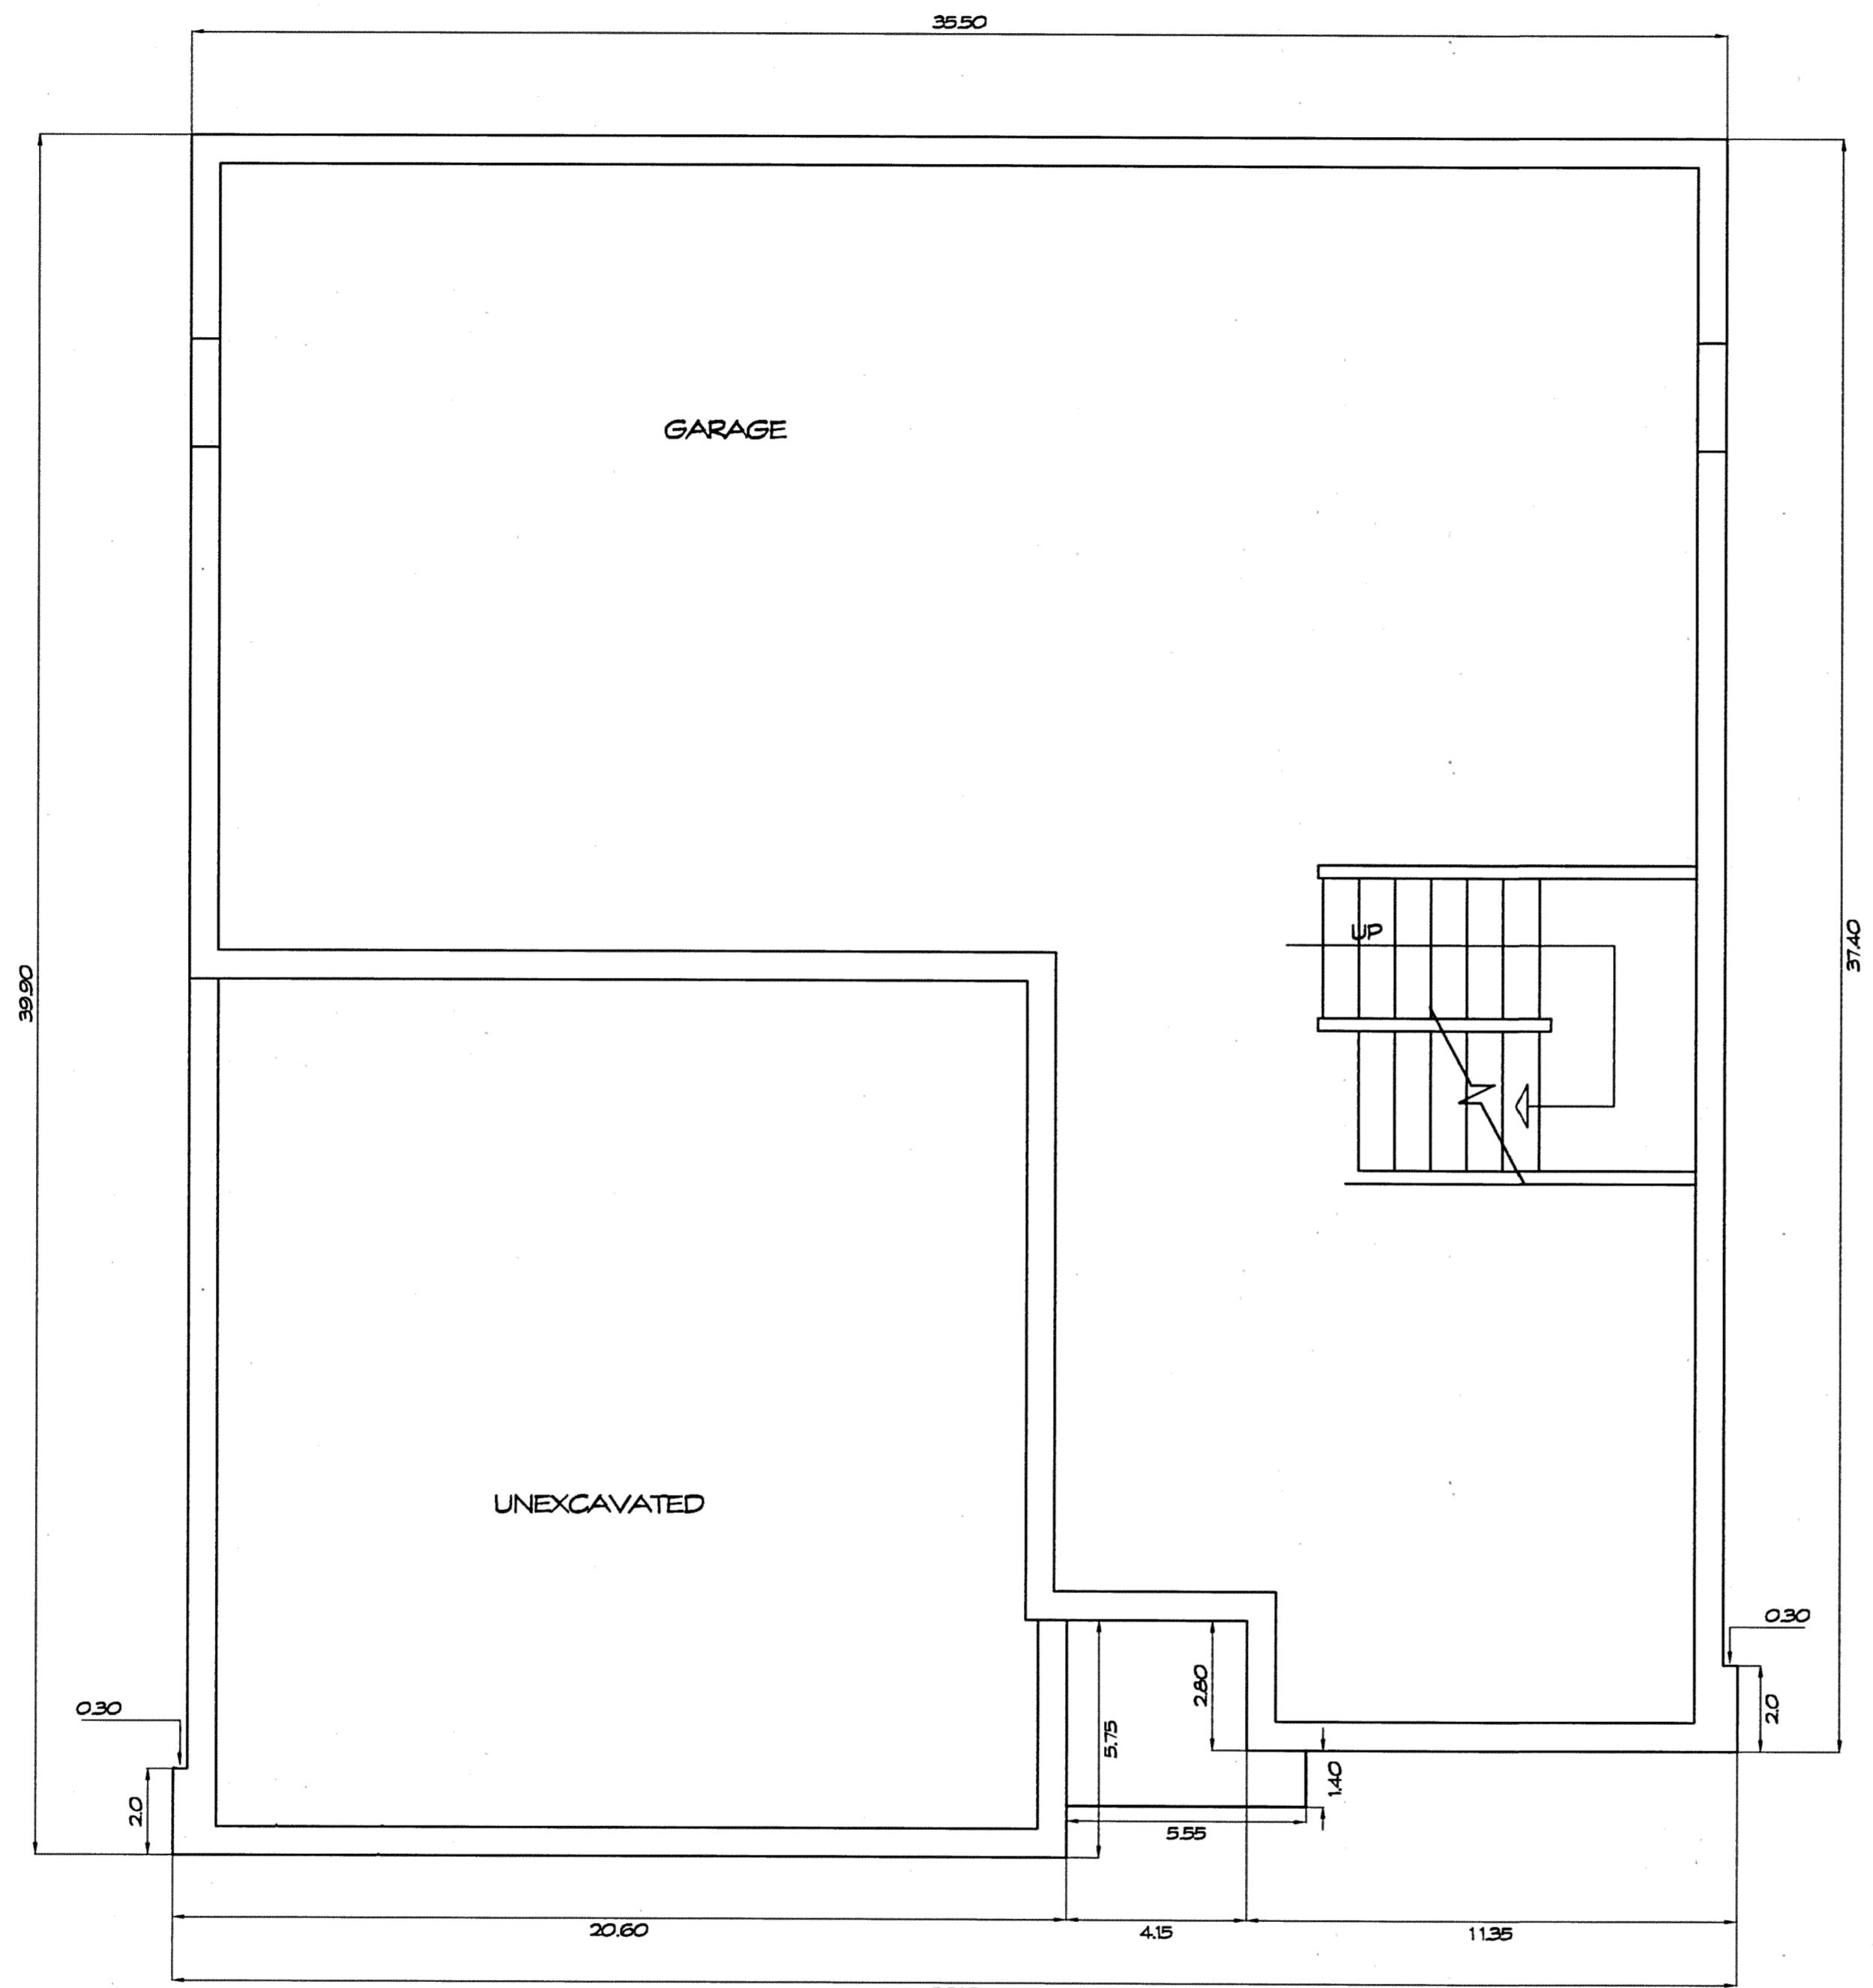


FOUNDATION PLAN

1/4" = 1'-0"

THE UNDERSIGNED HEREBY CERTIFIES THAT THESE DRAWINGS SHOW GRAPHICALLY, IN SO FAR AS POSSIBLE, THE LAYOUT, LOCATION, DESIGNATION, AND DIMENSIONS OF THE COMMON AREAS AND FACILITIES AND LIMITED COMMON AREAS AND FACILITIES OF THE BUILDINGS AS CONSTRUCTED. THE PURPOSE OF THIS CERTIFICATION IS TO COMPLY, IN ALL RESPECTS, WITH THE PROVISIONS OF SECTION 5311.01 OF THE OHIO REVISED CODE.

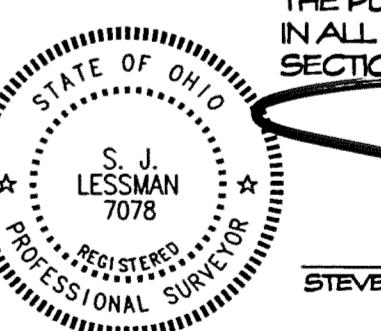

STEVEN J. LESSMAN, PROFESSIONAL SURVEYOR NO. 7078

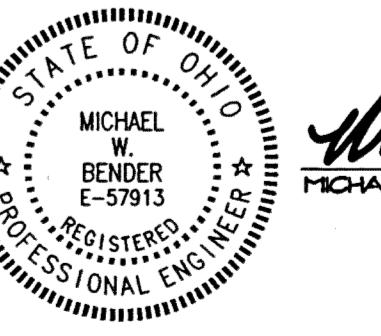


MICHAEL W. BENDER, PROFESSIONAL ENGINEER NO. E-57913

EXHIBIT "A"

DECLARATION OF CONDOMINIUM FOR AUBURN CROSSINGS		
UNIT 33		
SCALE: 1/4" = 1'-0" AUGUST, 2001 SHEET 17 OF 25		
LESSMAN, BENDER & ASSOCIATES Engineers - Surveyors - Planners		
Village Station	401 South Street	Charlton
Phone: (440) 286-7204		Ohio 44024
Fax: (440) 286-3535		

V33-Pt17

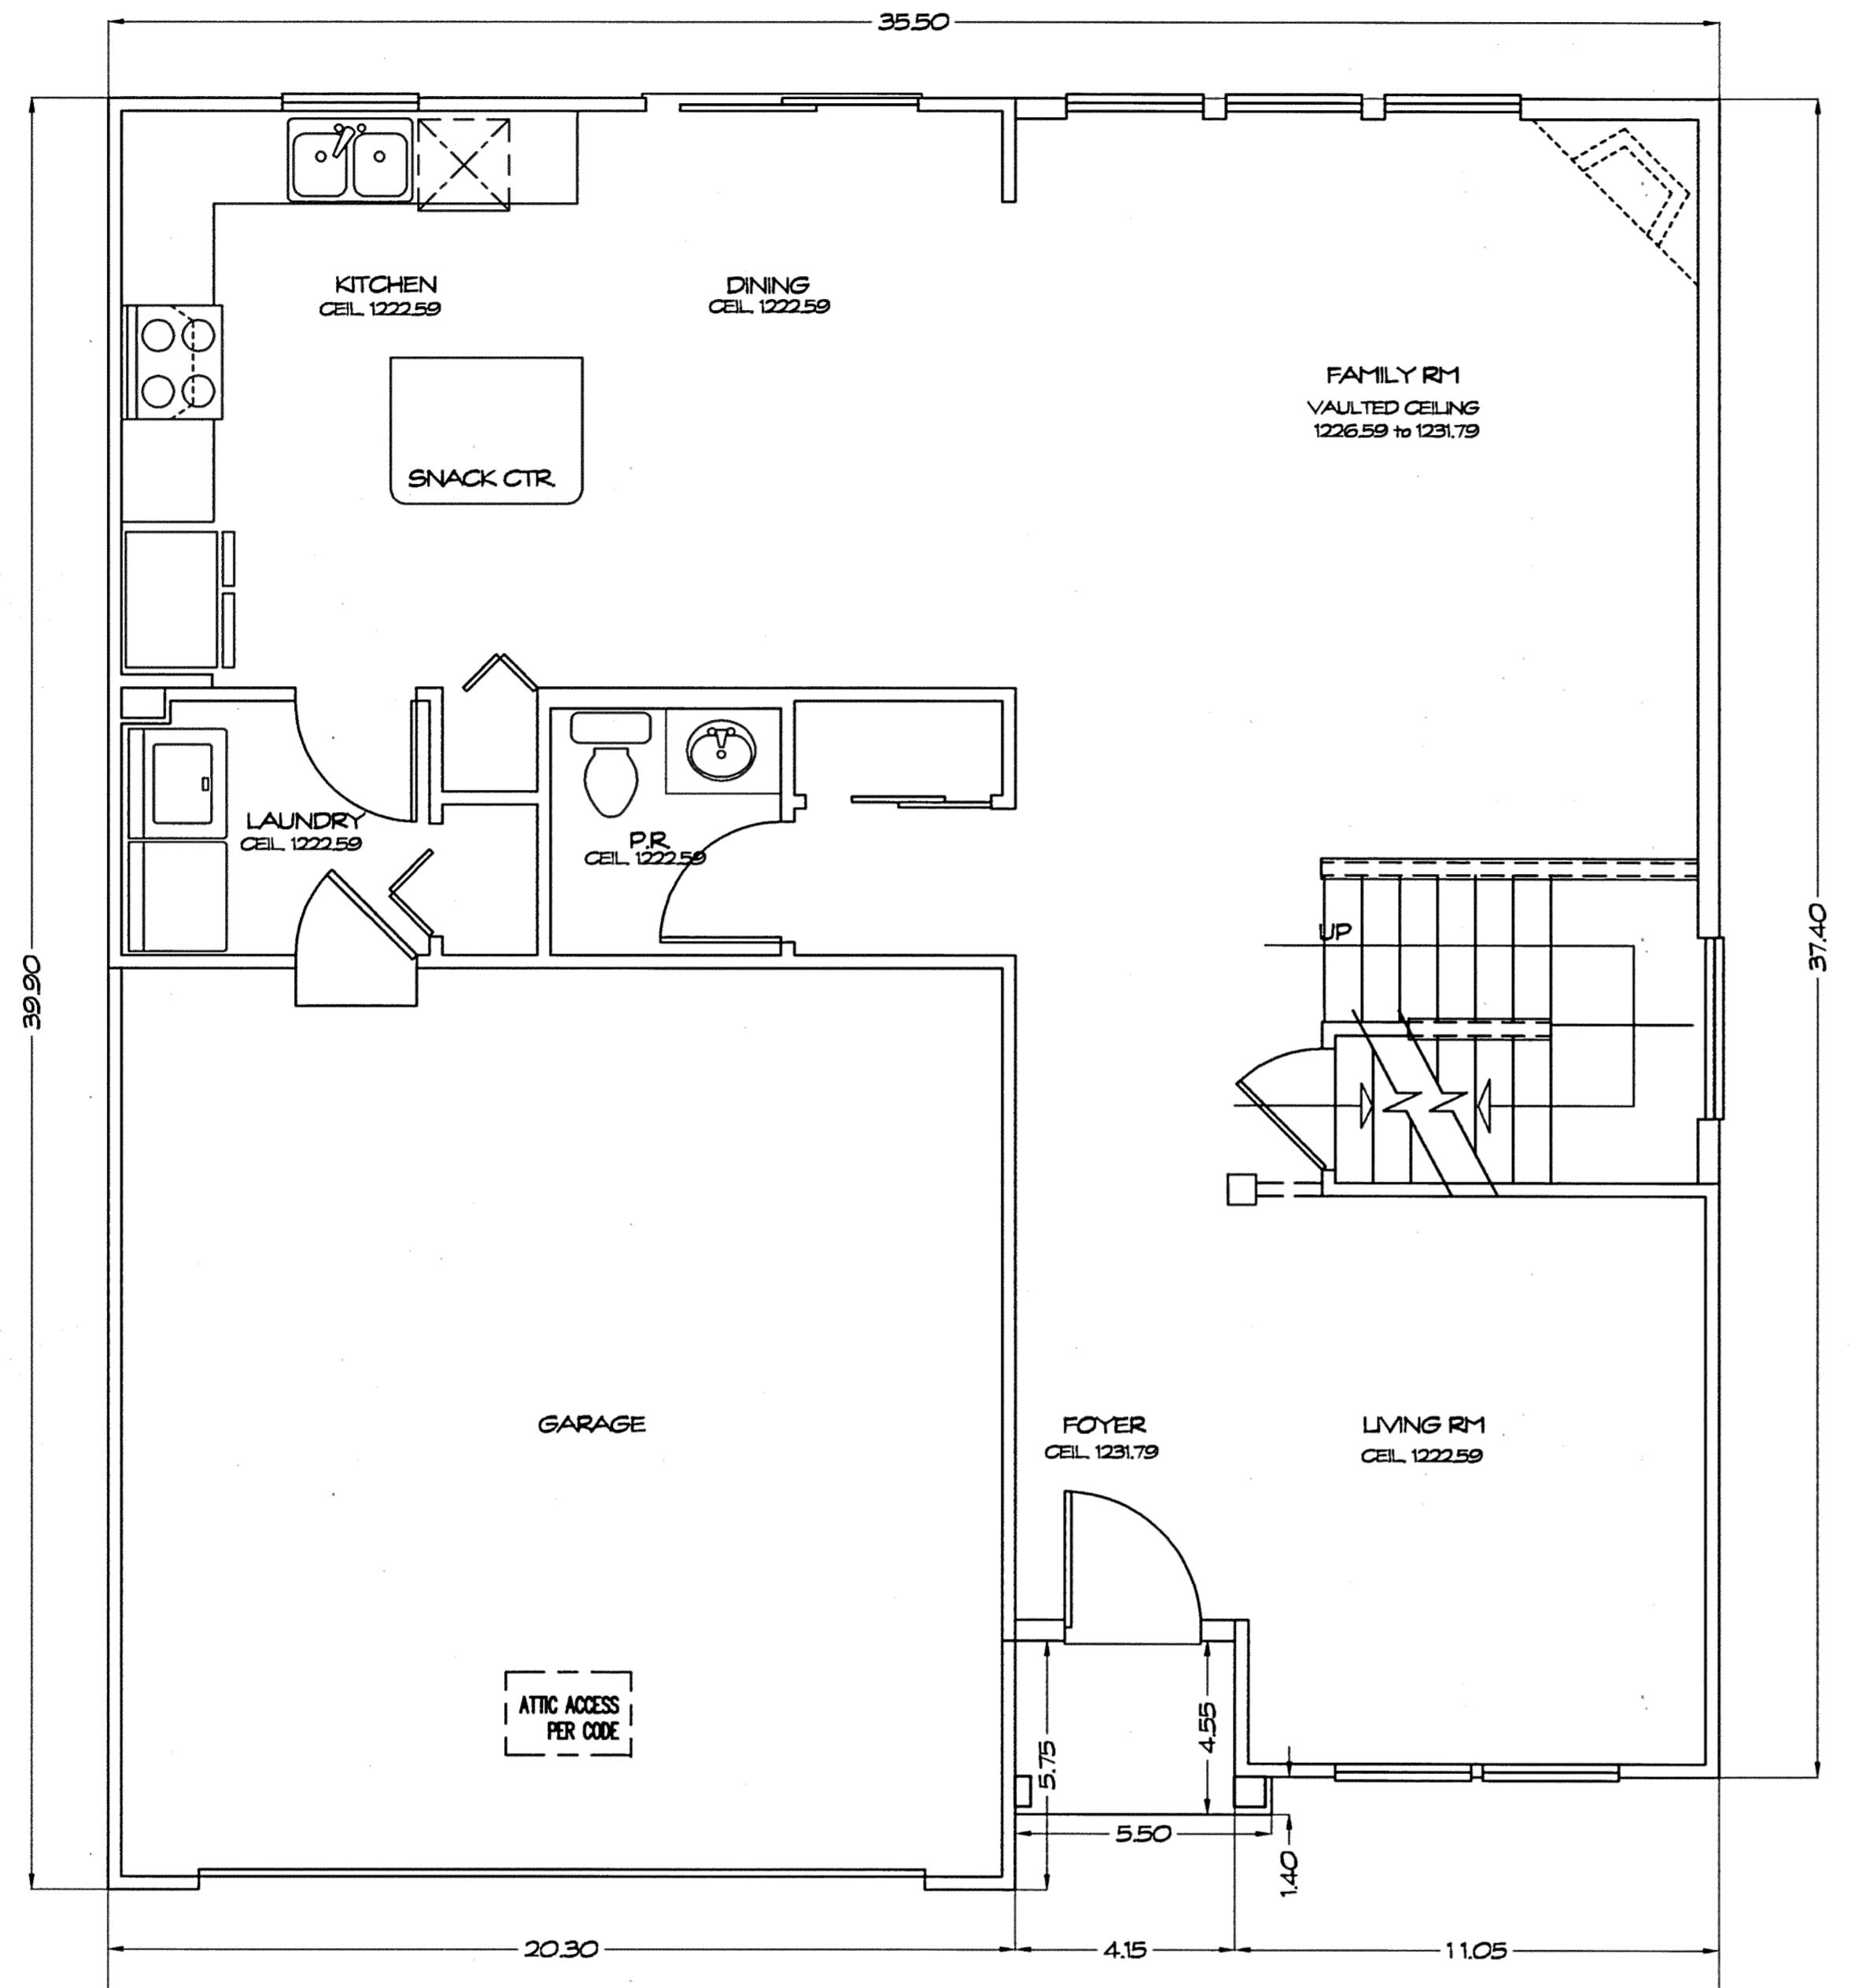


UNIT	GARAGE ELEV.		BASEMENT ELEV.		1ST FLOOR ELEV.		2ND FLOOR ELEV.		TOTAL SQ. FT.
	FLOOR	CEILING	SQ. FT.	FLOOR	CEILING	SQ. FT.	FLOOR	CEILING	
33	1212.47	1222.67	421	1205.54	1213.44	960	1214.59	See Plan	3525

THE UNDERSIGNED HEREBY CERTIFIES THAT THESE DRAWINGS SHOW GRAPHICALLY, IN SO FAR AS POSSIBLE, THE LAYOUT, LOCATION, DESIGNATION, AND DIMENSIONS OF THE COMMON AREAS AND FACILITIES AND LIMITED COMMON AREAS AND FACILITIES OF THE BUILDINGS AS CONSTRUCTED. THE PURPOSE OF THIS CERTIFICATION IS TO COMPLY, IN ALL RESPECTS, WITH THE PROVISIONS OF SECTION 531.107 OF THE OHIO REVISED CODE.



STEVEN J. LESSMAN, PROFESSIONAL SURVEYOR NO. 7078

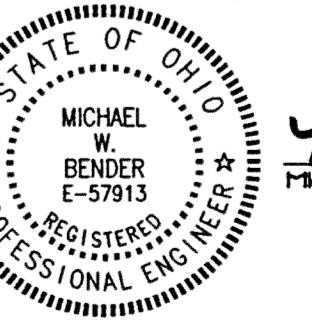


MICHAEL W. BENDER, PROFESSIONAL ENGINEER NO. E-57913

EXHIBIT 'A'

DECLARATION OF CONDOMINIUM FOR AUBURN CROSSINGS
UNIT 33
SCALE: $\frac{1}{4}'' = 1'-0''$ AUGUST, 2001 SHEET 18 OF 25
LESSMAN, BENDER & ASSOCIATES Engineers - Surveyors - Planners
Village Station 401 South Street Chardon Ohio 44024 Phone: (440) 286-7204 Fax: (440) 286-3535

V33-P4B

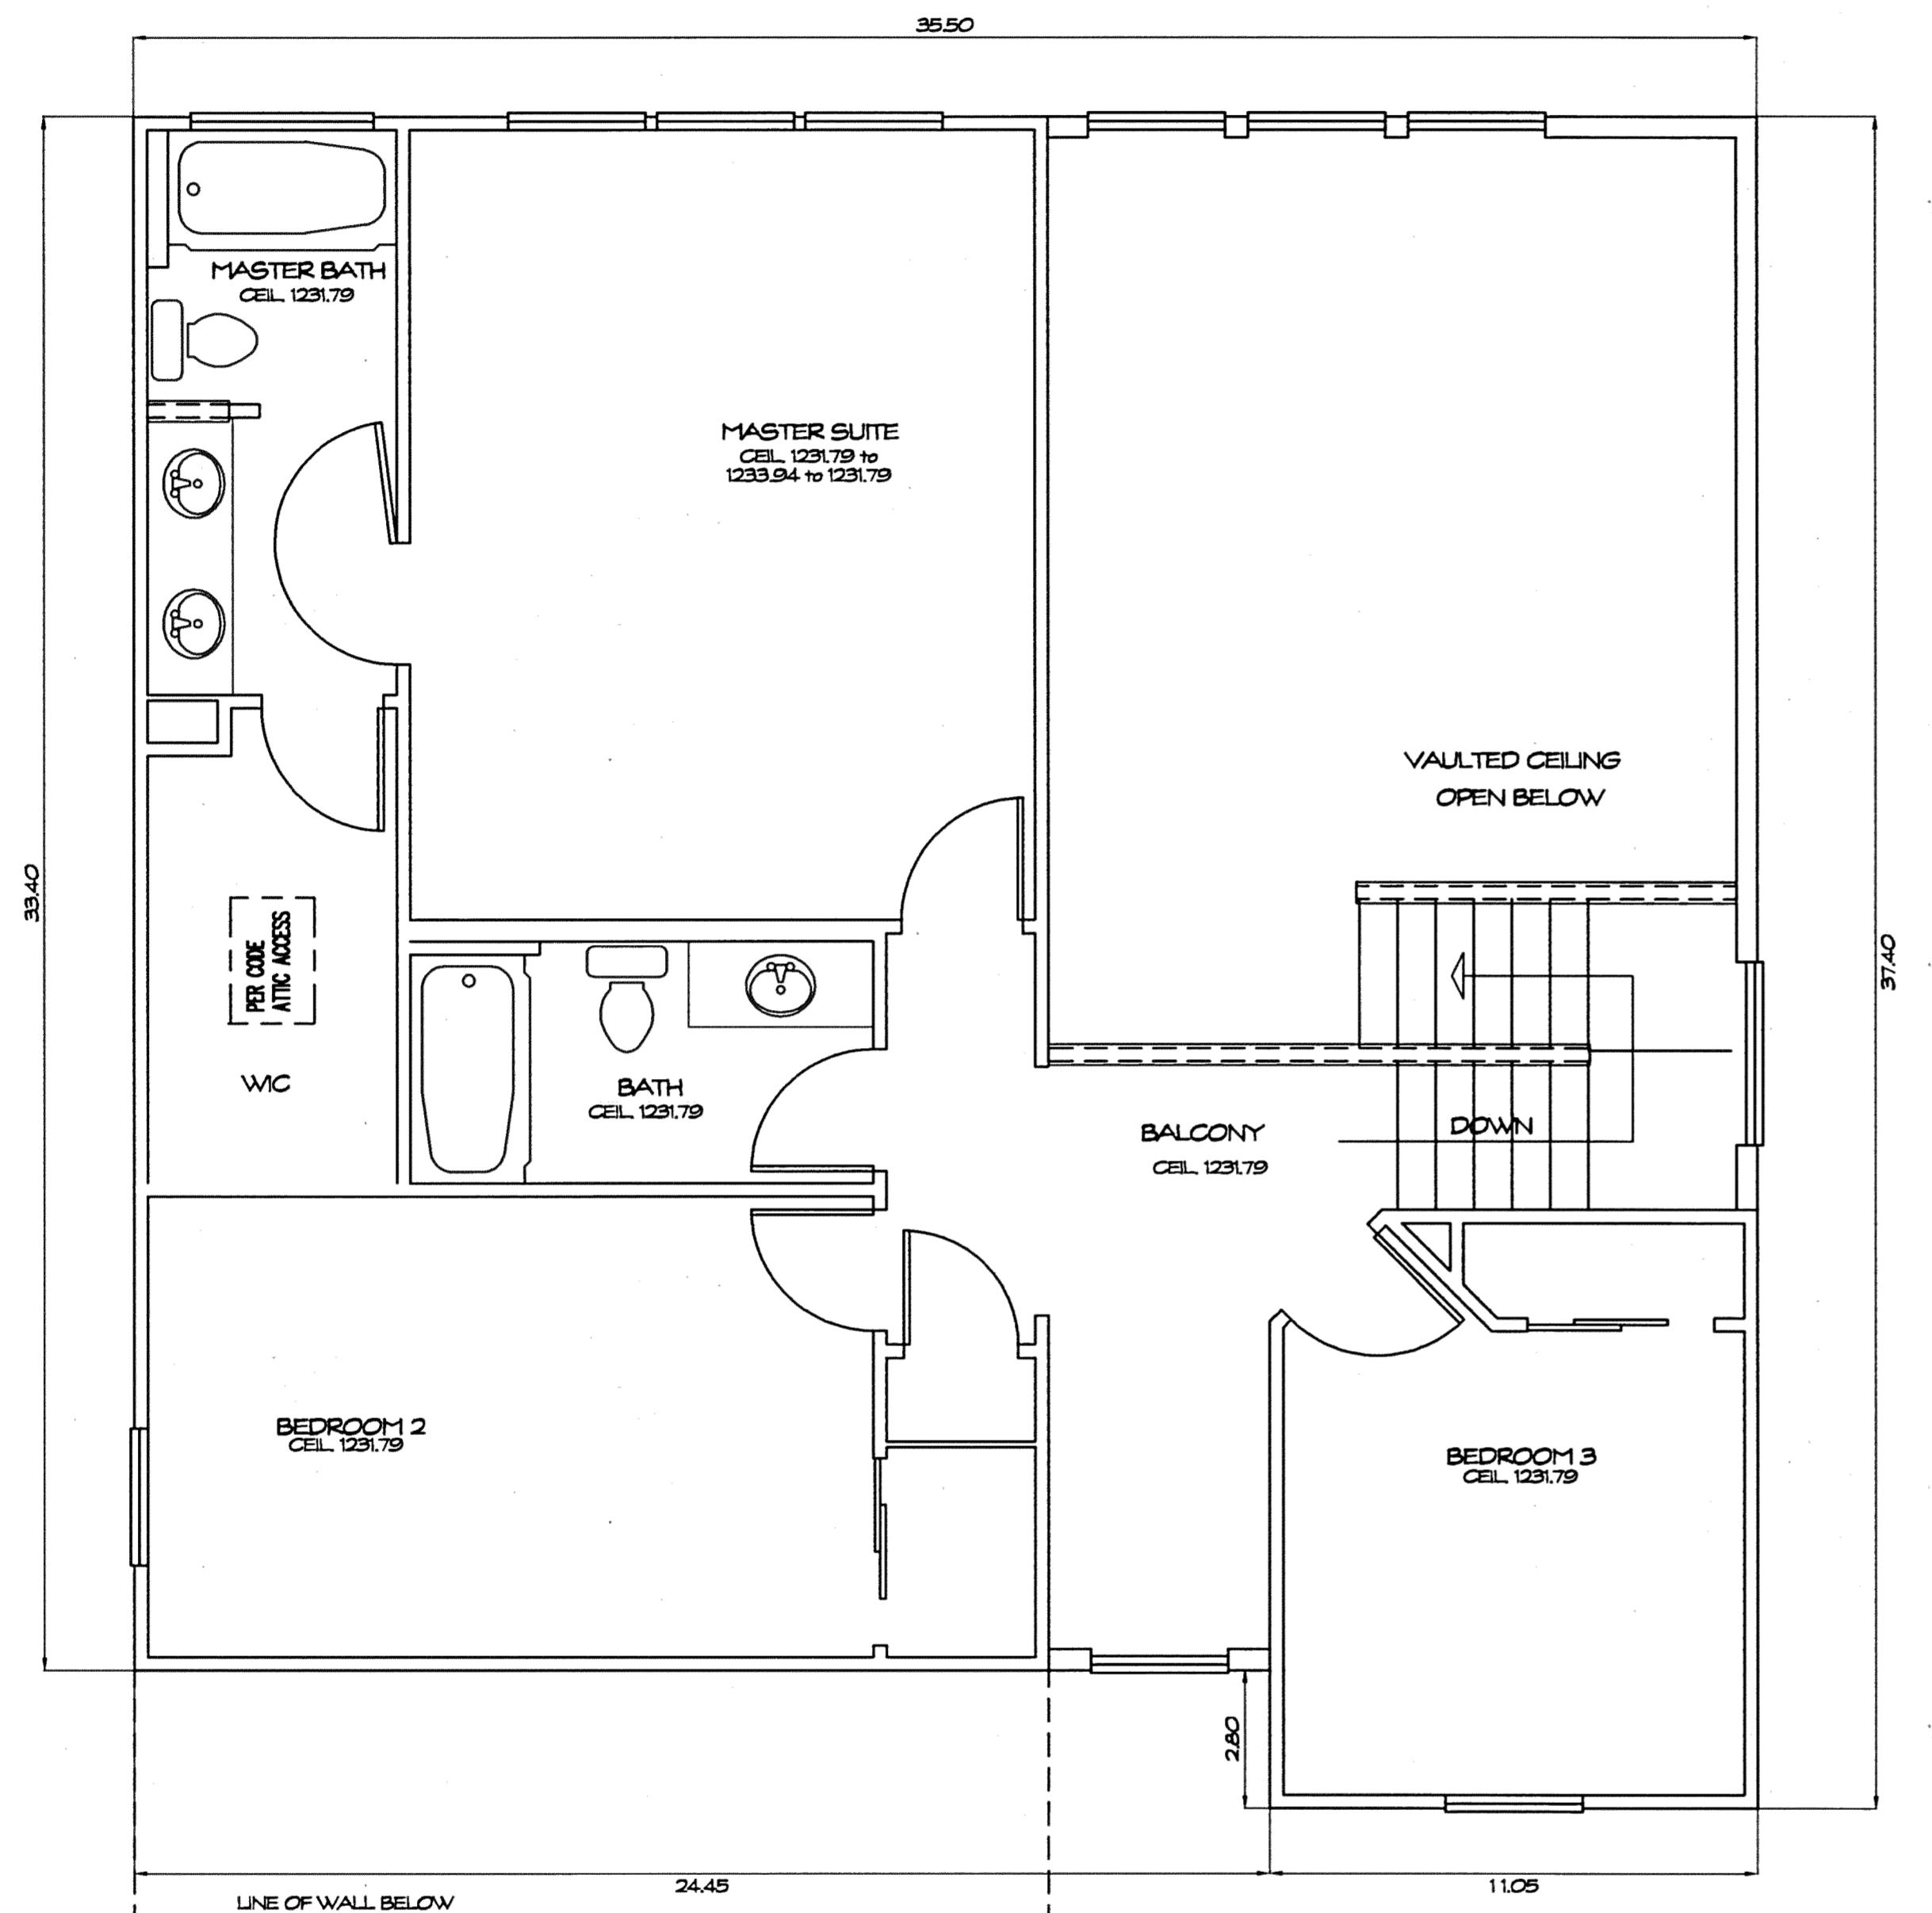


SECOND FLOOR PLAN

1/4" = 1'-0"

THE UNDERSIGNED HEREBY CERTIFIES THAT THESE DRAWINGS SHOW GRAPHICALLY, IN SO FAR AS POSSIBLE, THE LAYOUT, LOCATION, DESIGNATION, AND DIMENSIONS OF THE COMMON AREAS AND FACILITIES AND LIMITED COMMON AREAS AND FACILITIES OF THE BUILDINGS AS CONSTRUCTED. THE PURPOSE OF THIS CERTIFICATION IS TO COMPLY, IN ALL RESPECTS, WITH THE PROVISIONS OF SECTION 5310.1 OF THE OHIO REVISED CODE.



STEVEN J. LESSMAN, PROFESSIONAL SURVEYOR NO. E-5798
[Handwritten signature]

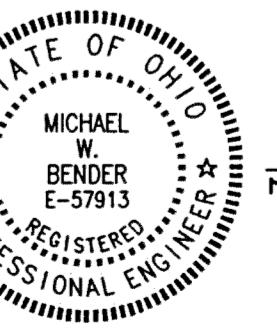


MICHAEL W. BENDER, PROFESSIONAL ENGINEER NO. E-5793
[Handwritten signature]

EXHIBIT "A"

DECLARATION OF CONDOMINIUM FOR AUBURN CROSSINGS		
UNIT 33		
SCALE: 1/4" = 1'-0" AUGUST, 2001 SHEET 19 OF 25		
LESSMAN, BENDER & ASSOCIATES Engineers - Surveyors - Planners		
401 South Street Chardon Ohio 44024 Phone: (440) 286-7204 Fax: (440) 286-3535		

V33-Pd/9

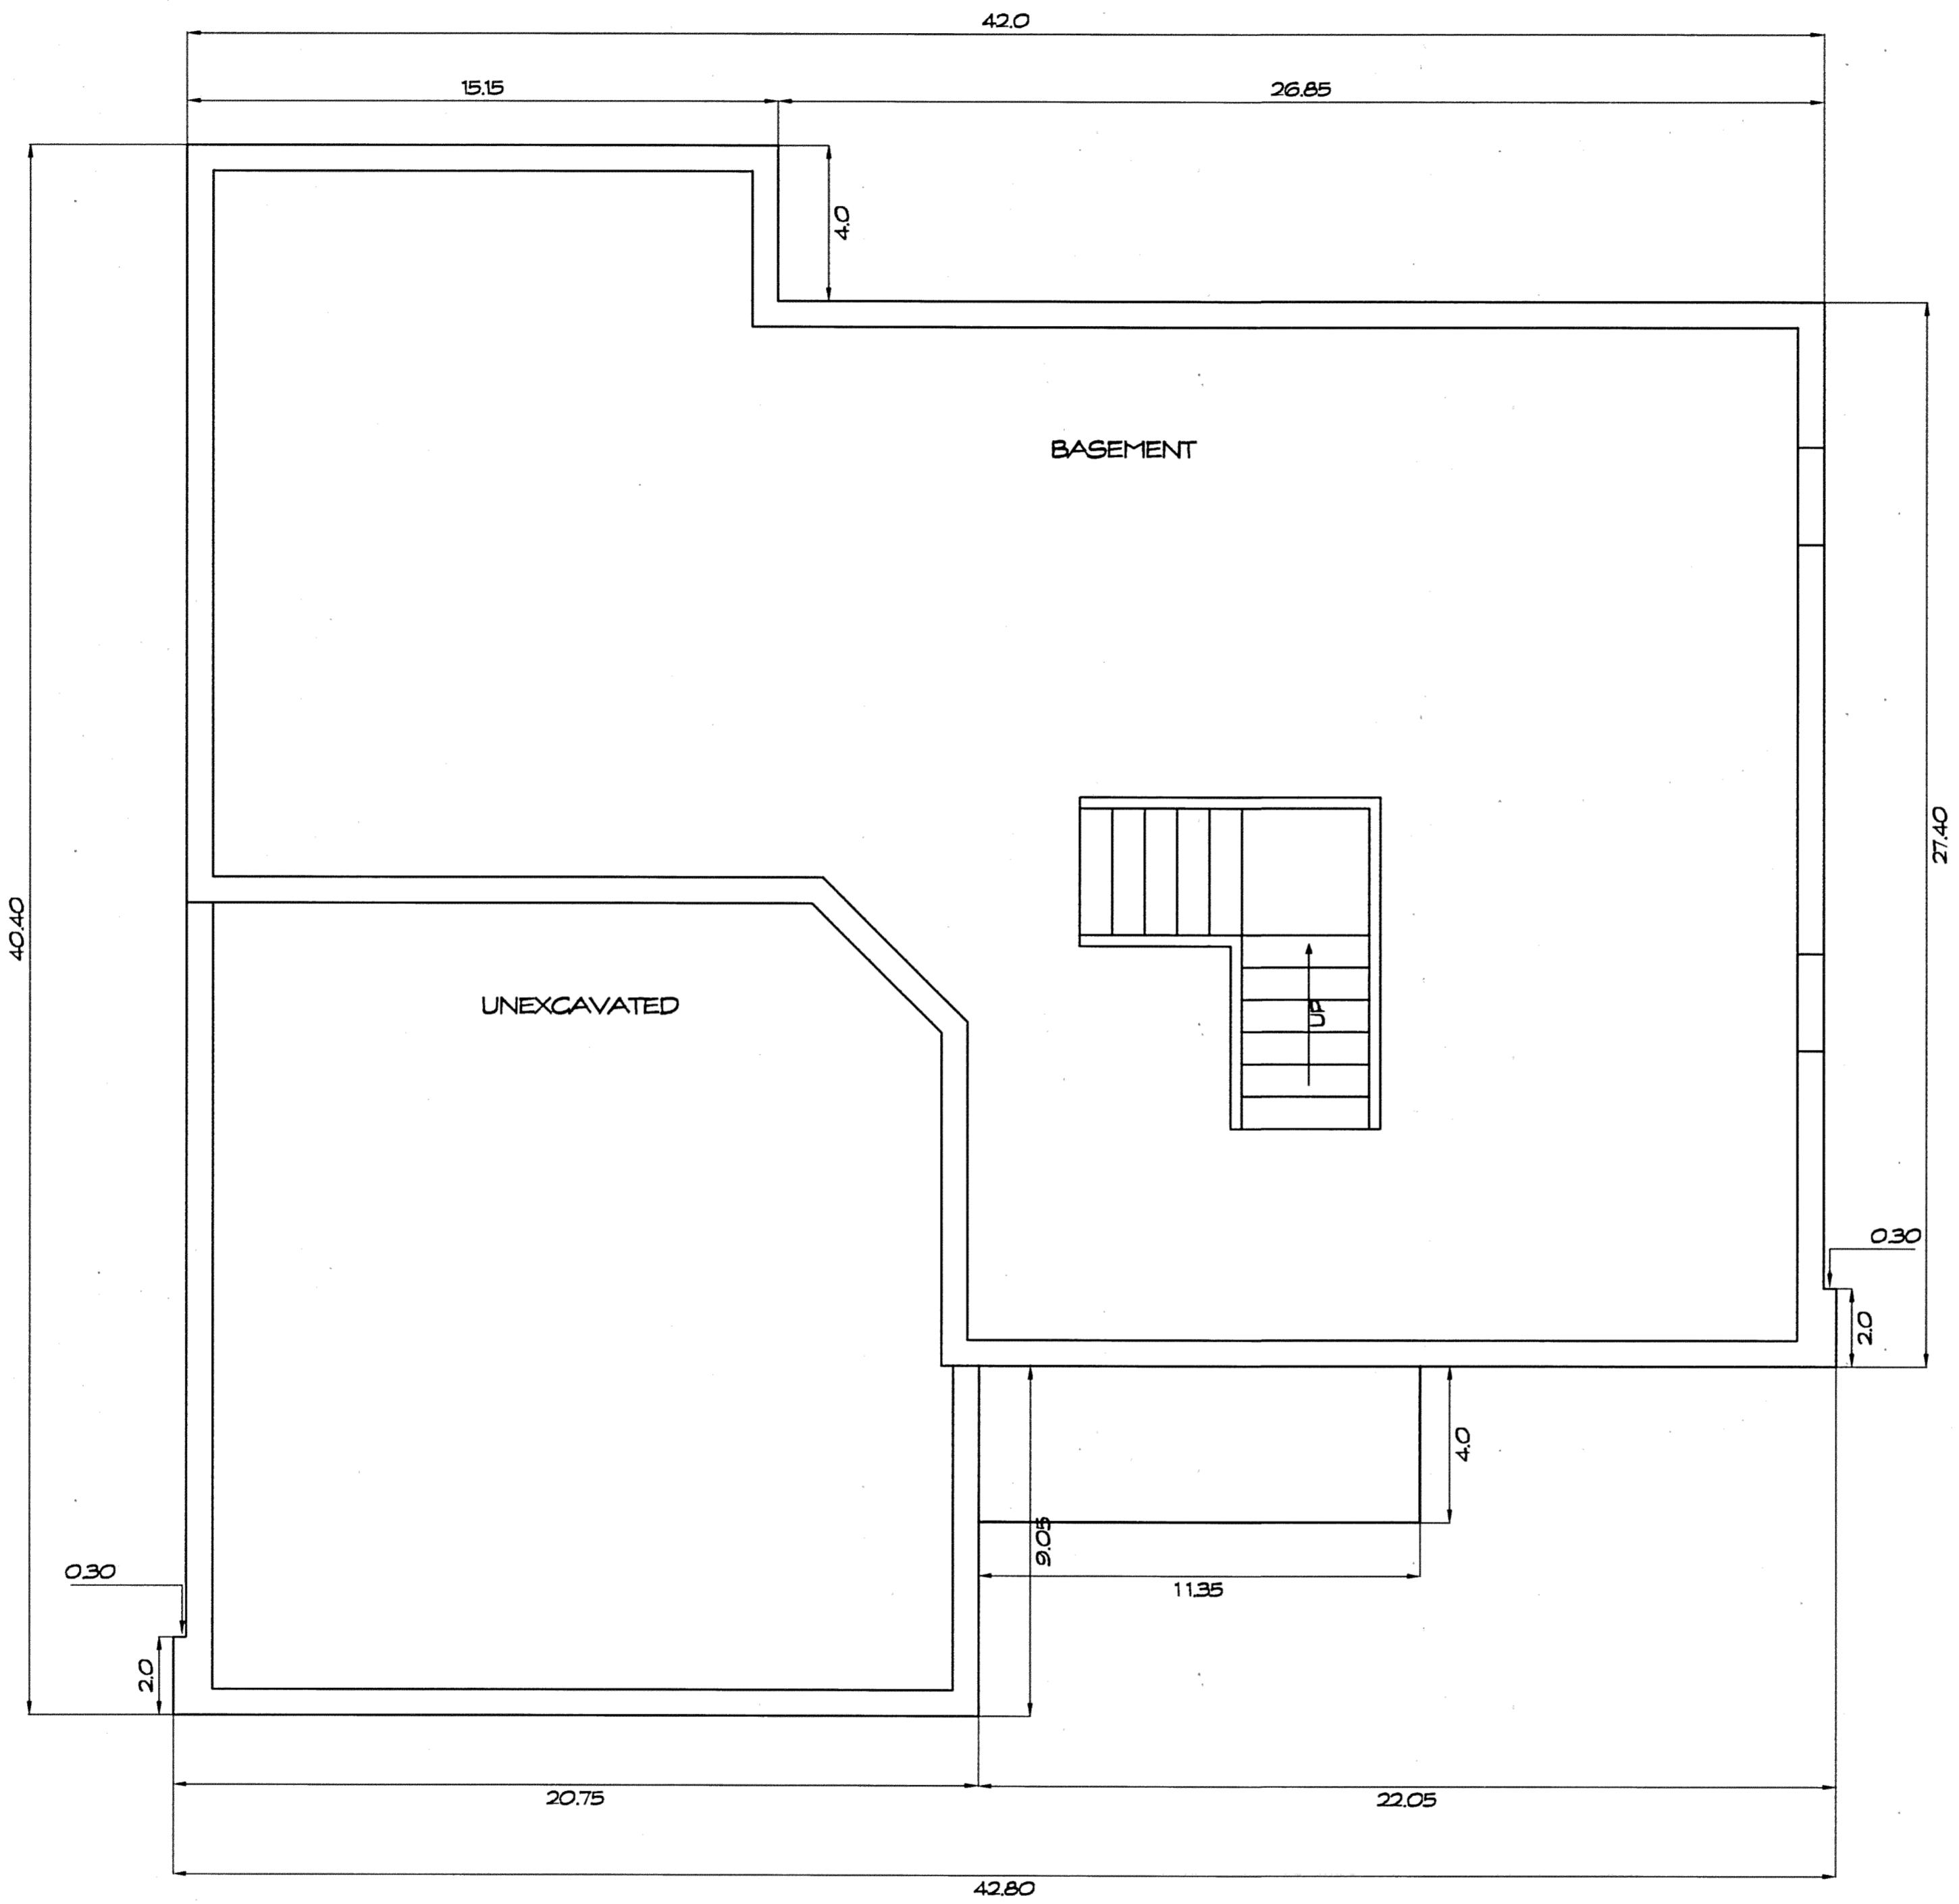


FOUNDATION PLAN
 $1/4'' = 1'-0''$

THE UNDERSIGNED HEREBY CERTIFIES THAT THESE DRAWINGS SHOW GRAPHICALLY, IN SO FAR AS POSSIBLE, THE LAYOUT, LOCATION, DESIGNATION, AND DIMENSIONS OF THE COMMON AREAS AND FACILITIES AND LIMITED COMMON AREAS AND FACILITIES OF THE BUILDINGS AS CONSTRUCTED, IN ALL RESPECTS, WITH THE PROVISIONS OF SECTION 5111.01 OF THE OHIO REVISED CODE.



STEVEN J. LESSMAN, PROFESSIONAL SURVEYOR NO. 7078

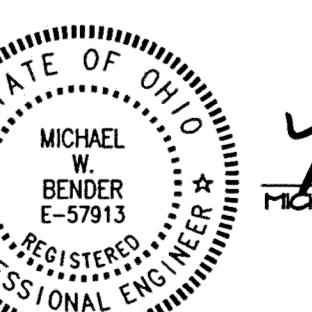

MICHAEL W. BENDER, PROFESSIONAL ENGINEER NO. E-57913

EXHIBIT "A"

DECLARATION OF CONDOMINIUM FOR
AUBURN CROSSINGS

UNIT 35


SCALE: $1/4'' = 1'-0''$ | AUGUST, 2001 SHEET 20 OF 25

LESSMAN, BENDER & ASSOCIATES
Engineers - Surveyors - Planners

Village Station 401 South Street Chardon Ohio 44024
Phone: (440) 286-7204 Fax: (440) 286-3535

V33.P50


UNIT	GARAGE ELEV.		BASEMENT ELEV. FLOOR	CEILING	SQ. FT.	1ST FLOOR ELEV.		SQ. FT.	2ND FLOOR ELEV.		SQ. FT.	TOTAL SQ. FT.	
	FLOOR	CEILING				FLOOR	CEILING		FLOOR	CEILING			
35	1216.60	1226.80	421	1209.74	1217.44	1145	1216.77	See Plan	1190	1227.96	See Plan	1100	3856

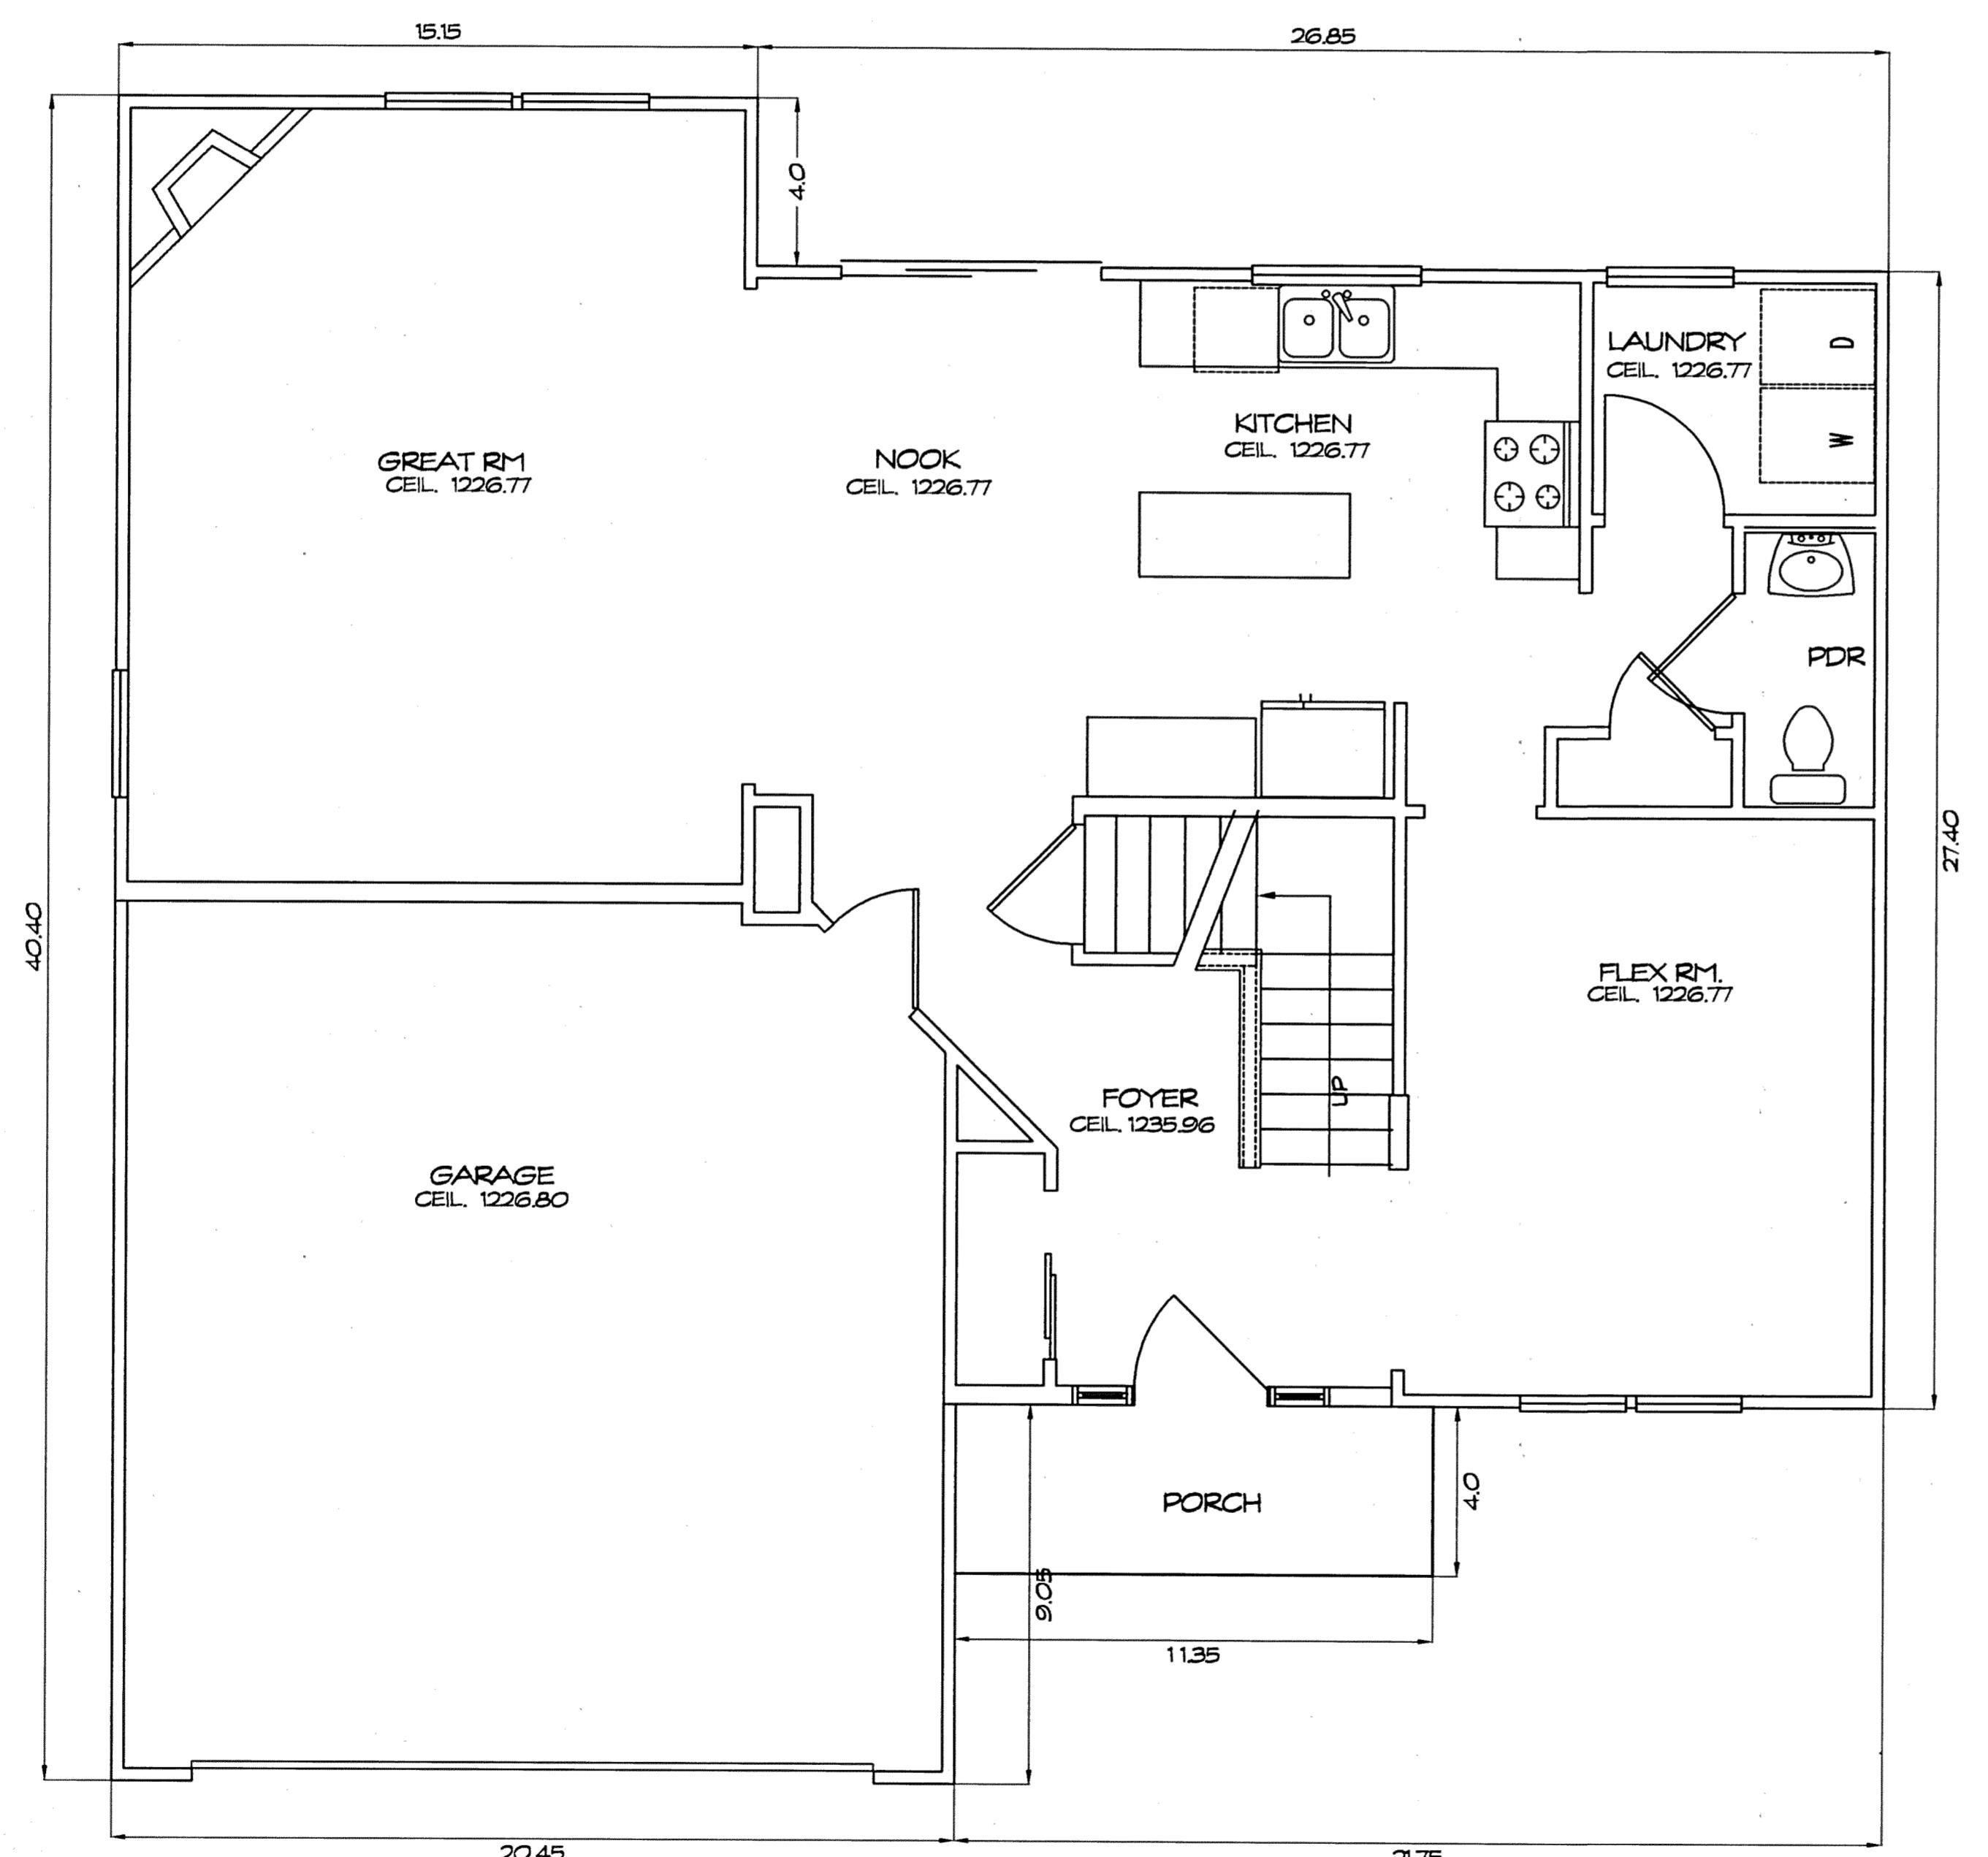

THE UNDERSIGNED HEREBY CERTIFIES THAT THESE DRAWINGS SHOW GRAPHICALLY, IN SO FAR AS POSSIBLE, THE LAYOUT, LOCATION, DESIGNATION, AND DIMENSIONS OF THE COMMON AREAS AND FACILITIES AND LIMITED COMMON AREAS AND FACILITIES OF THE BUILDINGS AS CONSTRUCTED. THE PURPOSE OF THIS CERTIFICATION IS TO COMPLY, IN ALL RESPECTS, WITH THE PROVISIONS OF SECTION 531.107 OF THE OHIO REVISED CODE.



STEVEN J. LESSMAN, PROFESSIONAL SURVEYOR NO. 7078

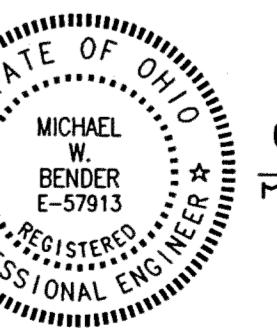

MICHAEL W. BENDER, PROFESSIONAL ENGINEER NO. E-57913


EXHIBIT 'A'

DECLARATION OF CONDOMINIUM FOR AUBURN CROSSINGS

UNIT 35

SCALE: $\frac{1}{4}'' = 1'-0''$ AUGUST, 2001 SHEET 21 OF 25LESSMAN, BENDER & ASSOCIATES
Engineers - Surveyors - PlannersVillage Station 401 South Street Clinton Ohio 44024
Phone: (440) 286-7204 Fax: (440) 286-3535

✓33 · P51

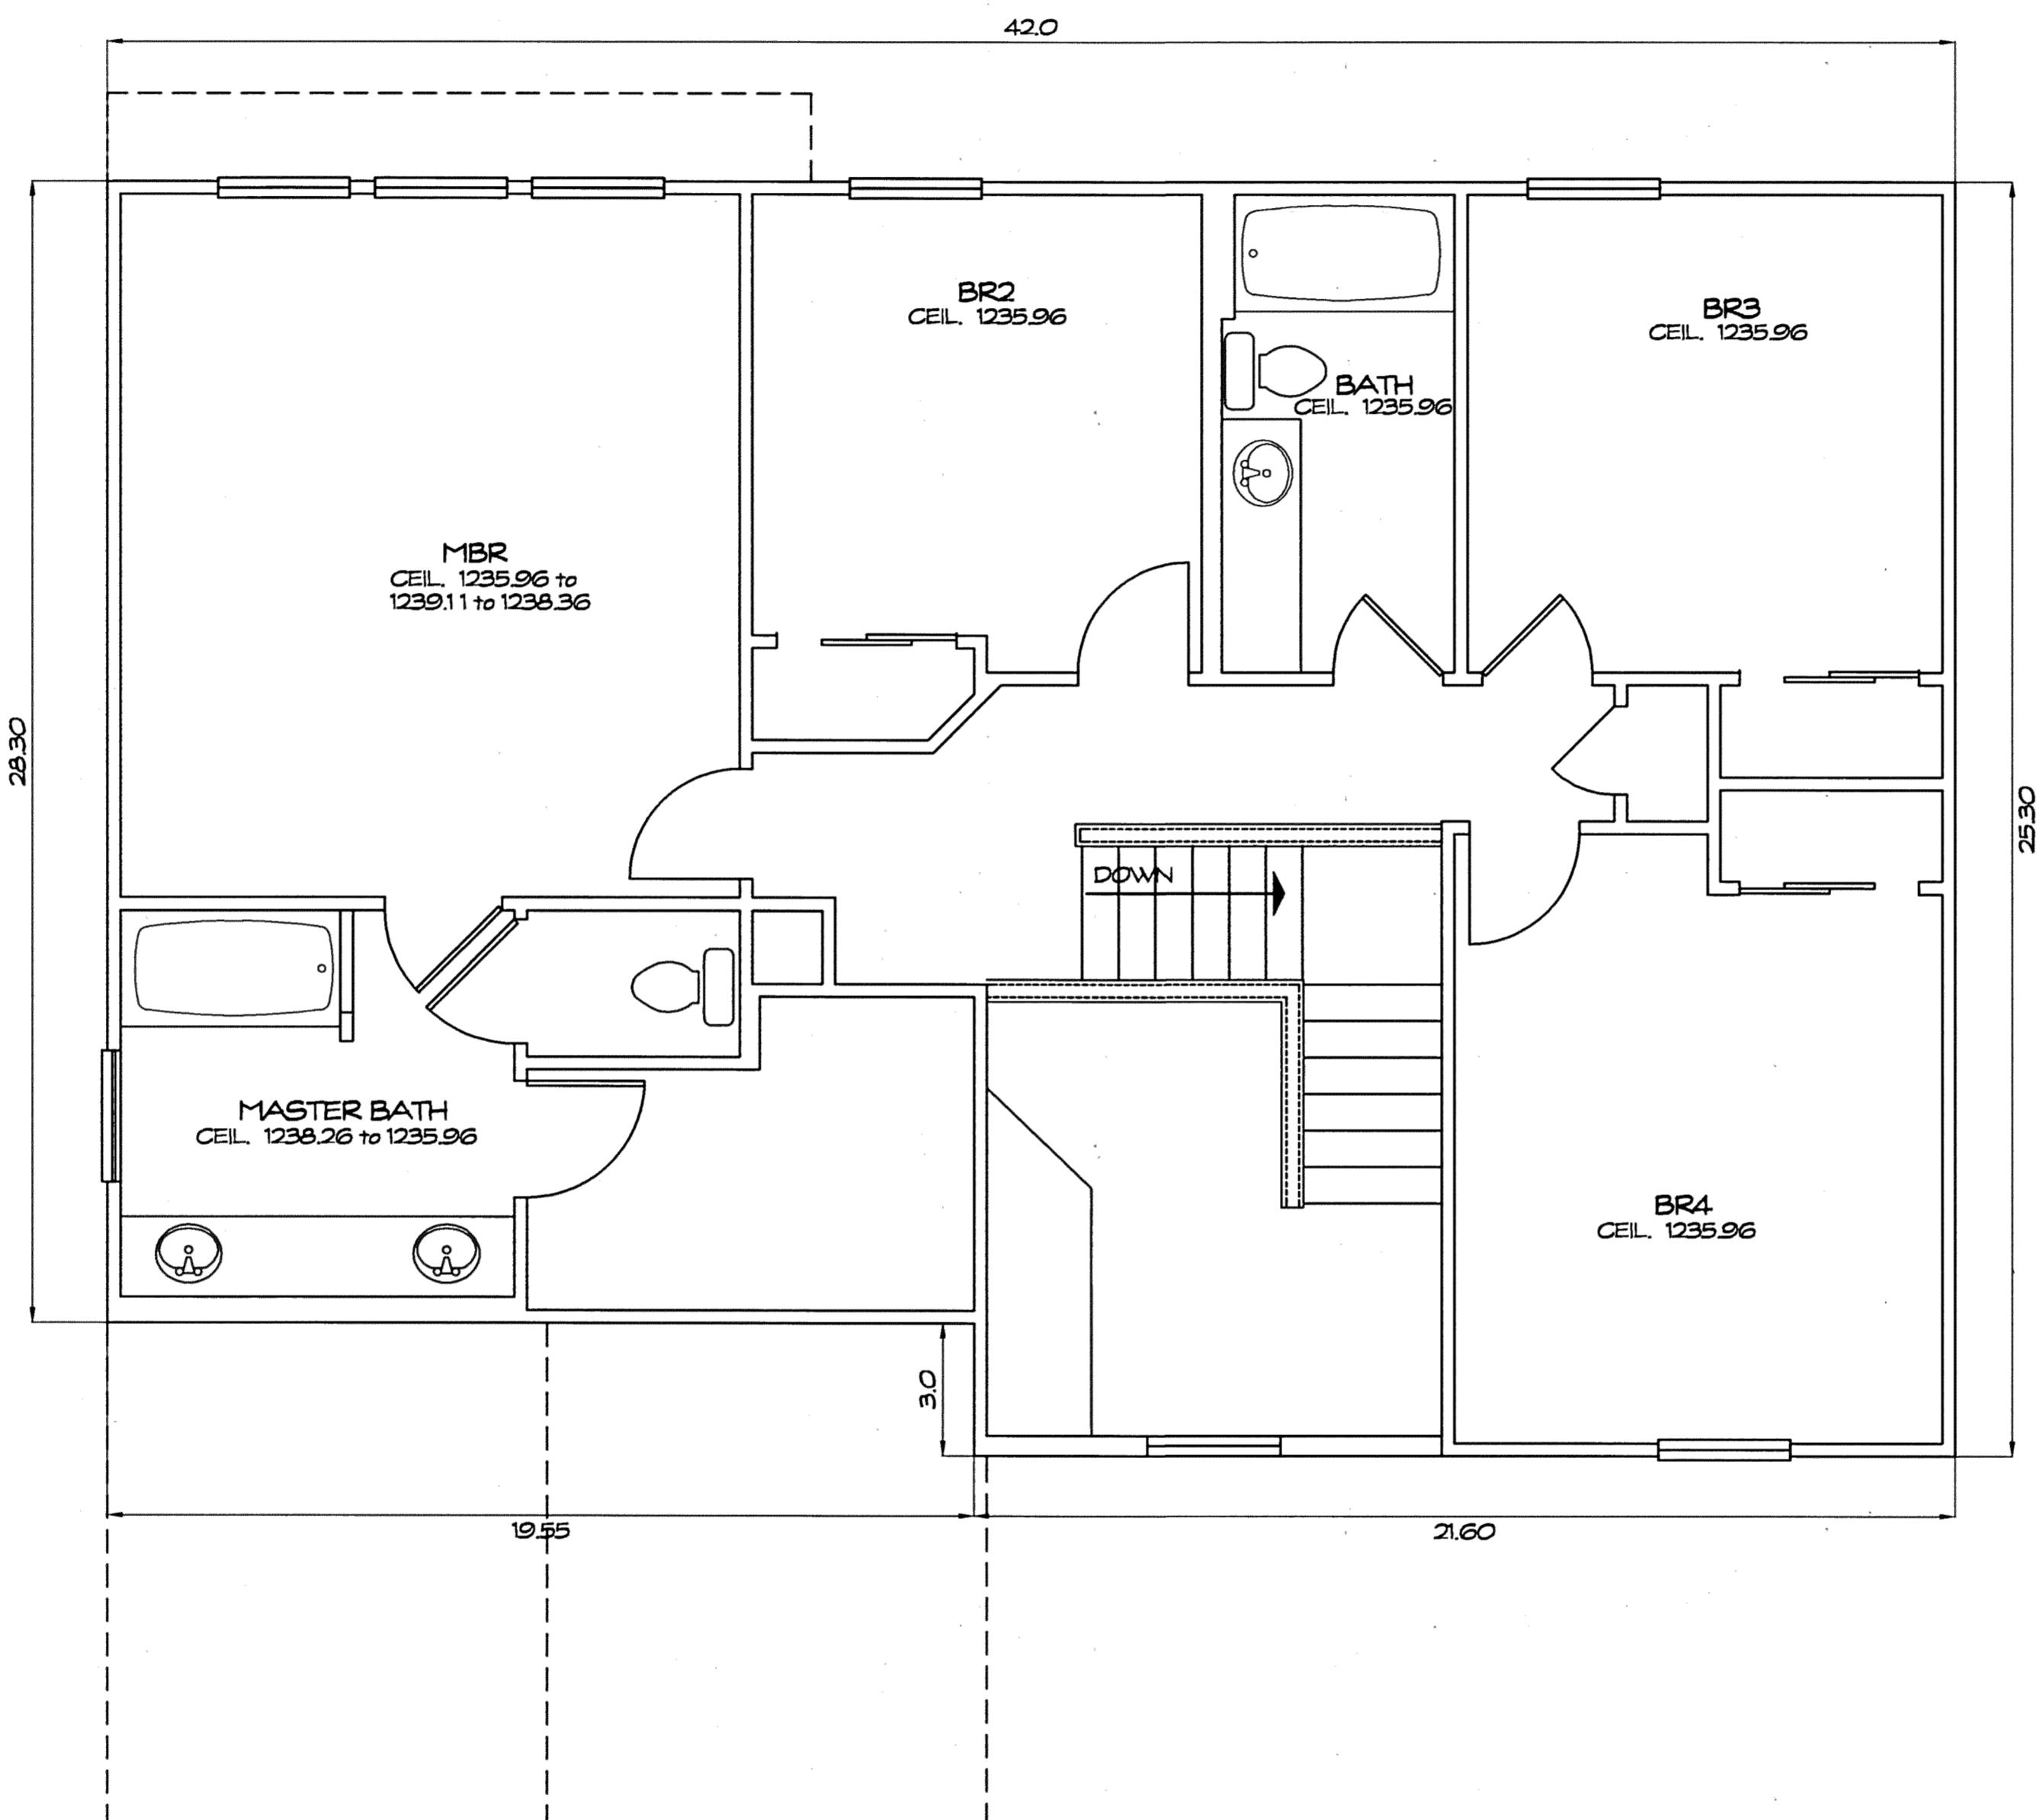


SECOND FLOOR PLAN

1/4" = 1'-0"

THE UNDERSIGNED HEREBY CERTIFIES THAT THESE DRAWINGS SHOW GRAPHICALLY, IN SO FAR AS POSSIBLE, THE LAYOUT, LOCATION, DESIGNATION, AND DIMENSIONS OF THE COMMON AREAS AND FACILITIES AND LIMITED COMMON AREAS AND FACILITIES OF THE BUILDINGS AS CONSTRUCTED. THE PURPOSE OF THIS CERTIFICATION IS TO COMPLY, IN ALL RESPECTS, WITH THE PROVISIONS OF SECTION 531.107 OF THE OHIO REVISED CODE.



STEVEN J. LESSMAN, PROFESSIONAL SURVEYOR NO. 7078

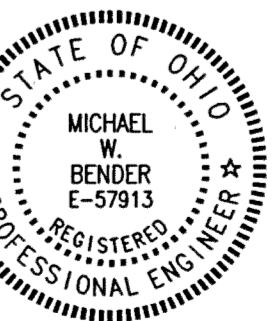

MICHAEL W. BENDER, PROFESSIONAL ENGINEER NO. E-57913

EXHIBIT "A"

DECLARATION OF CONDOMINIUM FOR
AUBURN CROSSINGS

UNIT 35


SCALE: 1/4" = 1'-0" AUGUST, 2001 SHEET 22 OF 25

LESSMAN, BENDER & ASSOCIATES
Engineers - Surveyors - Planners

Village Station 401 South Street Chardon Ohio 44024

Phone: (440) 286-7204 Fax: (440) 286-3335


V33 · P52

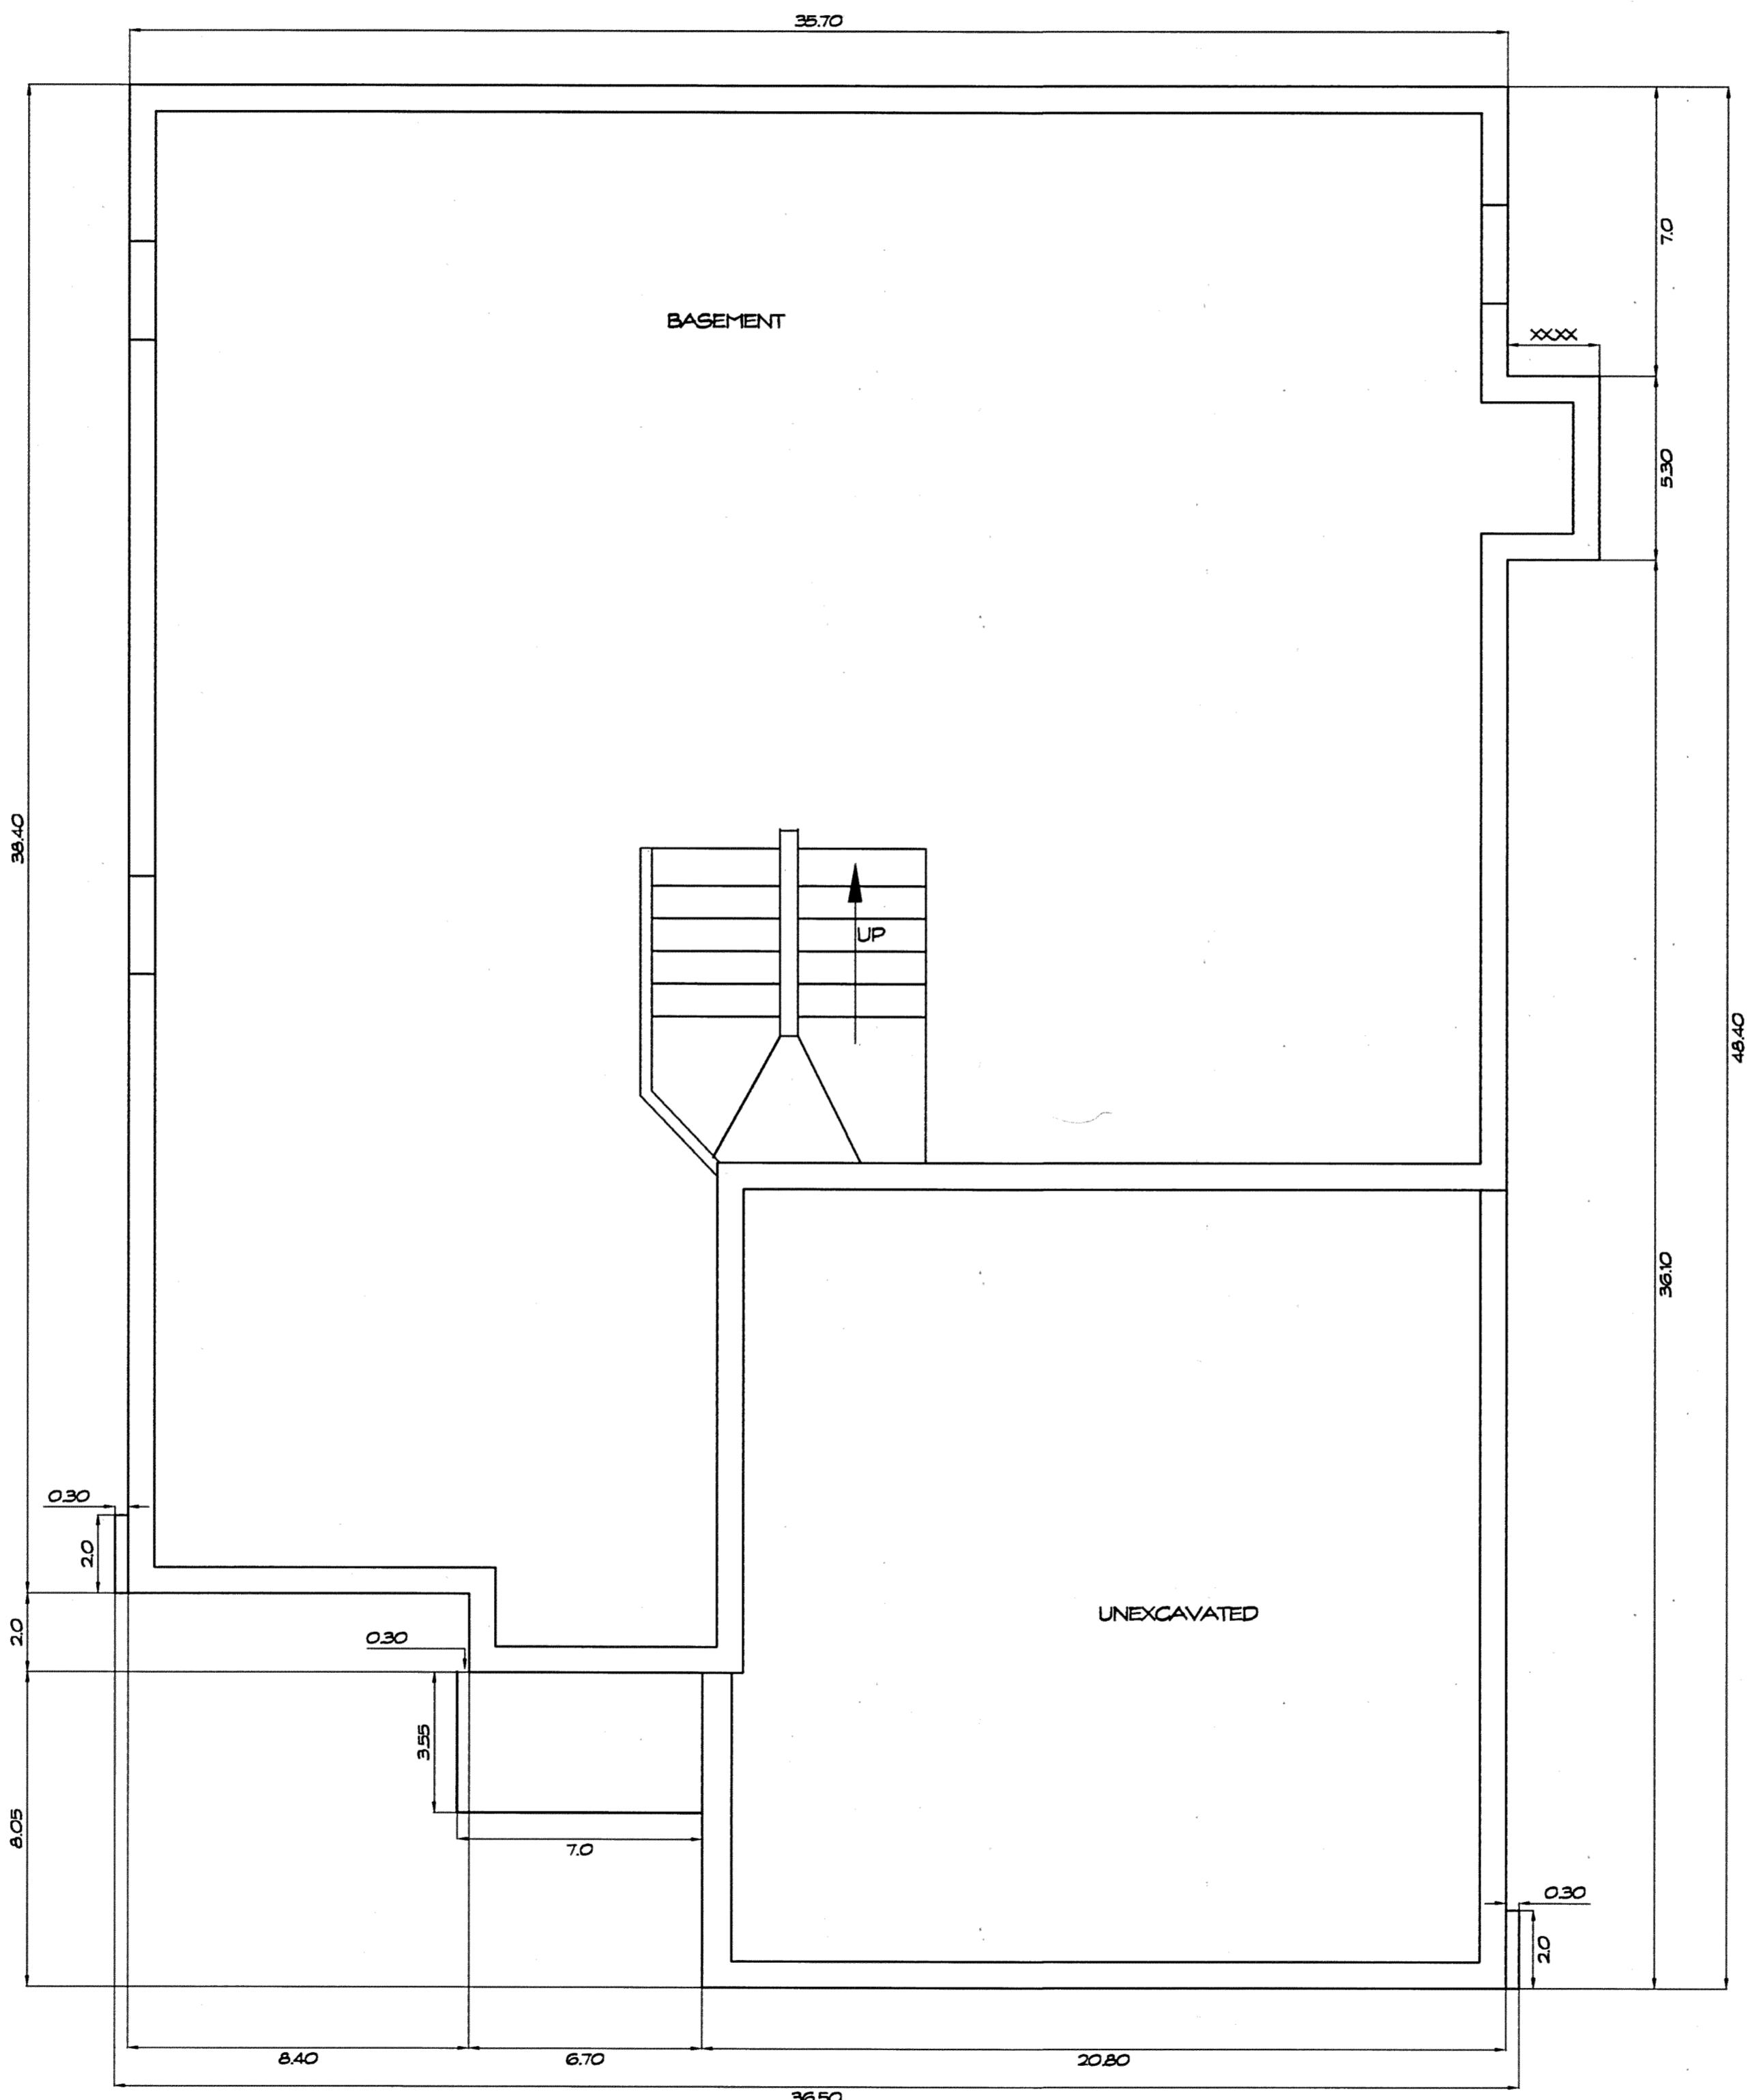


FOUNDATION PLAN

1/4" = 1'-0"

THE UNDERSIGNED HEREBY CERTIFIES THAT THESE DRAWINGS SHOW GRAPHICALLY, IN SO FAR AS POSSIBLE, THE LAYOUT, LOCATION, DESIGNATION, AND DIMENSIONS OF THE COMMON AREAS AND FACILITIES AND LIMITED COMMON AREAS AND FACILITIES OF THE BUILDINGS AS CONSTRUCTED. THE PURPOSE OF THIS CERTIFICATION IS TO COMPLY, IN ALL RESPECTS, WITH THE PROVISIONS OF SECTION 501 OF THE OHIO REVISED CODE.

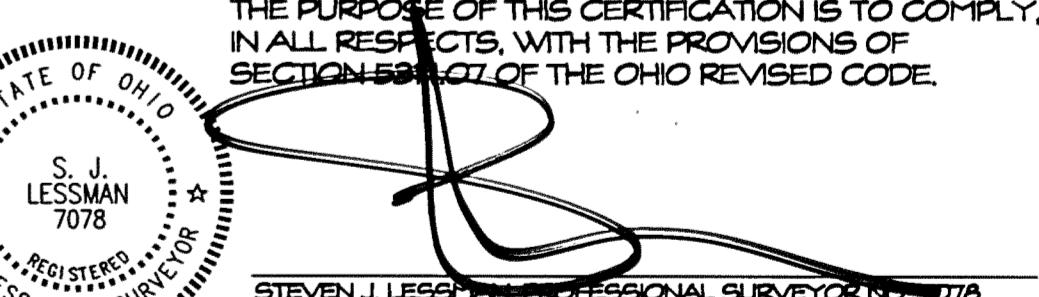

STEVEN J. LESSMAN, PROFESSIONAL SURVEYOR NO. 7078

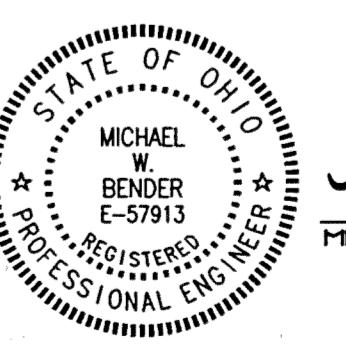

MICHAEL W. BENDER, PROFESSIONAL ENGINEER NO. E-57913

EXHIBIT 'A'


DECLARATION OF CONDOMINIUM FOR
AUBURN CROSSINGS

UNIT 43


SCALE: 1/4" = 1'-0" | AUGUST, 2001 | SHEET 23 OF 25

LESSMAN, BENDER & ASSOCIATES
Engineers - Surveyors - PlannersVillage Station 401 South Street Chardon Ohio 44024
Phone: (440) 286-7204 Fax: (440) 286-3535


✓33-P53

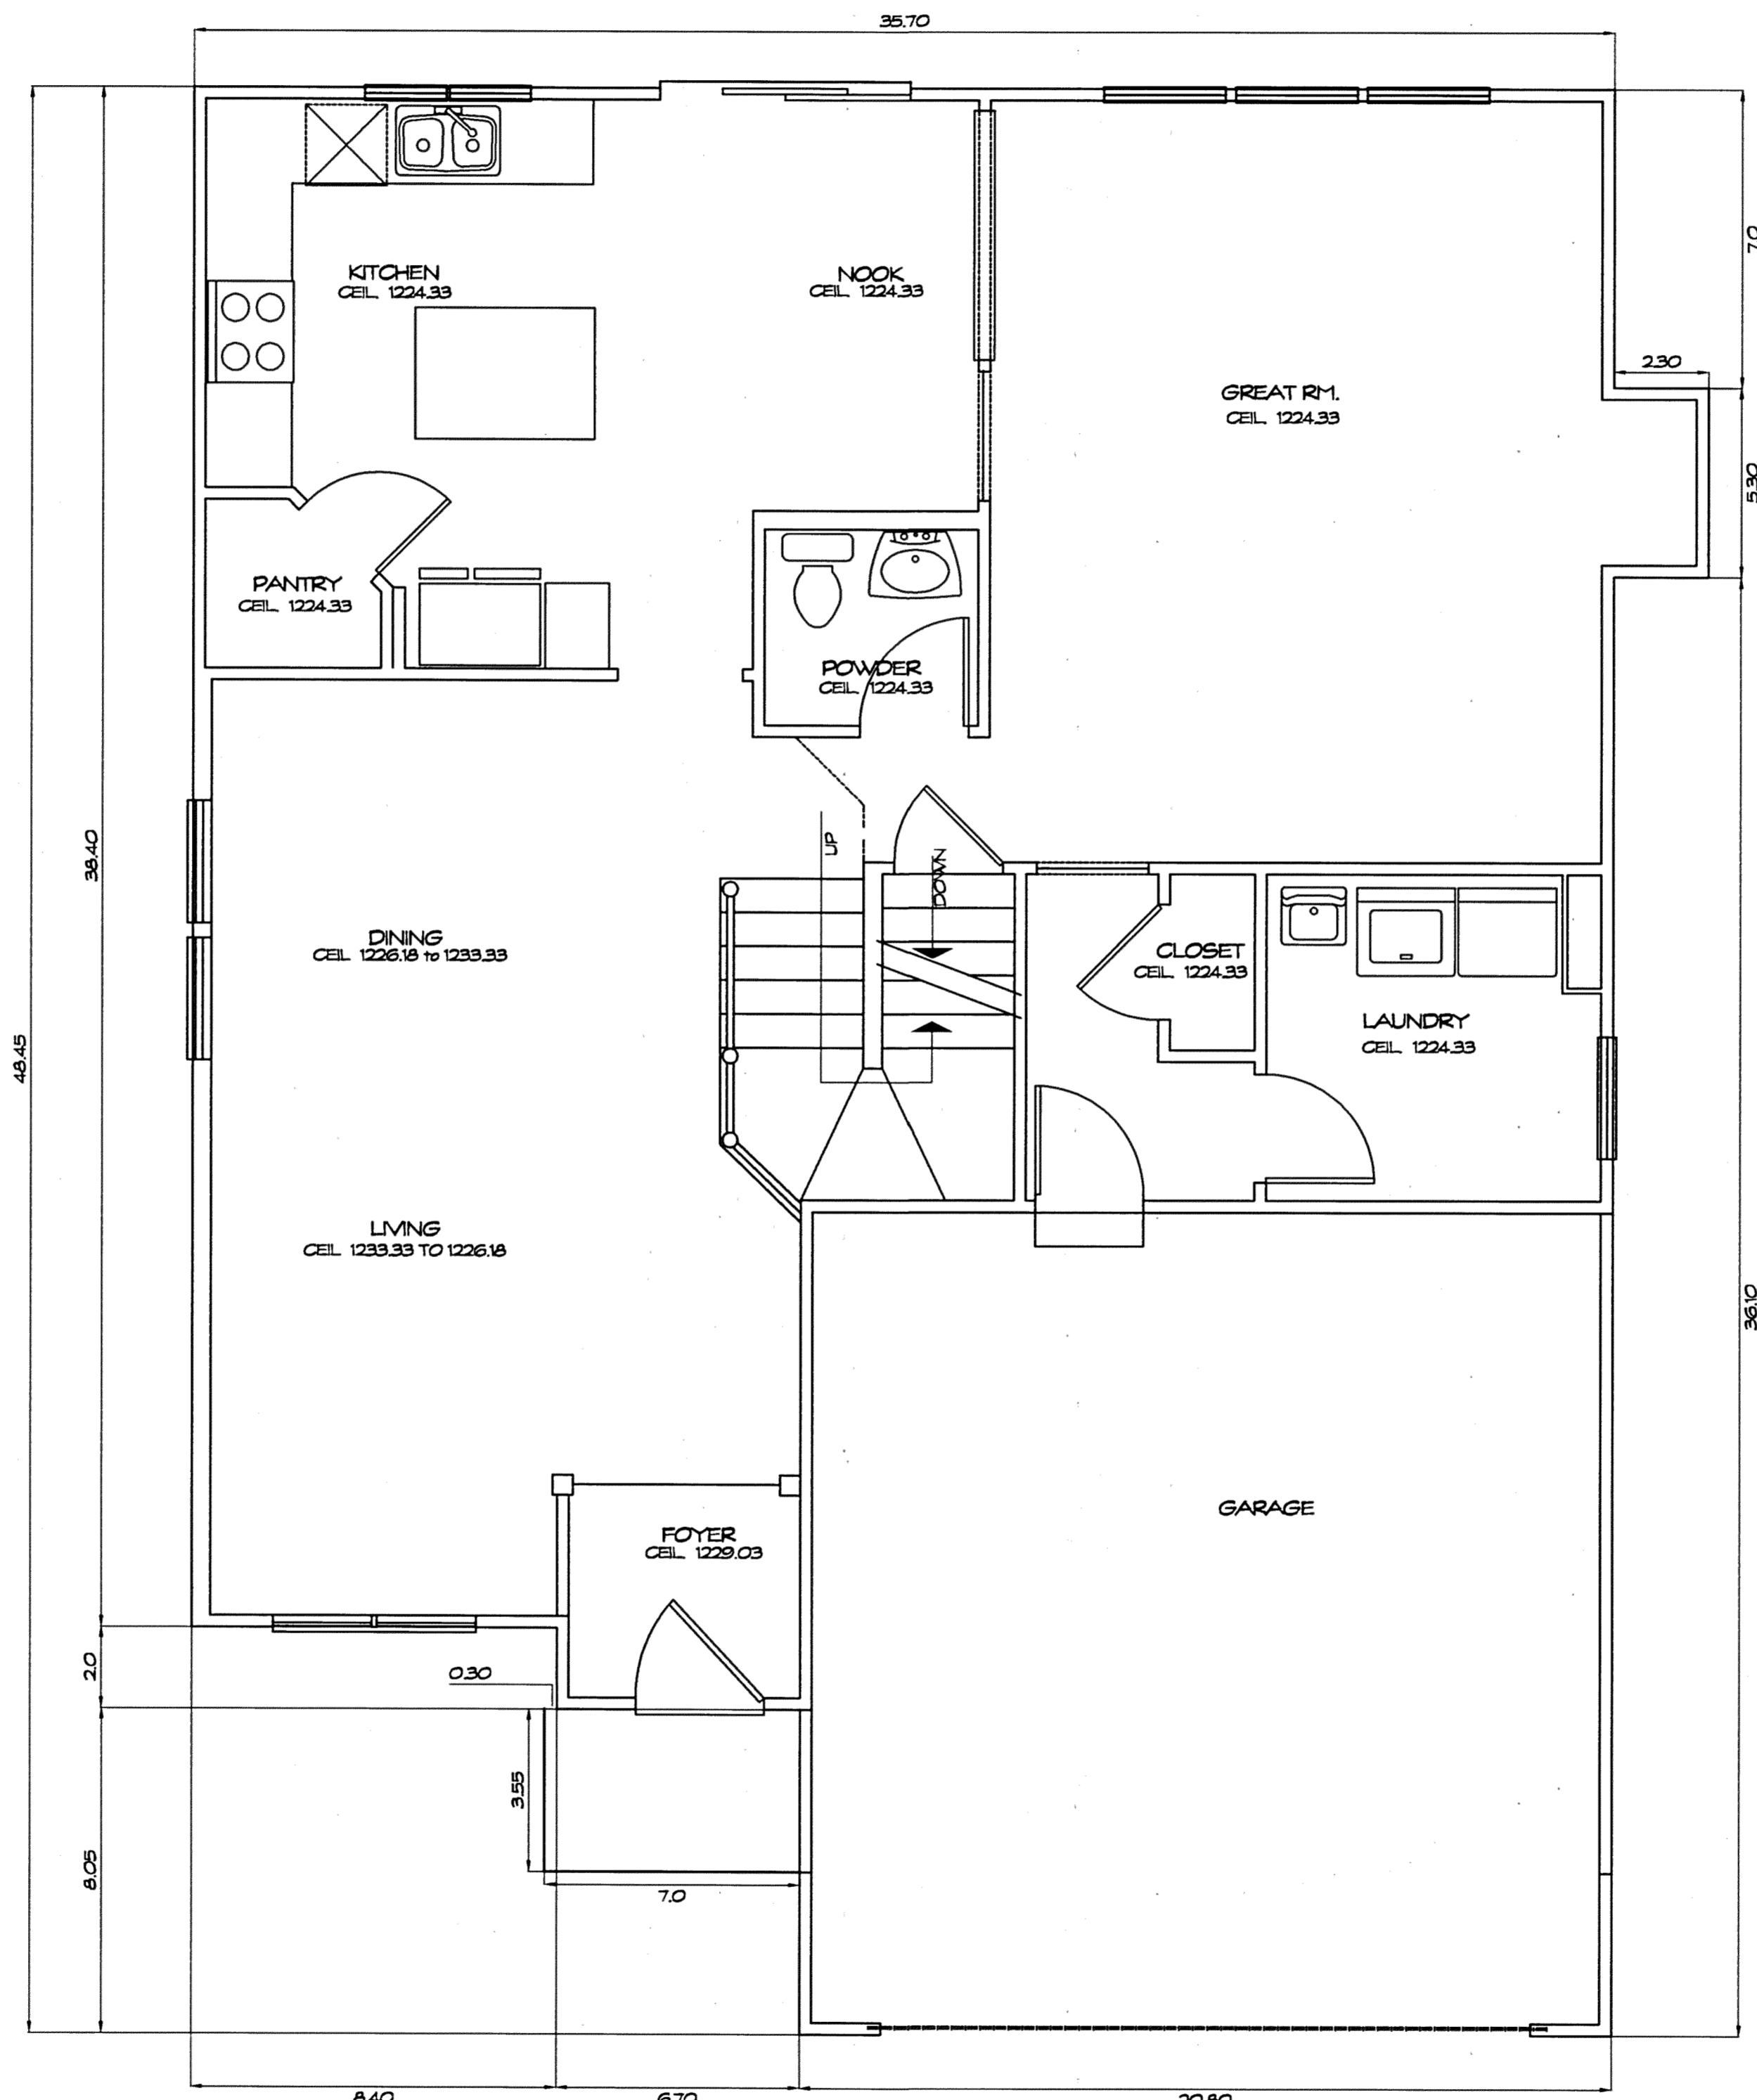

THE UNDERSIGNED HEREBY CERTIFIES THAT THESE DRAWINGS SHOW GRAPHICALLY, IN SO FAR AS POSSIBLE, THE LAYOUT, LOCATION, DESIGNATION, AND DIMENSIONS OF THE COMMON AREAS AND FACILITIES AND LIMITED COMMON AREAS AND FACILITIES OF THE BUILDINGS AS CONSTRUCTED. THE PURPOSE OF THIS CERTIFICATION IS TO COMPLY, IN ALL RESPECTS, WITH THE PROVISIONS OF SECTION 3901.02 OF THE OHIO REVISED CODE.

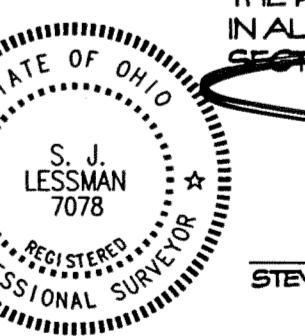

STEVEN J. LESSMAN, PROFESSIONAL SURVEYOR NO. 7078

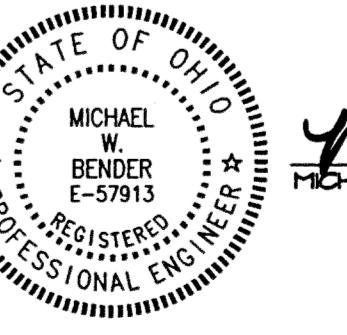

MICHAEL W. BENDER, PROFESSIONAL ENGINEER NO. E-57913


EXHIBIT A

DECLARATION OF CONDOMINIUM FOR
AUBURN CROSSINGS

UNIT 43

SCALE: $\frac{1}{4}'' = 1'-0''$ AUGUST, 2001 SHEET 24 OF 25LESSMAN, BENDER & ASSOCIATES
Engineers - Surveyors - PlannersVillage Station 401 South Street Chardon Ohio 44024
Phone: (440) 266-7204 Fax: (440) 266-3535

V33-P54

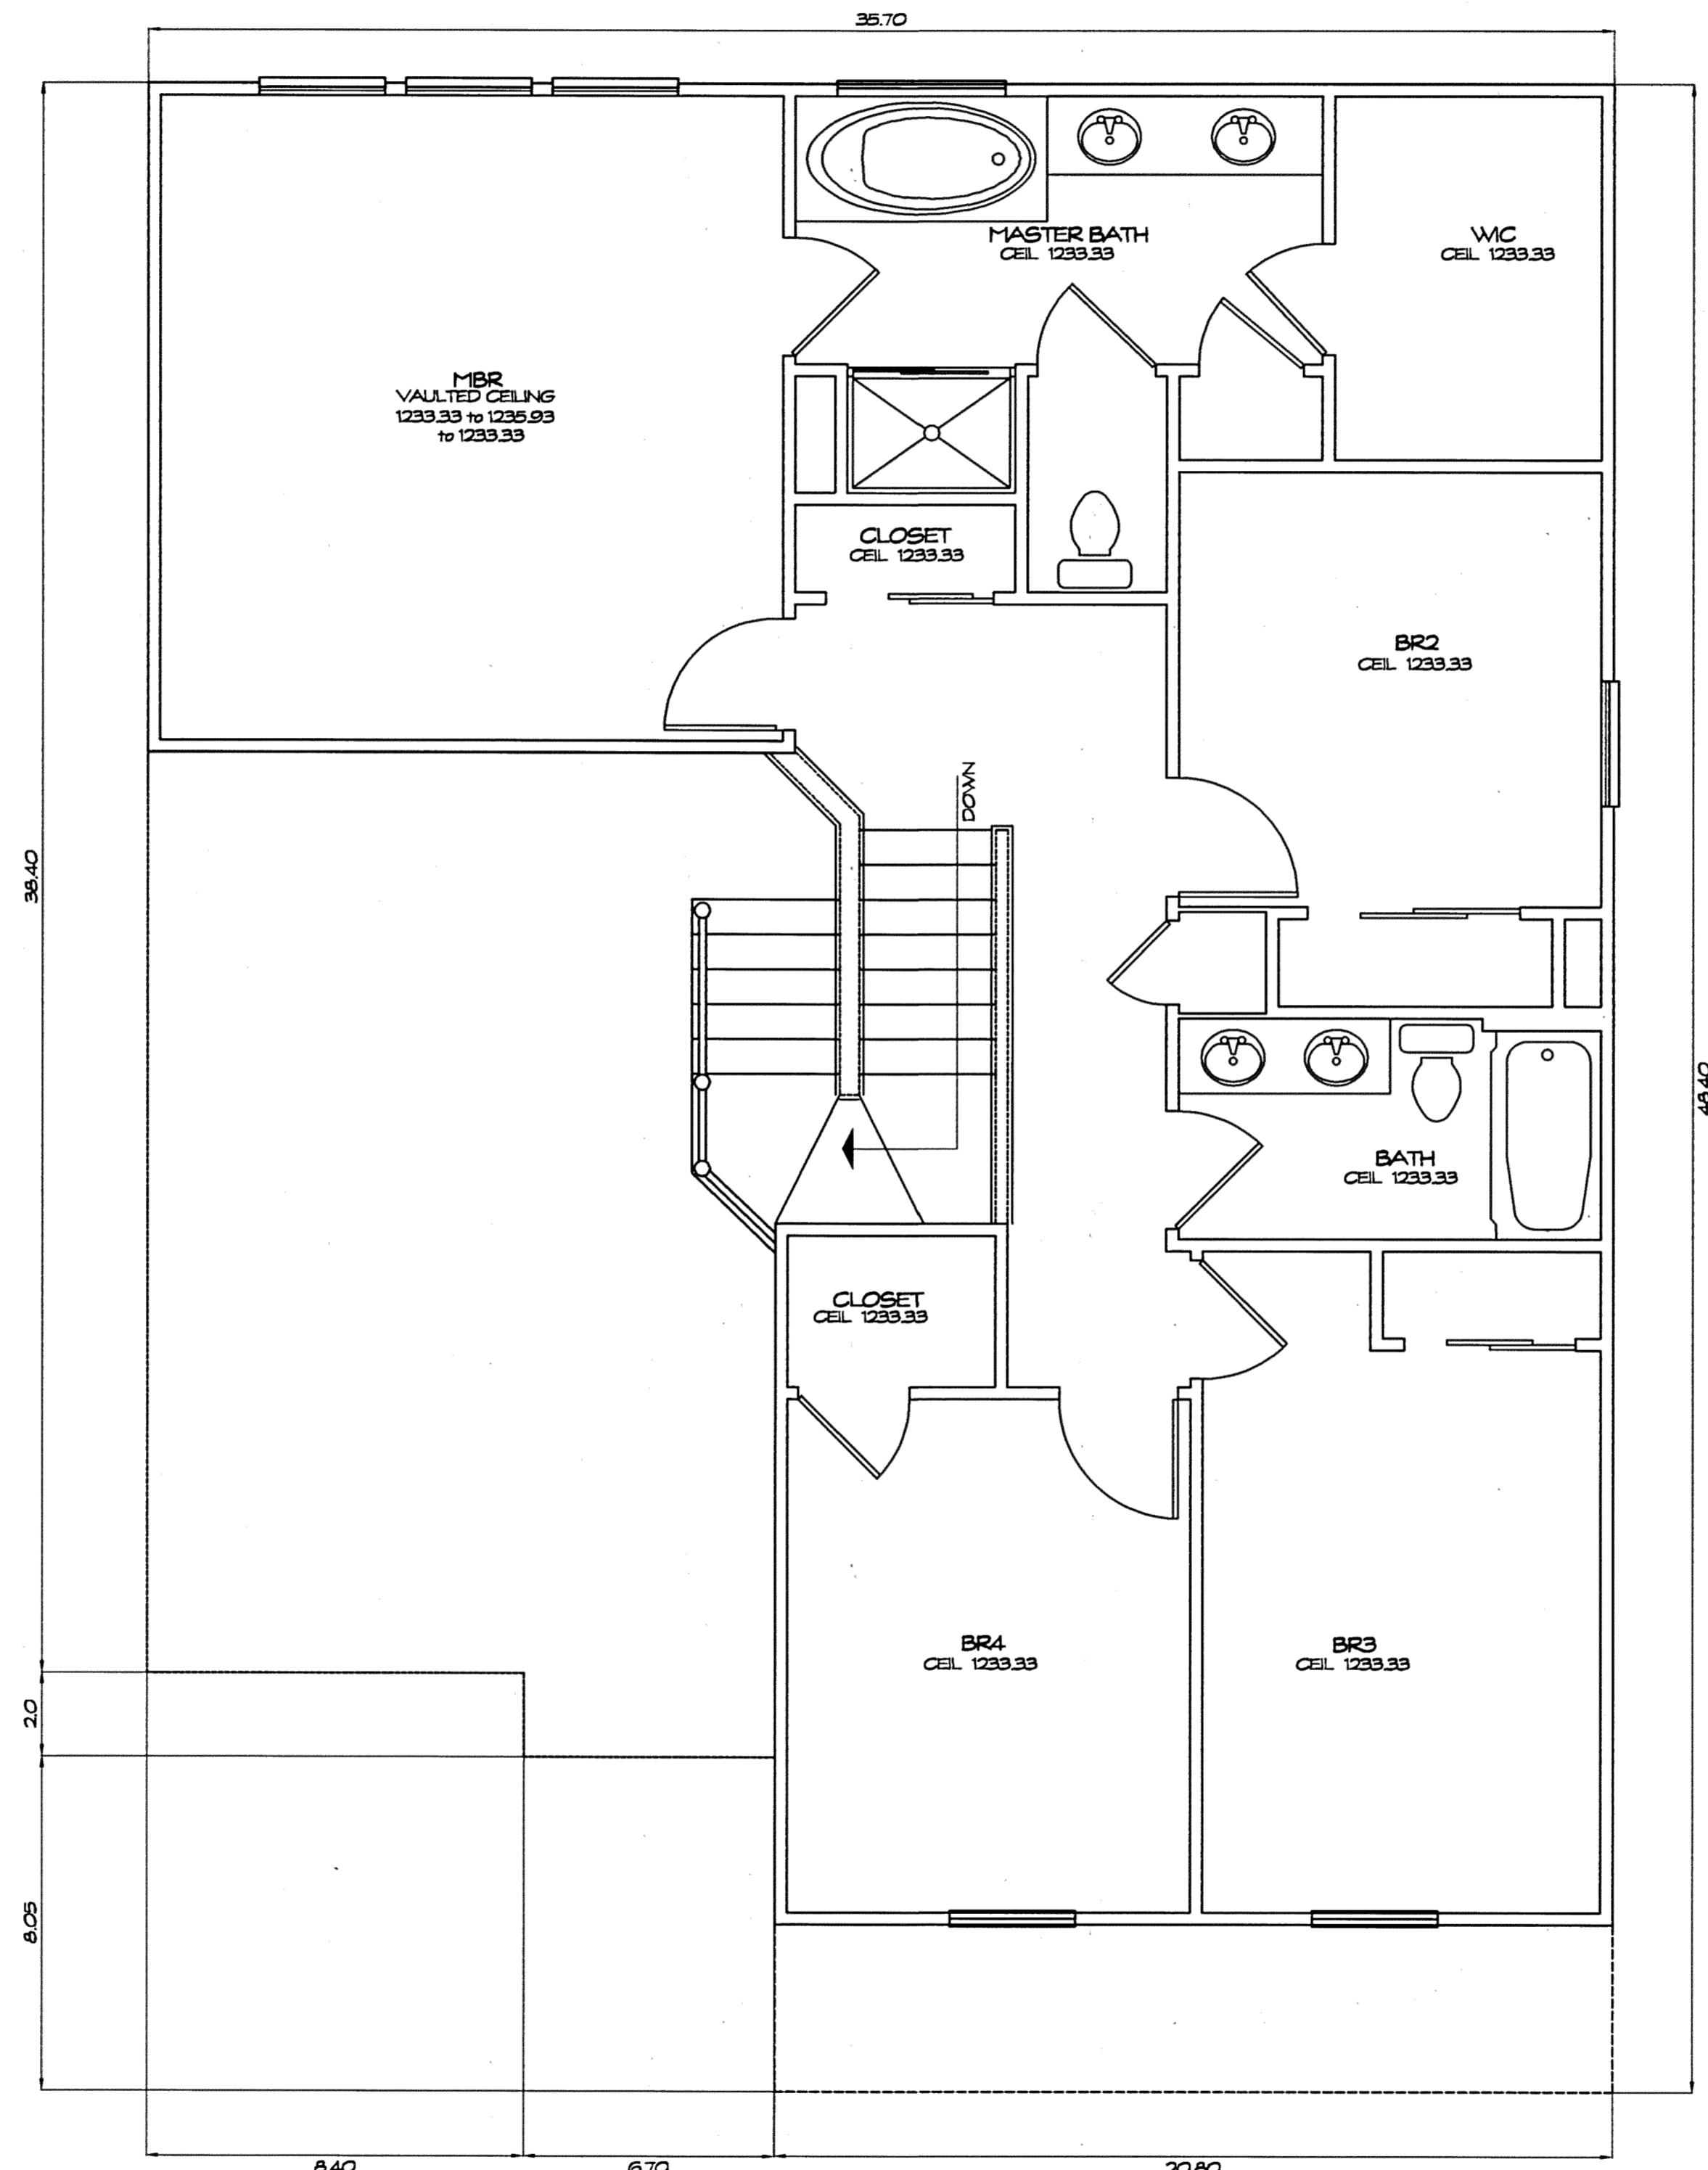


SECOND FLOOR PLAN
V4'=1'-0"

V33. P55

THE UNDERSIGNED HEREBY CERTIFIES THAT THESE DRAWINGS SHOW GRAPHICALLY, IN SO FAR AS POSSIBLE, THE LAYOUT, LOCATION, DESIGNATION, AND DIMENSIONS OF THE COMMON AREAS AND FACILITIES AND LIMITED COMMON AREAS AND FACILITIES OF THE BUILDINGS AS CONSTRUCTED. THE PURPOSE OF THIS CERTIFICATION IS TO COMPLY, IN ALL RESPECTS, WITH THE PROVISIONS OF SECTION 1007.1 OF THE OHIO REVISED CODE.



STEVEN J. LESSMAN, PROFESSIONAL SURVEYOR NO. 7078

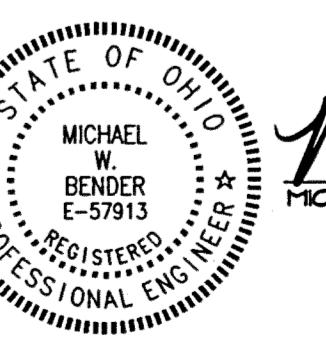

MICHAEL W. BENDER, PROFESSIONAL ENGINEER NO. E-57913

EXHIBIT 'A'

DECLARATION OF CONDOMINIUM FOR
AUBURN CROSSINGS

UNIT 43

SCALE: V4'=1'-0" AUGUST, 2001 SHEET 25 OF 25

LESSMAN, BENDER & ASSOCIATES
Engineers - Surveyors - Planners

Village Station 401 South Street Chardon Ohio 44024
Phone: (440) 286-7204 Fax: (440) 286-3335