


SAFCO PRODUCTS • NEW HADE, MINNESOTA
 REPRODUCED BY PART NUMBER 6532

SAFCO PRODUCTS • NEW HADE, MINNESOTA
 REPRODUCED BY PART NUMBER 6532

SAFCO PRODUCTS • NEW HADE, MINNESOTA
 REPRODUCED BY PART NUMBER 6532

SAFCO PRODUCTS • NEW HADE, MINNESOTA
 REPRODUCED BY PART NUMBER 6532

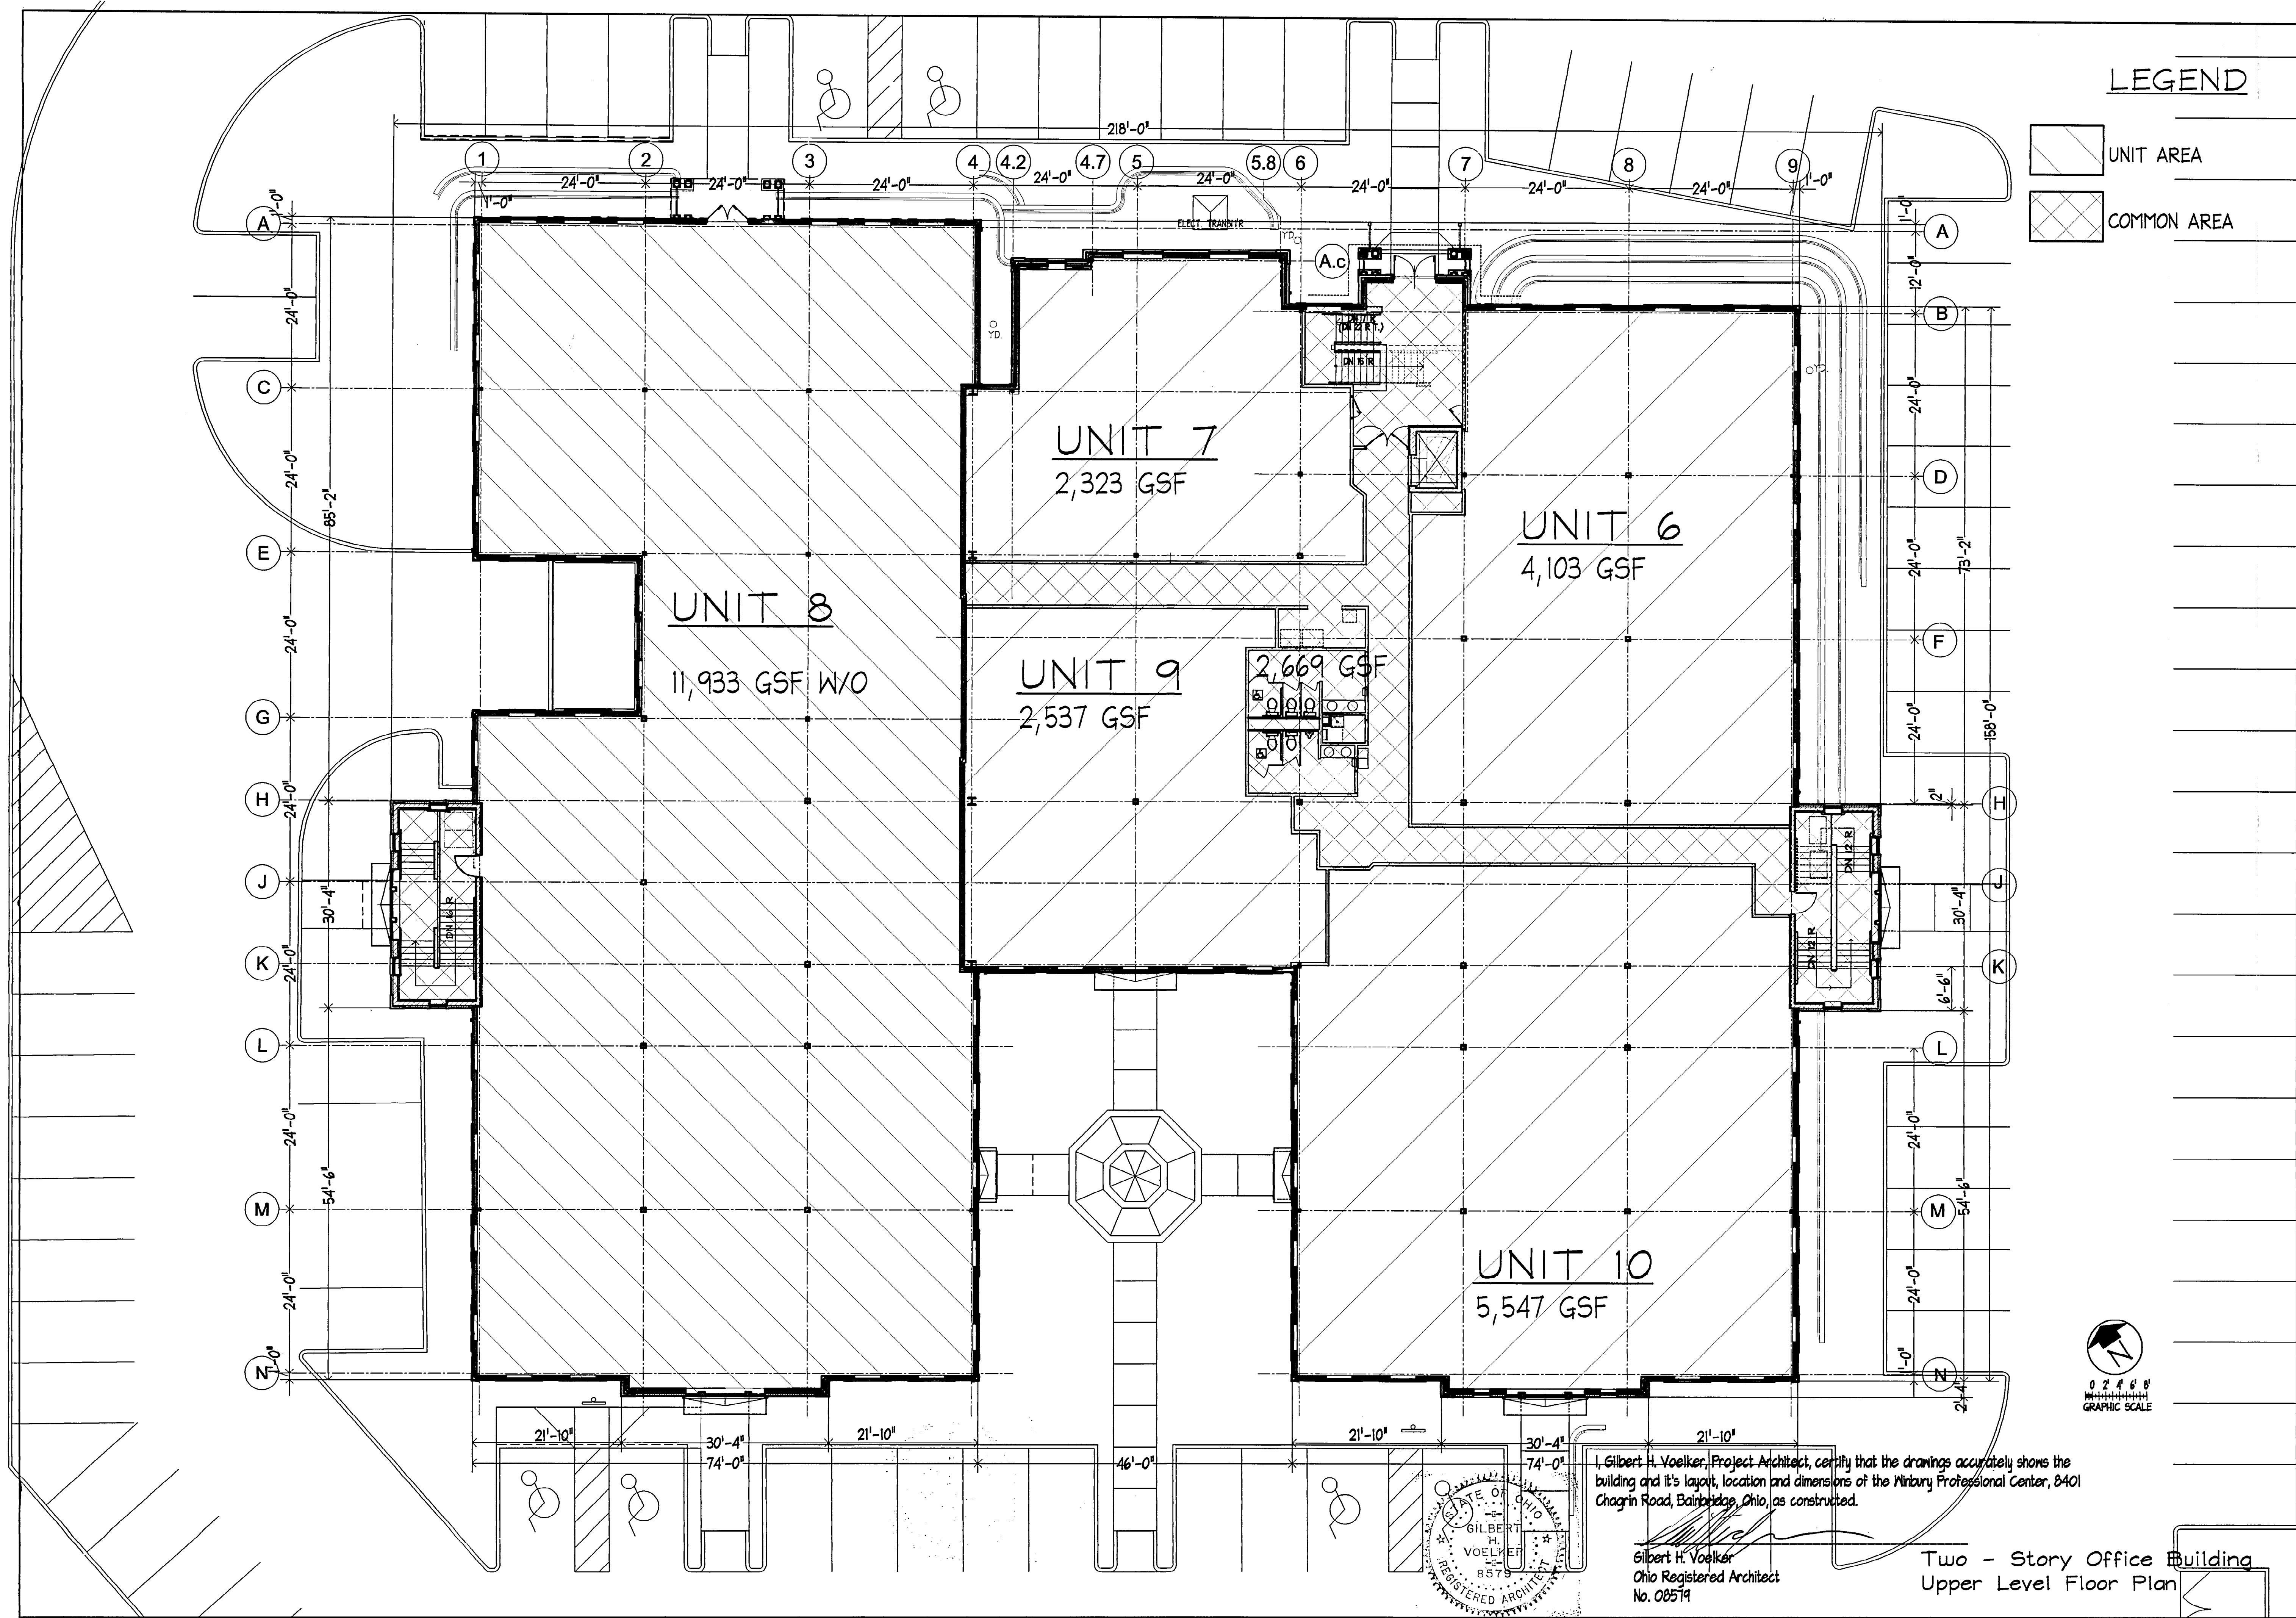

LEGEND

- UNIT AREA
- COMMON AREA

I, Gilbert H. Voelker, Project Architect, certify that the drawings accurately shows the building and it's layout, location and dimensions of the Winbury Professional Center, 8401 Chagrin Road, Bainbridge, Ohio, as constructed.

Gilbert H. Voelker
 Ohio Registered Architect
 No. 085719

Two - Story Office Building
 Upper Level Floor Plan

Condominium Plan

S 46°57'46" W 385.84'
Winbury Professional Center
 8401 Chagrin Road
 Bainbridge, Ohio

RBI Design Group

8225 BRECKSVILLE ROAD • CLEVELAND, OHIO 44141

DATE: 18 MAR 04
 SCALE: 3/32"=1'-0"
 JOB No.:

C-2

