

Vacations by Cert. of
County Auditor
H. H. Occubeeck
Recorder
1-23-56


THE BASS LAKE RESERVE CO'S SUBDIVISION N^o 2 AND RESUBDIVISION OF SUBDIVISION N^o 1

Being a part of Geauga County, and Original Munson Township, Lot No. 10,
East Division, Tract No. 1; and Lot No. 7 & 10, Tract No. 2.

Dimensions are given in feet and decimal parts thereof.
All of which I certify to be correct.
AUG. 1923.

F. R. ZETHMAYR
Engineer.

SCALE 1 inch = 100 feet

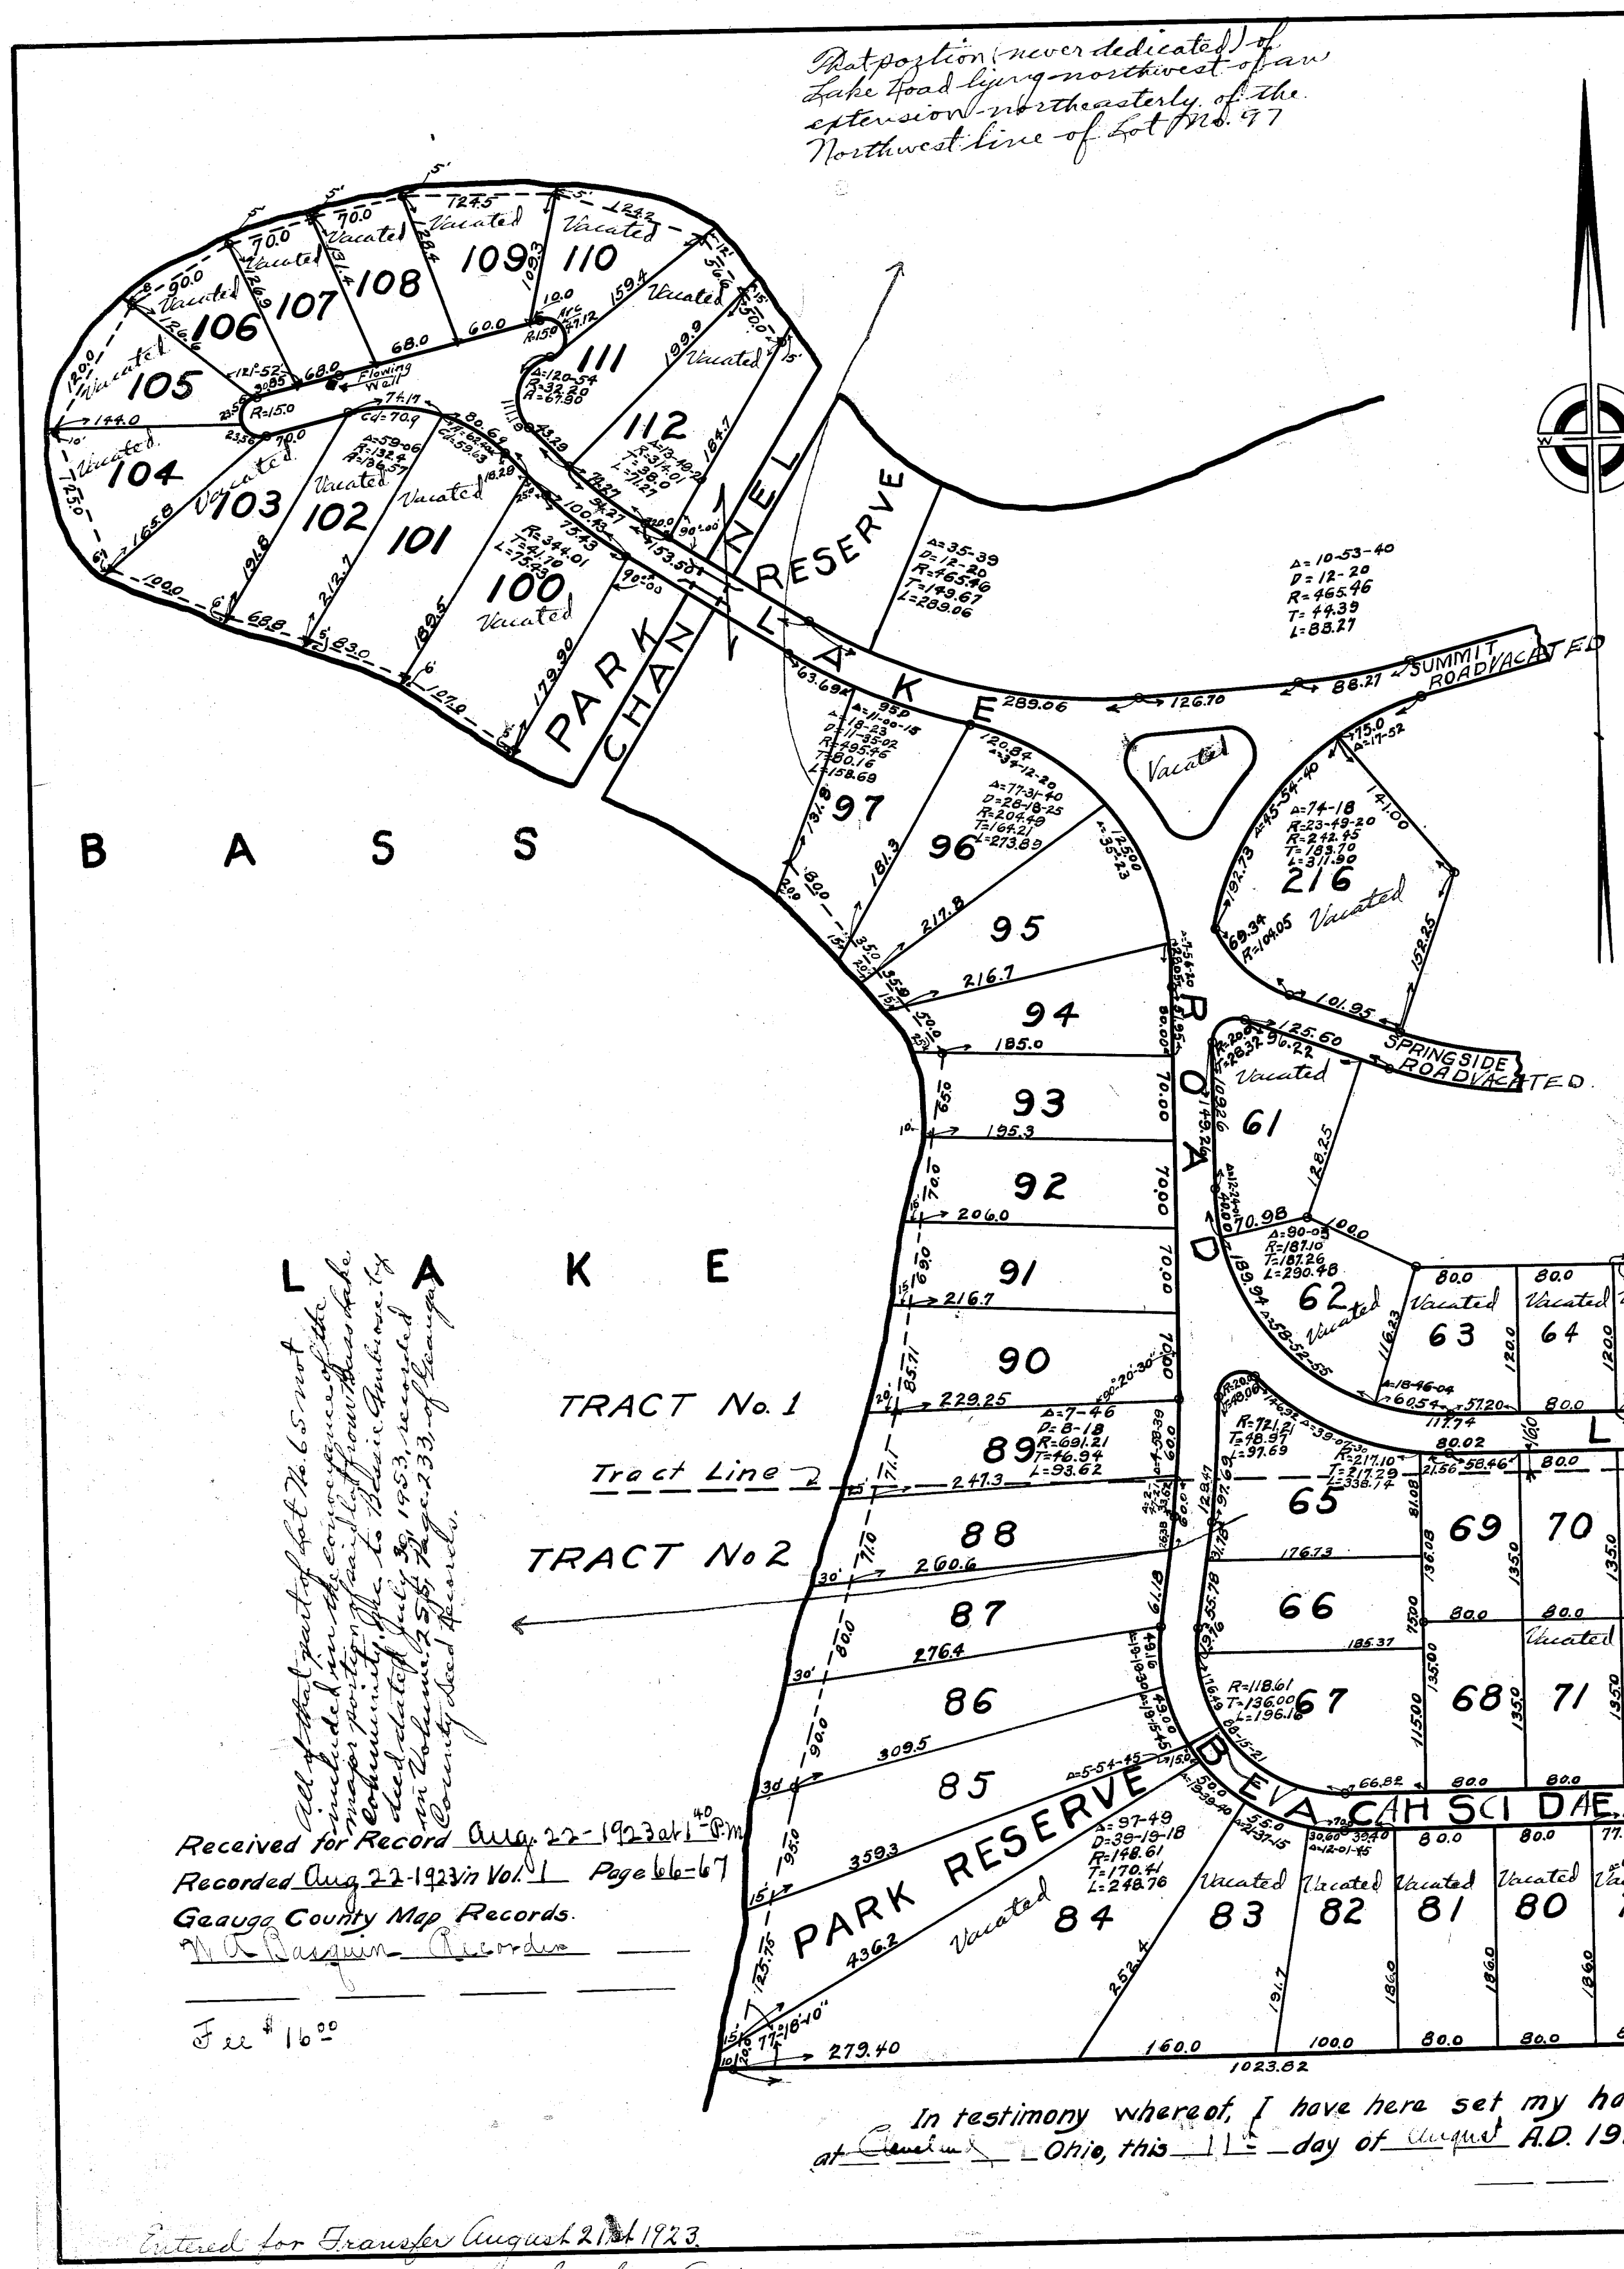

We the undersigned, owners of all the land embraced in this
subdivision do hereby accept and adopt this plat of the same,
it having been made at our request.

THE BASS LAKE RESERVE CO.
By H. C. Johns President
By W. H. Johns Secretary

State of Ohio)
County of Cuyahoga) s.s.
Before me a Notary Public in and for said County and
State, personally appeared the above named "The Bass Lake
Reserve Co," by H. C. Johns as President and W. H. Johns as
Secretary who acknowledged that they did sign the fore-
going instrument, and that the same is the free act and deed of
said Company.

In testimony whereof, I have here set my hand and official seal.
at Cleveland, Ohio, this 11 day of August A.D. 1923
W. H. Johns
Notary Public

Received for Record Aug. 22-1923 at 1:57 PM
Recorded Aug. 22-1923 in Vol. 1 Page 66-67
Gauga County Map Records
W. H. Johns - Recorder

Fee \$ 16.00

Entered for Transfer August 21st 1923