RINDLEWOOD

SUBDIVISION

4933 📜

SITUATED IN THE TOWNSHIP OF RUSSELL, COUNTY OF GEAUGA, AND STATE OF OHIO, AND KNOWN AS BEING PART OF ORIGINAL RUSSELL TOWNSHIP LOT 3, TRACT TWO IN WEST DIVISION AND PART OF LOT 6, SECTION II, TRACT ONE, BEING PART OF BLOCKS "J" AND "R" IN PAUL R. JOHNSTON'S HILLBROOK ESTATES SUBDIVISION NO. 1 AS SHOWN BY THE RECORDED PLAT IN VOL. 8 OF MAPS, PG. 93 OF GEAUGA COUNTY RECORDS AND CONTAINING 48.125 ACRES OF LAND BEING ALL OF THE LAND CONVEYED TO THE PAUL R. JOHNSTON TRUST, RECORDED IN VOL. 905, PG.744 OF GEAUGA COUNTY DEED RECORDS.

WE DO HEREBY CERTIFY THAT WE HAVE SURVEYED THE PREMISES AND PREPARED THE ATTACHED PLAT IN ACCORDANCE WITH THE PROVISIONS OF CHAPTER 4733.37 OF THE OHIO ADMINISTRATIVE CODE AND THE DIMENSIONS OF THE LOTS AND ROAD ARE IN FEET AND DECIMAL PARTS THEREOF, ALL OF WHICH ARE CORRECT TO THE BEST OF MY KNOWLEDGE AND BELIEF. IRON MONUMENTS OR PINS AS INDICATED HEREON SHALL BE SET IN PLACE BEFORE FINAL INSPECTION AND ACCEPTANCE BY THE GEAUGA COUNTY ENGINEER.

PROFESSIONAL SURVEYOR NO. 4933


BRAUN-PRENOSIL ASSOCIATES INC.

| ACCEPTANCE AND CERTIFICATION: | UTILITY EASEMENT |
|--|--|
| THE UNDERSIGNED OWNER, PAUL R. JOHNSTON TRUST, OF THE LAND SHOWN HEREIN, HEREBY CERTIFY THAT THIS PLAT CORRECTLY REPRESENTS ITS RINDLEWOOD SUBDIV A SUBDIVISION CONTAINING SUBLOTS 1 THROUGH 7 BOTH INCLUSIVE, AND DO HEREBY ACCEPT THIS PLAT OF SAME, THE RINDLEWOOD HOMEOWNERS ASSOCIATION; A NO CORPORATION HAS BEEN FORMED UNDER THE LAWS OF THE STATE OF OHIO AND SHALL BE SOLELY RESPONSIBLE FOR THE AREA DESIGNATED AS RINDLEWOOD LANE. W ACKNOWLEDGE AND THE GRANTEES SHALL ACKNOWLEDGE IN THEIR RESPECTIVE DEEDS THAT THEY UNDERSTAND THAT THE PREMISES DESCRIBED HEREIN IS LOCATED UPON NON-DEDICATED (PRIVATE) RIGHT-OF-WAY. WE HEREBY ACKNOWLEDGE AND THE GRANTEES SHALL FURTHER ACKNOWLEDGE THAT THEY UNDERSTAND THAT NO GOVERNME IS RESPONSIBLE FOR CARE AND MAINTENANCE OF SAID RIGHT-OF-WAY. THE UNDERSIGNED FURTHER AGREE THAT ANY USE OF IMPROVEMENTS MADE ON THIS LAND BE ACCORDANCE WITH ALL EXISTING VALID ZONING, PLATTING, HEALTH OR OTHER LAWFUL RULES AND REGULATIONS FOR THE BENEFIT OF THEMSELVES, AND ALL OTHER SUBSOWNERS OR ASSIGNS TAKING TITLE FROM, UNDER, OR THROUGH THE UNDERSIGNED. EASEMENTS ARE RESERVED WHERRE INDICATED ON THE PLAT FOR PUBLIC UTILITY PABOVE AND BENEATH THE SURFACE OF THE GROUND. IN WITNESS WHEREOF, THE UNDERSIGNED HEREUNTO SET THEIR HANDS THIS AND OF THE DAY OF THE DA | IN PROFIT VE HEREBY N A INTAL BODY MADE IN SEQUENT PURPOSES WELFINE E KILL CLEVELAND ELECTRIC ILLUMINATIN |
| Elizabeth a Johnston Truster | Charles V. Barre EAST OHIO GAS COMPANY |
| Elizabeth A. Johnston, Trustee ELIZABETH A. JOHNSTON, TRUSTEE WITNESS Earl W. Schreiner | APPROVALS: |
| mary & Schreiner Trustee MARY J. SCHREINER, TRUSTEE WITNESS WITNESS | THIS PLAT COMPLIES WITH THE A |
| Melody E. Zemkeherry | PURSUANT TO SECTION 711.091 I HAVE CHECKED THE PRESENCE, FACILITIES HAVE BEEN CONSTRUC |

| MY COMMISSION EXPIRES 10/24/94 NOTARY PUBLIC NOTARY PUBLIC | APPROVED THIS 9 DAY OF |
| UTILITY EASEMENT: | GEALICA COLINTY COMMISSIONER |
| PAUL R. JOHNSTON, TRUST THE UNDERSIGNED OWNER OF THE LAND DO HEREBY GRANT UNTO THE CLEVELAND ELECTRIC ILLUMINATING COMPANY. THE WESTERN RESERVE COMPANY, CABLEVISION OF GEAUGA COUNTY, AND THE EAST OHIO GAS COMPANY, ALL OHIO CORPORATIONS, THEIR SUCCESSORS AND ASSIGNS (HEREINAFTER REFERRED TO GRANTEES) A PERMANENT RIGHT—OF—WAY AND EASEMENT TEN (10) FEET IN WIDTH UNDER, OVER, AND THROUGH ALL SUBLOTS AND PARALLEL AND CONTIGUOUS TO ROAD LINES TO CONSTRUCT, PLACE, OPERATE, MAINTAIN, REPAIR, RECONSTRUCT, OR RELOCATE SUCH UNDERGROUND ELECTRIC, GAS, AND COMMUNICATION CABLES, DUCTS, CONDUITS, PIPES, GAS PIPE LINES, SURFACE OR BELOW SURFACE MOUNTED TRANSFORMERS AND PEDESTALS, CONCRETE PADS AND OTHER AS ARE DEEMED NECESSARY OR CONVENIENT BY THE GRANTEES FOR DISTRIBUTING, TRANSPORTING AND TRANSMITTING ELECTRICITY, GAS AND COMMUNICATION SIGNALS, FOR AND PRIVATE USE AT SUCH LOCATIONS AS THE GRANTEES MAY DETERMINE UPON, WITHIN, AND ACROSS THE EASEMENT PREMISES. SAID EASEMENT RIGHTS SHALL INCLUDE WITHOUT LLABILITY THEREFOR TO REMOVE TREES AND LANDSCAPING INCLUDING LAWNS WITHIN SAID EASEMENT PREMISES WHICH MAY INTERFERE WITH THE INSTALLATION, M. REPAIR OR OPERATION OF SAID ELECTRIC, GAS, AND COMMUNICATION FACILITIES. THE RIGHT TO INSTALL, REPAIR AUGMENT AND MAINTAIN SERVICE CABLES AND PIPE LINE THE ABOVE DESCRIBED EASEMENT PREMISES AND WITH THE RIGHT OF ACCESS, INGRESS AND EGRESS TO AND FROM ANY OF THE WITHIN DESCRIBED PREMISES FOR EXER OF THE PURPOSES OF THIS RIGHT—OF—WAY AND EASEMENT GRANT. ALL SUBLOTS AND ALL LANDS SHALL BE RESTRICTED TO UNDERGROUND UTILITY SERVICE. IN WITNESS THE UNDERSIGNED SET THEIR HANDS THIS | TRANSFERRED THIS DAY ER FACILITIES OR PUBLIC OE THE RIGHT AINTENANCE, ES OUTSIDE RCISING ANY |
| PAUL R. JOHNSTON TRUST | RECORDED THIS DAY O |
| Elizabeth a. Johnston, Tructee ELIZABETH A. JOHNSTON, TRUSTEE Easl W. Schreiner | APPROVED AS TO LEGAL FOR |
| mary 9. Schreinir, Trustee Drave S. Frie | COVENANTS AND RESTRICTIONS R |
| MARY J. SCHREINER, TRUSTEE WITNESS MITNESS MITNESS | SITE DATA: 47.147 TOTAL AREA O |
| STATE OF OHIO COUNTY OF GEAUGA SS BEFORE ME A NOTARY PUBLIC IN AND FOR SAID COUNTY AND STATE PERSONALLY APPEARED THE ABOVE PAUL R. JOHNSTON TRUST B JOHNSTON, TRUSTEE AND MARY J. SCHRIENER, TRUSTEE, WHO ACKNOWLEDGED THAT THEY DID SIGN THE FOREGOING INSTRUMENT, AND IS THE FREE ACT AND DEED OF SAID TRUST AND THE FREE ACT AND DEED OF EACH OF THEM PERSONALLY AS TRUSTEES, IN WITNESS WHEREOF I HAVE HEREUNTO SET- OFFICIAL SEAL AT BANBRIDGE TWO, OHIO THIS DAY OF JUNE 7, 1992. | 0.978 ACRES RESERVO.035 ACRES EXISTING THAT THE SAME 1654 LINEAL FEET O |

10/24/94

MY COMMISSION EXPIRES

| | | The state of the s |
|--|--|--|
| UTILITY EASEMENT ACCEPTED BY: | | |
| CLEVELAND ELECTRIC ILLUMINATING COMPANY DATE | WESTERN RESERVE TELEPHONE COMPANY | DATE |
| | WESTERN YESERVE TEEET TOPIC GOMM ANY | |
| Charles Barret 7/27/92 EAST OHIO GAS COMPANY DATE | CABLEVISION OF GEAUGA COUNTY | 7 - 30 -93 DATE |
| | | |
| APPROVALS: | | |
| THIS PLAT COMPLIES WITH THE APPLICABLE RUSSELL TOWNSHIP ZONING RESOLUTION | ON REGARDING LOT SIZE FRONTAGE AND WIDTH. THIS COLD DAY | OF . Jule 1992 |
| BY: William Phras | THE WILL THE | , 1892. |
| RUSSELL TOWNSHIP ZONING INSPECTOR | | |
| PURSUANT TO SECTION 711.091 OF THE OHIO REVISED CODE, I HAVE CHECKED TO I HAVE CHECKED THE PRESENCE, IN PLACE AS REQUIRED, OF ALL IRON PROPERTY FACILITIES HAVE BEEN CONSTRUCTED, ARE IN ACCORDANCE WITH THE APPROVED PLACE OF DAY OF December 1993. | HE SPECIFICATIONS, CONSTRUCTION AND THE CONDITION OF THE I Y MONUMENTS AND BENCHMARKS AND DO HEREBY CERTIFY THAT LAT AND PLANS ARE IN GOOD REPAIR, AND ALL BONDING REQUIR | PRIVATE ROAD SHOWN HEREIN, AND ALL OF THE IMPROVEMENTS AND EMENTS HAVE BEEN MET, THIS |
| | $\mathcal{O}_1 + 1 \mathcal{O}_2$ | |
| | GEAUGA COUNTY ENGINEER | |
| APPROVED THIS 9 DAY OF Deante. 1993. | | |
| | | |
| Mit Holetto Tour | 2 July 1 | my Reel |
| GEAUGA COUNTY COMMISSIONER GEAUGA COUNTY | | COUNTY COMMISSIONER |
| | | |
| TRANSFERRED THIS DAY OF December_ 1993. | Perhas D. Makowek GEAUGA COUNTY/AUDITOR | i go |
| TRANSFERRED THIS | GEAUGA COUNTY/AUDITOR | Li Jud |
| FILED FOR RECORD THIS 9 DAY OF DEC. 1993 AT 10 34.M. | | Leiden) |
| FILED FOR RECORD THIS 9 DAY OF DEC., 1993 AT 10 4.M. RECORDED THIS 9 DAY OF DEC., 1993, IN PLAT BOOK VOLU | ME 21, PAGE 94. Catherine XI GEAUGA COUNTY RE | Leiden) |




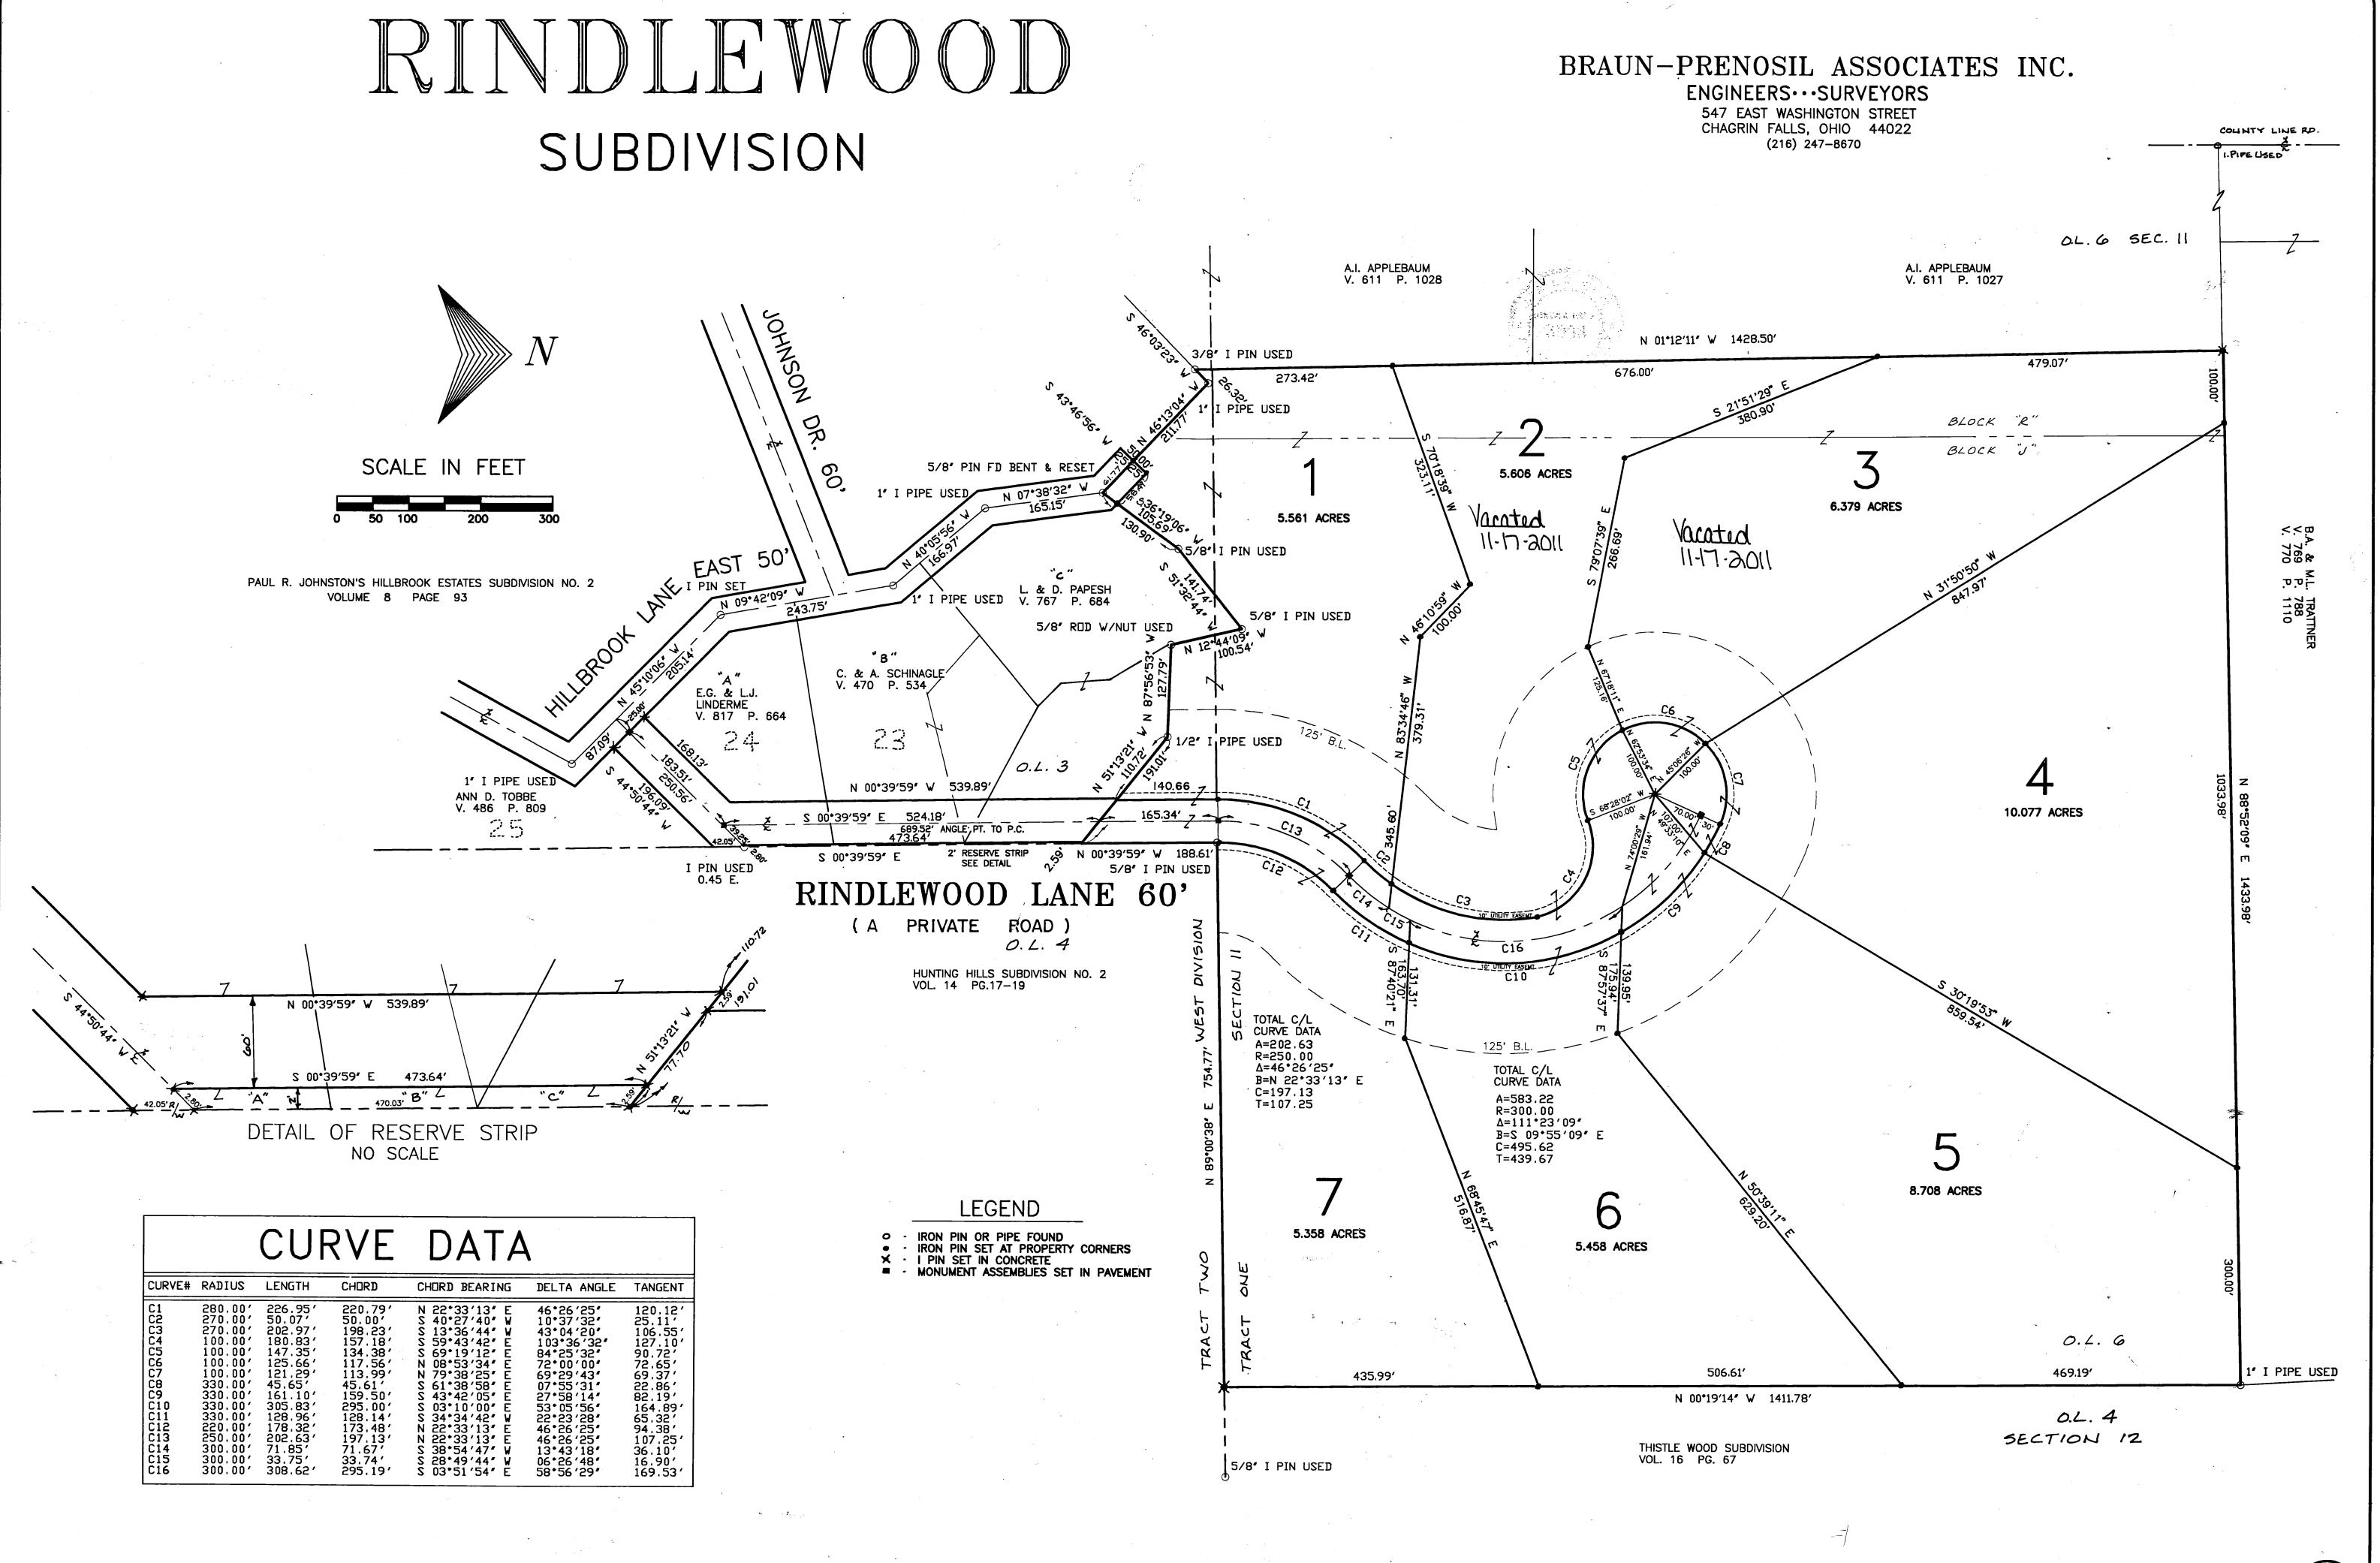

2/-95(2)