


MAPLE HOLLOW

COUNTRY CLUB

PLAT No 3

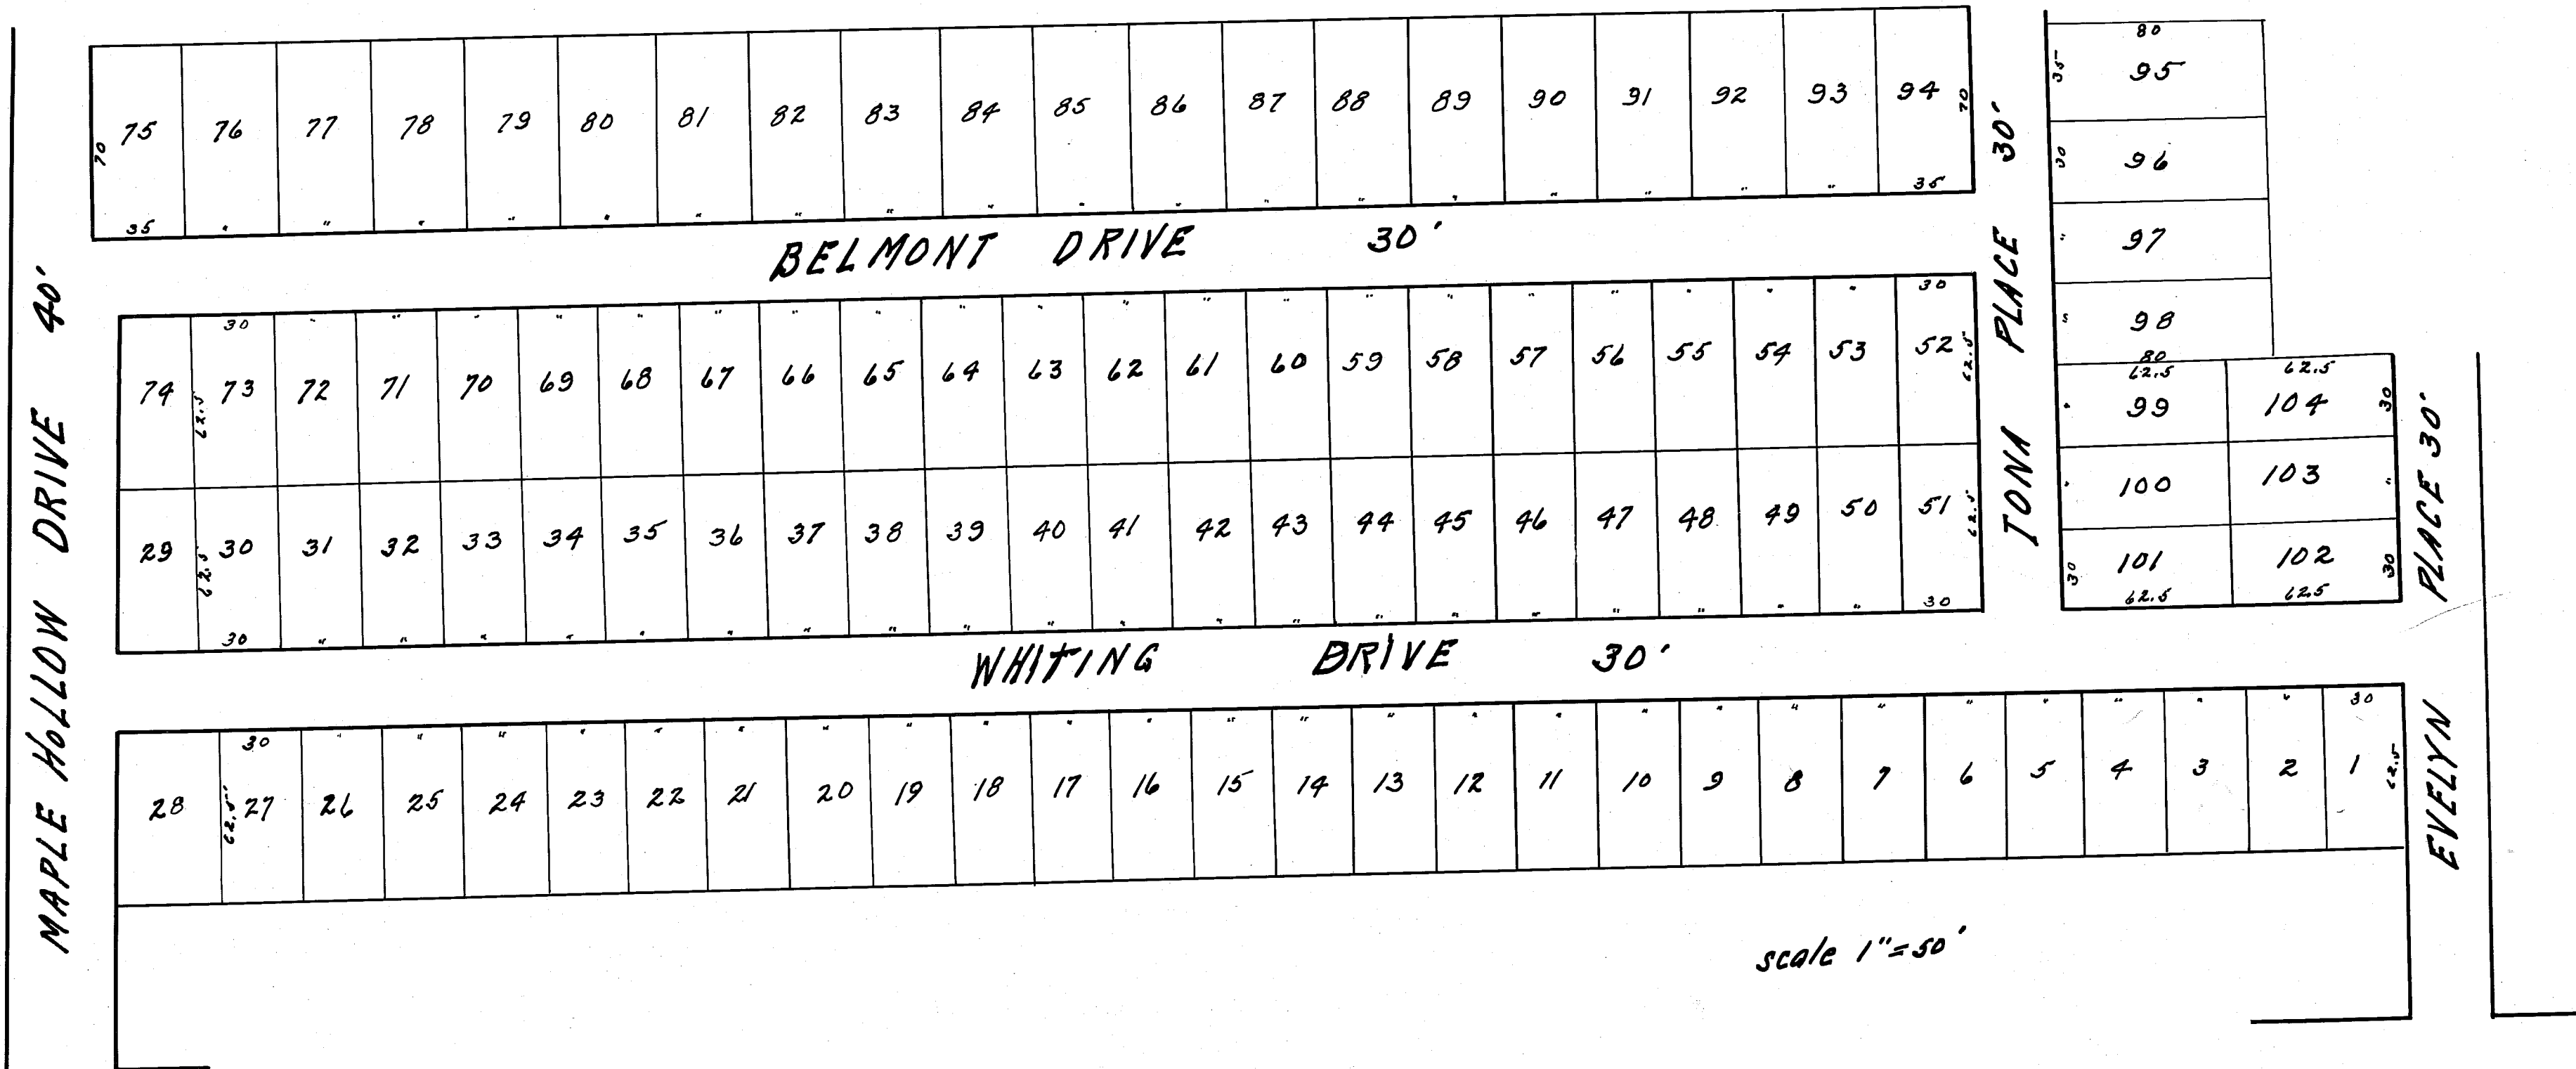

The above map shows a plot of Lots in Lot No 4 Sec 17 of Parkman Township Geauga County State of Ohio.
Owned by The Maple Hollow Holding Co Area Platted

I hereby certify the above map to be correct H. B. Matson Surveyor

The Maple Hollow Holding Co. a corporation by its President and its Secretary hereby certify that they did cause said land to be laid out as shown above.

Witnesses Signed this 12th day of July 1931
Wm. C. Fingers Pres
Wm. Chapman Secy

Transferred July 22nd 1931
Estel A. Thrasher
Gauga County Auditor

State of Ohio) ss. Before me a notary public in and for said county personally the above signed
Maple Hollow Co. M. H. Fingers Pres and Wm Chapman Secy of The Maple Hollow Holding Co
a corporation who acknowledged signing the above certificate as being
their free act and deed.

As witness my signature this 12th day of July 1931
A. T. Witt Notary Public

Received for Record _____
Recorded in Vol _____ Page _____ Gauga County Records
_____ Gauga County Recorder

A. T. WITT
MY COMMISSION EXPIRES
MAR. 29, 1931

RECEIVED FOR RECORD
July 22 1931
1340


County Record
3 33
JUL 6 1931

P.O. Box 1134 Sta. B
Cleveland Ohio

VOL. 3 PG. 33

MAPLE HOLLOW COUNTRY CLUB

PLAT No. 3

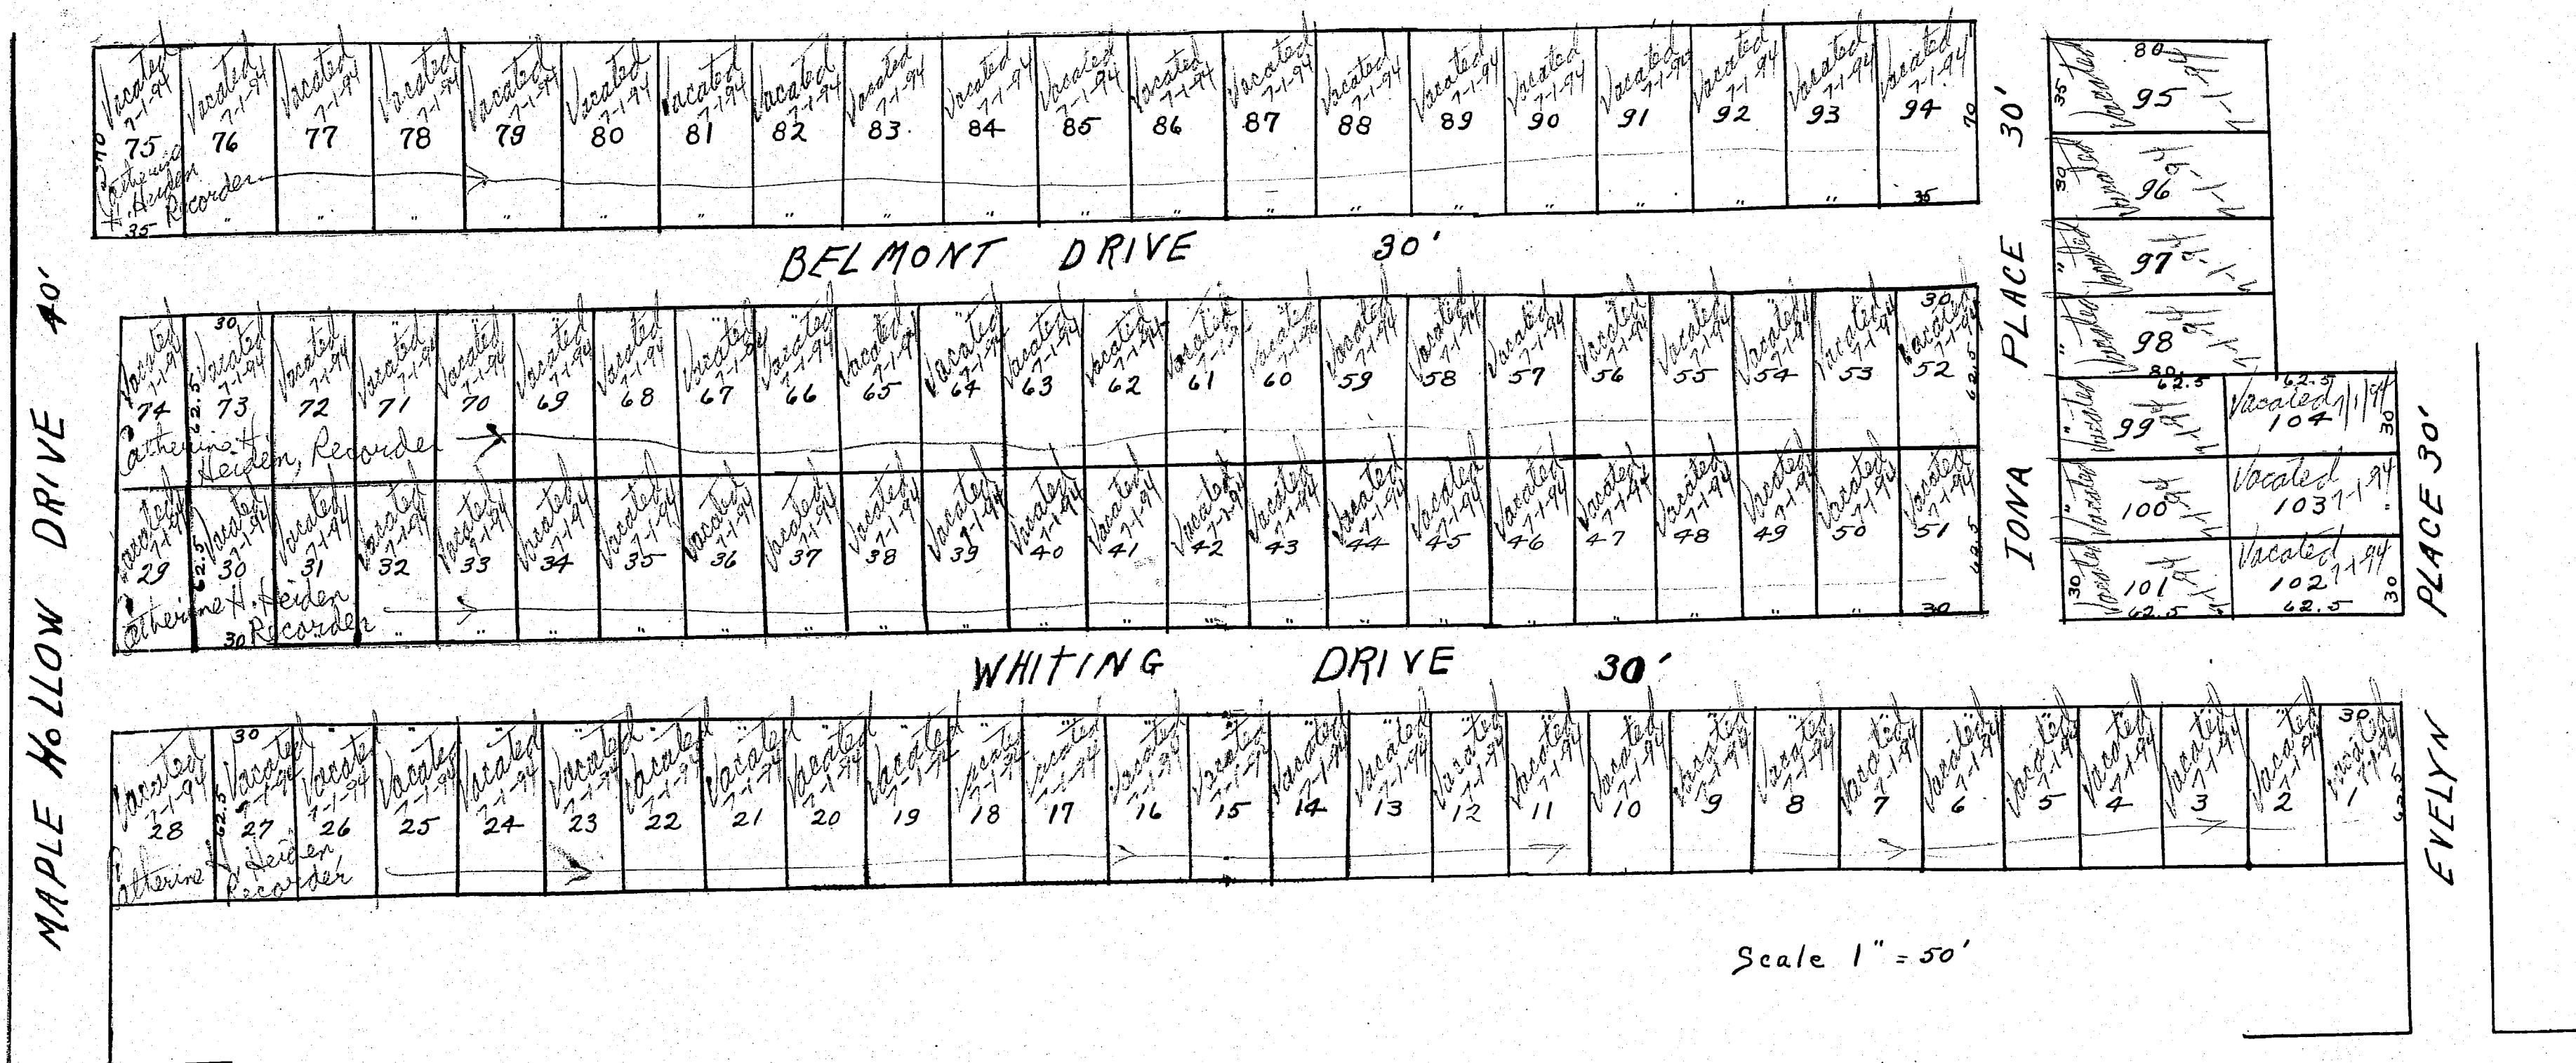

The above map shows a plat of Lots in Lot No. 4 Sec. 17 of Parkman Township, Geauga County State of Ohio
 Owned by The Maple Hollow Holding Co. Area Platted W. B. Matson Surveyor

I hereby certify the above map to be correct.
 The Maple Hollow Holding Co. a corporation by its President and its Secretary hereby certify that they did cause said land to be laid out as shown above. Transferred

Witnesses Signed this day 1929
Frederick Shell
Pauline Carney
 The Maple Hollow Holding Co.
M. A. Fanger Pres. (Seal)
Wm. Chapman Secy.

July 22nd 1931.
Edw. L. Thrasher
 Geauga County Auditor.

State of Ohio ss. Before me a notary public in and for said County personally the above signed M. A. Fanger Pres. and Wm. Chapman Secy. of The Maple Hollow Holding Co. a corporation who acknowledged signing the above certificate as being their free act and deed.

As witness my signature this day 1929
A. T. Witt Notary Public.
 A. T. Witt (Seal)
 My Commission Expires
 Mar. 29, 1931

Received for Record July 22, 1931 at 3:40 o'clock P.M.
 Recorded in Vol. 3 Page 33-34 Geauga County Records
 _____ Geauga County Recorder