


Vacated County Auditor's Certificate (Ohio Rev. Code Sec. 711.27) *H.D. Hollenbeck* Recorder  
 Lots 2 through 17 and 2 proposed roads vacated - March 11, 1964

Vacated County Auditor's Certificate (Ohio Rev. Code Sec. 711.27) *H.D. Hollenbeck* Recorder  
 Lots 2 through 17 and 2 proposed roads vacated - March 11, 1964

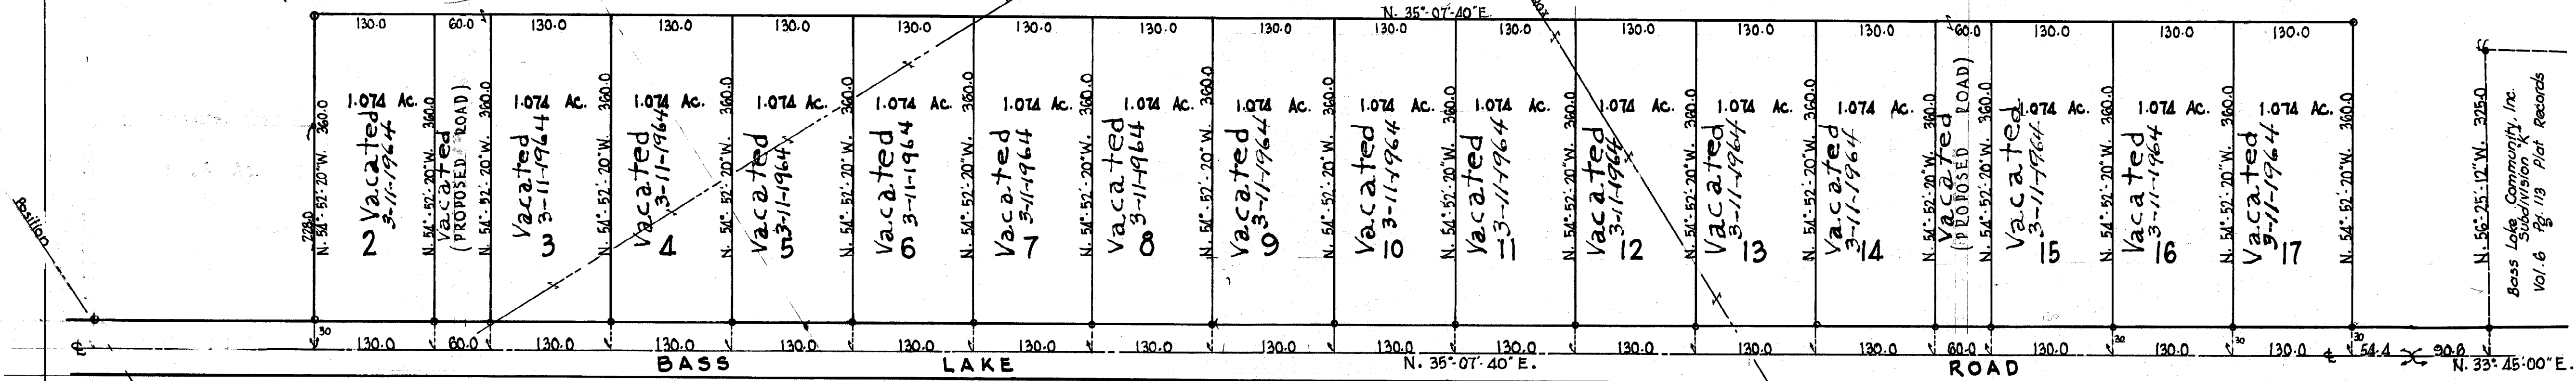

**BASS LAKE COMMUNITY, INC.**  
**SUBDIVISION "N"**

SITUATED IN ORIG. LOTS NO. 5, 9, & 6 - SEC. NO. 4 - EAST DIVISION OF TRACT NO. 1  
 MUNSON TOWNSHIP GEauga COUNTY OHIO  
 SCALE: 1 IN. = 100 FT. IRON PIPE MONUMENTS AT POINTS MARKED (C)

Vacated - 3-11-1964  
 County Auditor's Cert. *H.D. Hollenbeck* Recorder

BASS LAKE COMMUNITY, INC. a Corporation, owner of all the land within the numbered sub-lots shown hereon, claiming title through instrument recorded in volume 221, page 160, Geauga County deed records, hereby accepts and adopts this plat of the same, certifies that said plat was prepared at the order and request of said Corporation, and requests that this Plat of Subdivision be placed upon the records of Geauga County, Ohio.

In witness whereof said Corporation sets its hand and Corporate Seal by *John J. Mains* its Vice President and *R. A. Roderer* its Treasurer this 11<sup>th</sup> day of October A.D. 1955

**ZONING AUTHORITY**

*We* hereby certify that the sub-lots shown hereon are in compliance with regulations established by local Planning and Zoning Authority, as such regulations are in effect on January 1st 1955

*Frank J. Finke*  
*Richard L. Matthews*  
*J. C. ...*  
*Way E. ...*  
*P. O. Wolcott*

For Zoning Authority of Munson Township, Geauga County, O.

**COUNTY COMMISSION**

This Plat of Subdivision approved by the Board of Commissioners of Geauga County, Ohio, by resolution adopted this 6 day of Oct 1956

*Wm. C. Duran*  
*J. I. Hunt*

Board of Commissioners of Geauga County, Ohio.

**AUDITOR**

Entered for Transfer \_\_\_\_\_  
 Transferred February 6, 1956

*Wilma J. ...*  
 Auditor of Geauga County, Ohio

State of Ohio ss. Franklin County ss. Before me, a Notary Public in and for said County and State, personally appeared the above named Bass Lake Community, Inc. by John J. Mains its Vice President and R. A. Roderer its Treasurer who acknowledged that they did sign the foregoing instrument, and that the same is the free act and deed of said Corporation and the free act and deed of each of them personally and as such officers.  
 In testimony whereof I have hereunto set my hand and official seal at Columbus Ohio this 11<sup>th</sup> day of October 1955  
Donald D. ... Notary Public  
 My Commission expires April 11, 1957

**RECORDER**

Received for Record Feb. 6 1956  
 Recorded Feb. 13 1956 Vol. 7 Page 12  
 Geauga County Plat Records  
H. D. Hollenbeck  
 Recorder of Geauga County, Ohio  
 Fee: \$6.20 Pd.

I hereby certify that this plat represents a true and correct survey of the sub-lots shown hereon, all distances shown being in feet and decimals thereof.

*T.R. Root*  
 T. R. Root Registered Surveyor No. 2888 Oct. 5, 1955  
 7-12